



Fall & Associates
Stake and Elevation Service
P.O. Box 222
Pretty Prairie, KS. 67570
785-243-7506

Date 8-5-19

Invoice Number 0801191

MURFIN DRILLING

1-14

Soucie Kriss Unit

Operator

Number

Farm Name

Thomas-KS

14

10s

34w

2275'FSL 2860'FEL

County-State

S

T

R

Location

Murfin Drilling
250 N Water
Suite 300
Wichita, KS 67202

Elevation 3209 Gr.

Ordered By: Shauna

Scale 1"=1000'



Set 4' wood stake in level wheat stubble.


14

2860'

Stake

2275'



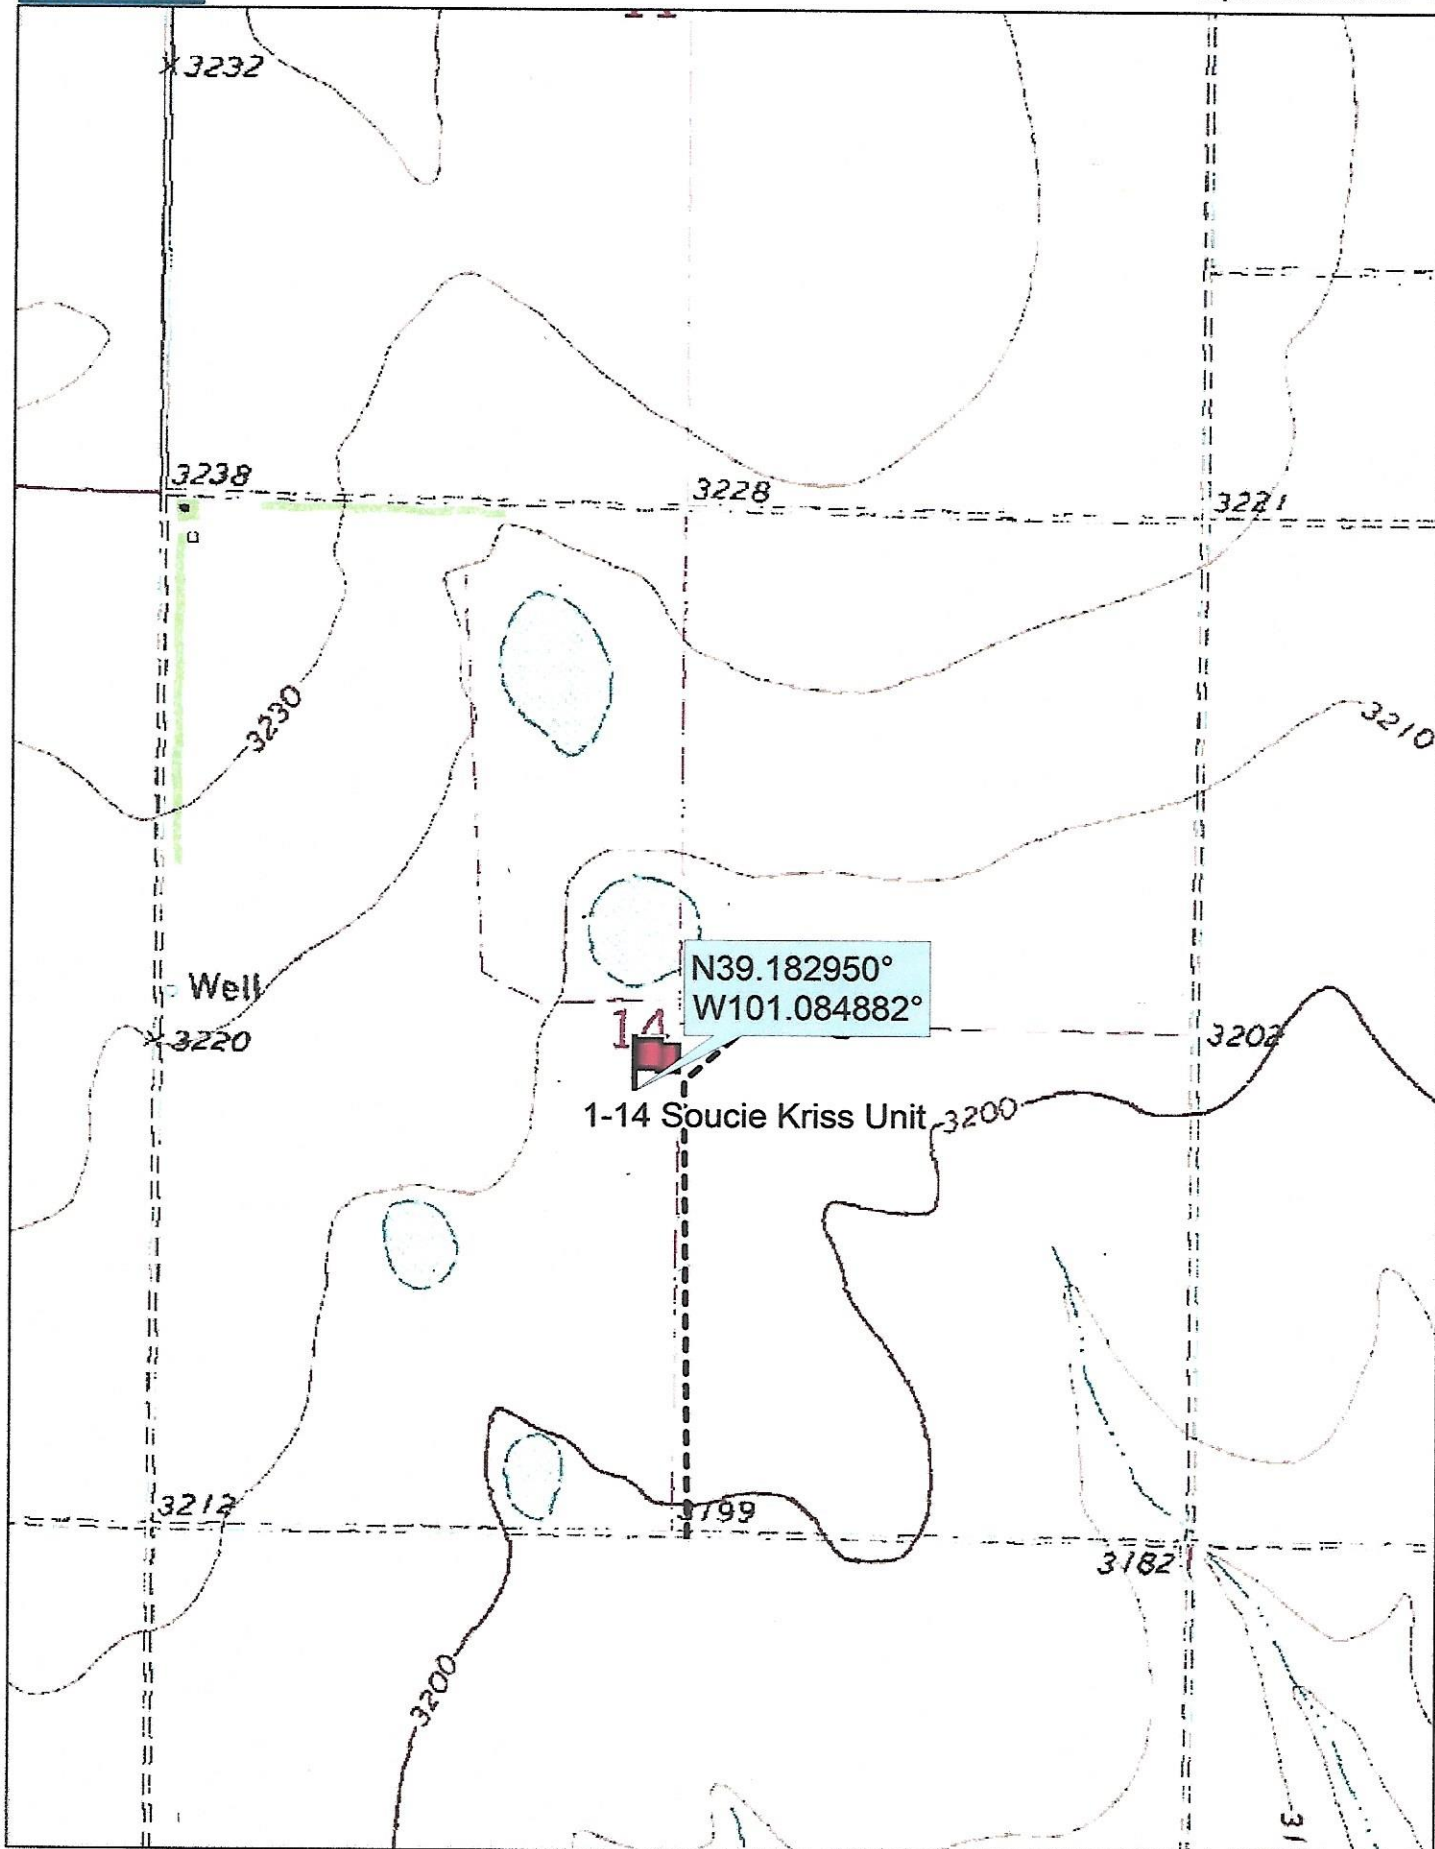


Data use subject to license

© DeLorme. Topo North America™ 9.

www.delorme.com



Scale 1 : 12,000

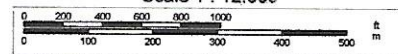

1" = 1,000.0 ft Data Zoom 13-1