

ADVANTAGE ELEVATIONS

OIL FIELD SURVEYORS

BOX 8604 - PRATT, KS 67124
(620) 672-6491

88192

INVOICE NO.

CHIEFTAIN OIL CO INC
OPERATOR

SWD
NO.

MAX ROWE
FARM

BARBER 3 32s 10w
COUNTY S T R

75' W of C NE SW
LOCATION

ELEVATION: 1519' GR



CHIEFTAIN OIL CO INC
PO BOX 124
KIOWA, KS 67070-0124


AUTHORIZED BY: Ryan Molz

SCALE: 1" = 1000'

- LEGEND**
- Well Location
 - Tank Battery Location
 - Pipeline Location
 - Electric Line Location
 - Lease Road Location

Technical services to assist
in locating old bore hole.
Set 5' T-post & 3' wood stake
@ point of highest meter reading.
Level to slight slope pasture.
Ryan Molz present.

GPS Coordinates: 37.28805
 -98.39716
 NAD83

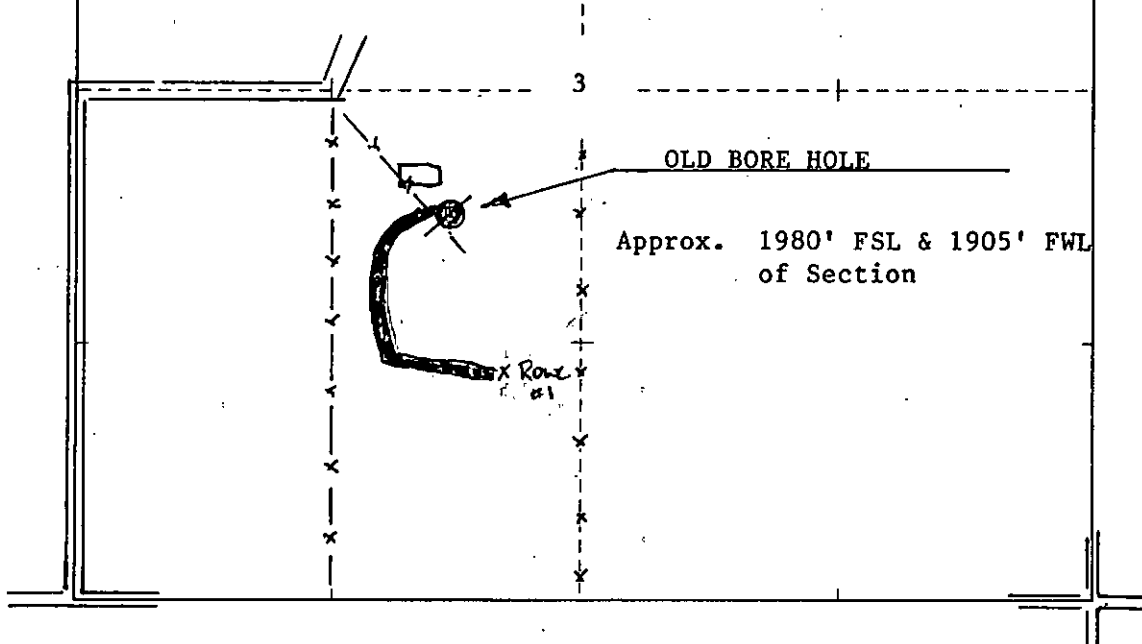

DATE STAKED: 8/7/19