Darling Drilling Company

Telephone (620) 662-7901 3916 W. 56th Ave.
Hutchinson, Ks. 67501

DRILLER'S TEST LOG

Date: 7-12-2019
Name: Mesa/TransCanada
Address: Tulsa, Ok
County: Comanche Co. MP 26.4
Quarter: NE **Section:** 4 **Township:** 34S **Range:** 19W

DRILLED FOOTAGE		DESCRIPTION OF STRATA
From	To	
0	3	Top Soil
3	7	Brown Clay
7	9	Rock
9	25	Brown Silty Clay and Streaks of Rock
25	203	Red Shale Soft

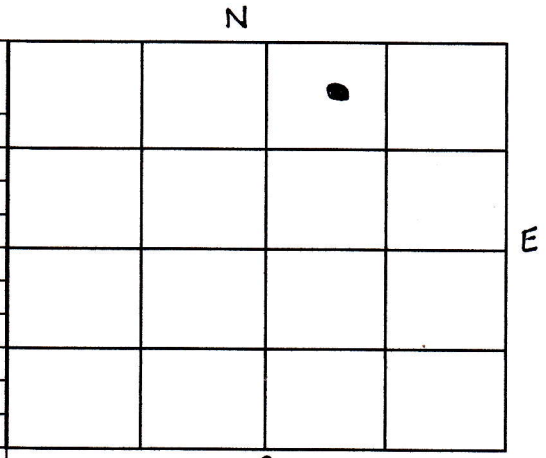

Static water level:
Depth of well: 203ft
Type & size of casing: 10" SDR21
Plain: 0 to 20ft
Perf: n/a
Gravel pack intervals: n/a
Grout material: neat cement 3-20ft
Contamination: none
Direction from well:
Casing above surface: 3ft Below
Bore hole: 17" & 9"

Latitude: 37.11921
Longitude: 099.38568