


11

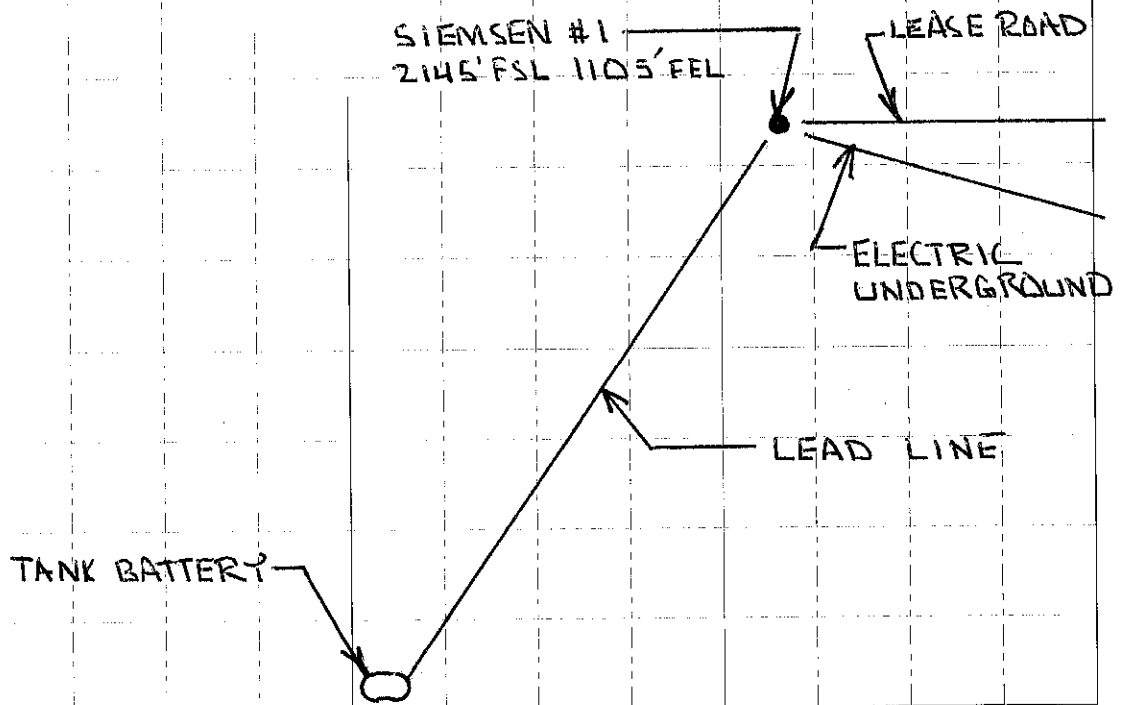

SIEMSEN #1 LOCATION PLAT
SE/A 11-17-11W