



OIL FIELD SURVEYORS

BOX 8604 - PRATT, KS 67124
(620) 672-6491

816192

INVOICE NO

HOWELL OIL CO. INC

OPERATOR

4

NO.

DOLE

FARM

RENO

COUNTY

13

S

23s

T

4w

R

1320' FSL & 1650' FEL of Sec.

LOCATION

ELEVATION 1467' GR



HOWELL OIL CO. INC
2400 Riverbirch Rd.
Hutchinson, KS 67502-9280

AUTHORIZED BY Steve Howell

SCALE: 1" = 100'


Set 5' T-post & 3' wood stake.

Slight slope grassland.

GPS Coordinates: 38.04671

-97.70773

NAD83

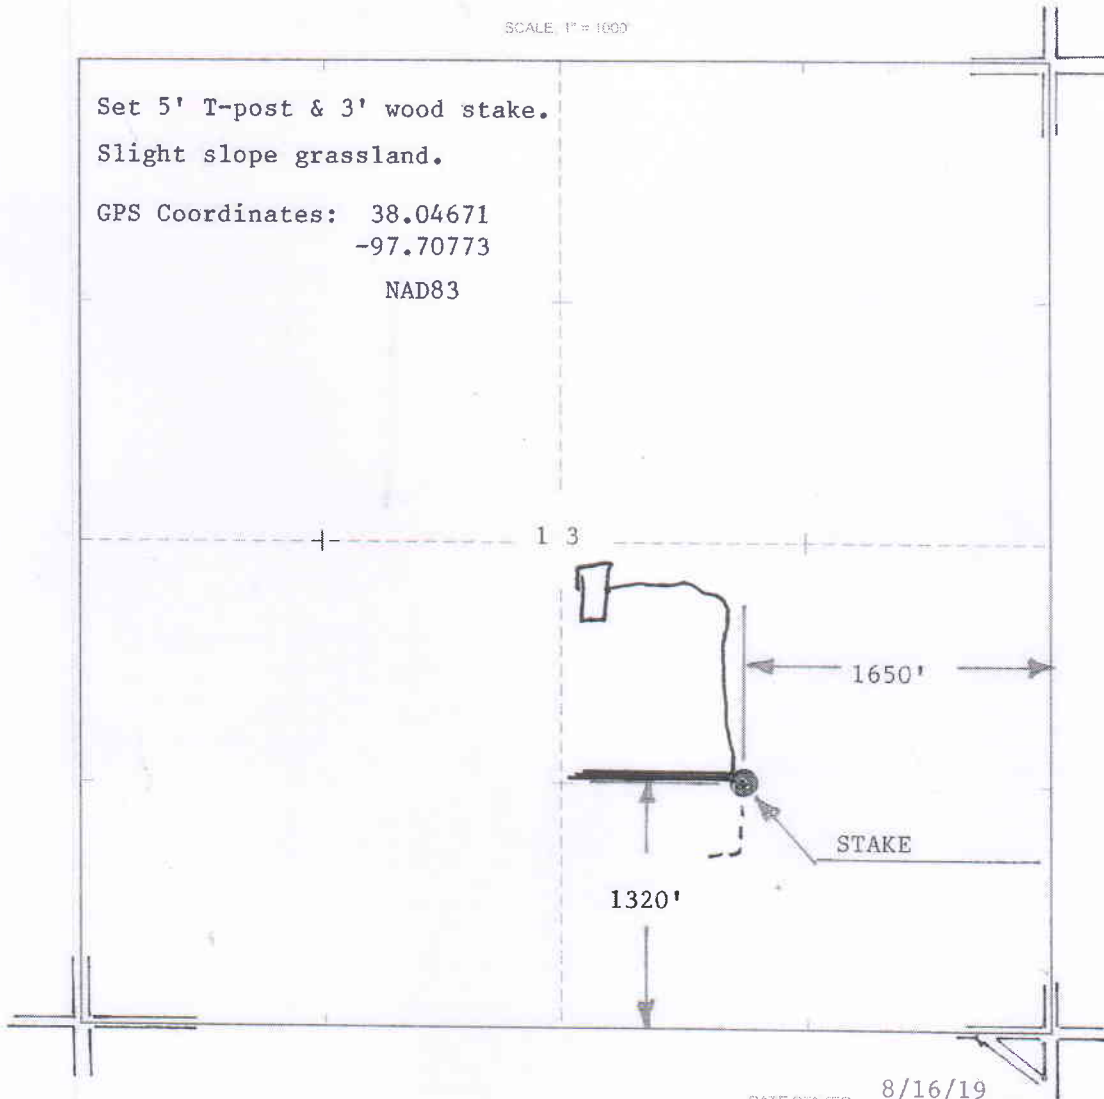

DATE STAKED: 8/16/19