

ADVANTAGE ELEVATIONS

OIL FIELD SURVEYORS

BOX 8604 - PRATT, KS 67124
(620) 672-6491

823191

INVOICE NO.

VAL ENERGY INC.

OPERATOR

1-29

NO.

McKAY

FARM

BARBER

COUNTY

29

S

30s

T

12w

R

2310' FNL & 2060' FEL of Sec.

LOCATION


ELEVATION: 1739' GR



VAL ENERGY INC
125 N Market, Ste 1110
Wichita, KS 67202

AUTHORIZED BY: Todd Allam

SCALE: 1" = 1000'

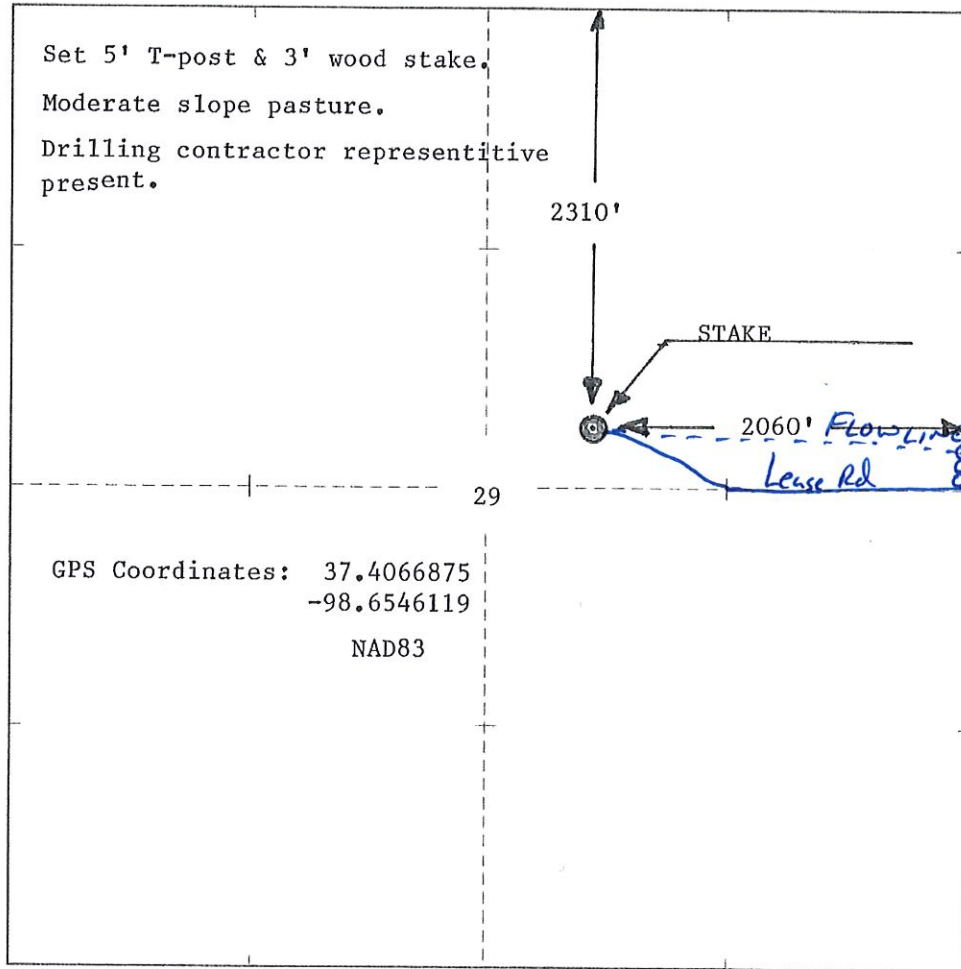

DATE STAKED: 8/23/19