



Fall & Associates

Stake and Elevation Service

P.O. Box 222

Pretty Prairie, KS. 67570

785-243-7506

Date 8-8-19

Invoice Number 0806191

JO-ALLYN OIL CO., INC.

KRAMER #2

Kramer

Operator

Number

Farm Name

Rooks-KS

27

8s

18w

1345'FSL 2210'FEL

County-State

S

T

R


Location


JO-ALLYN Oil Co., Inc.
Box 442
Laverne, OK. 73848

Elevation 1999Gr.

Ordered By: Jerry

Scale 1"=1000'

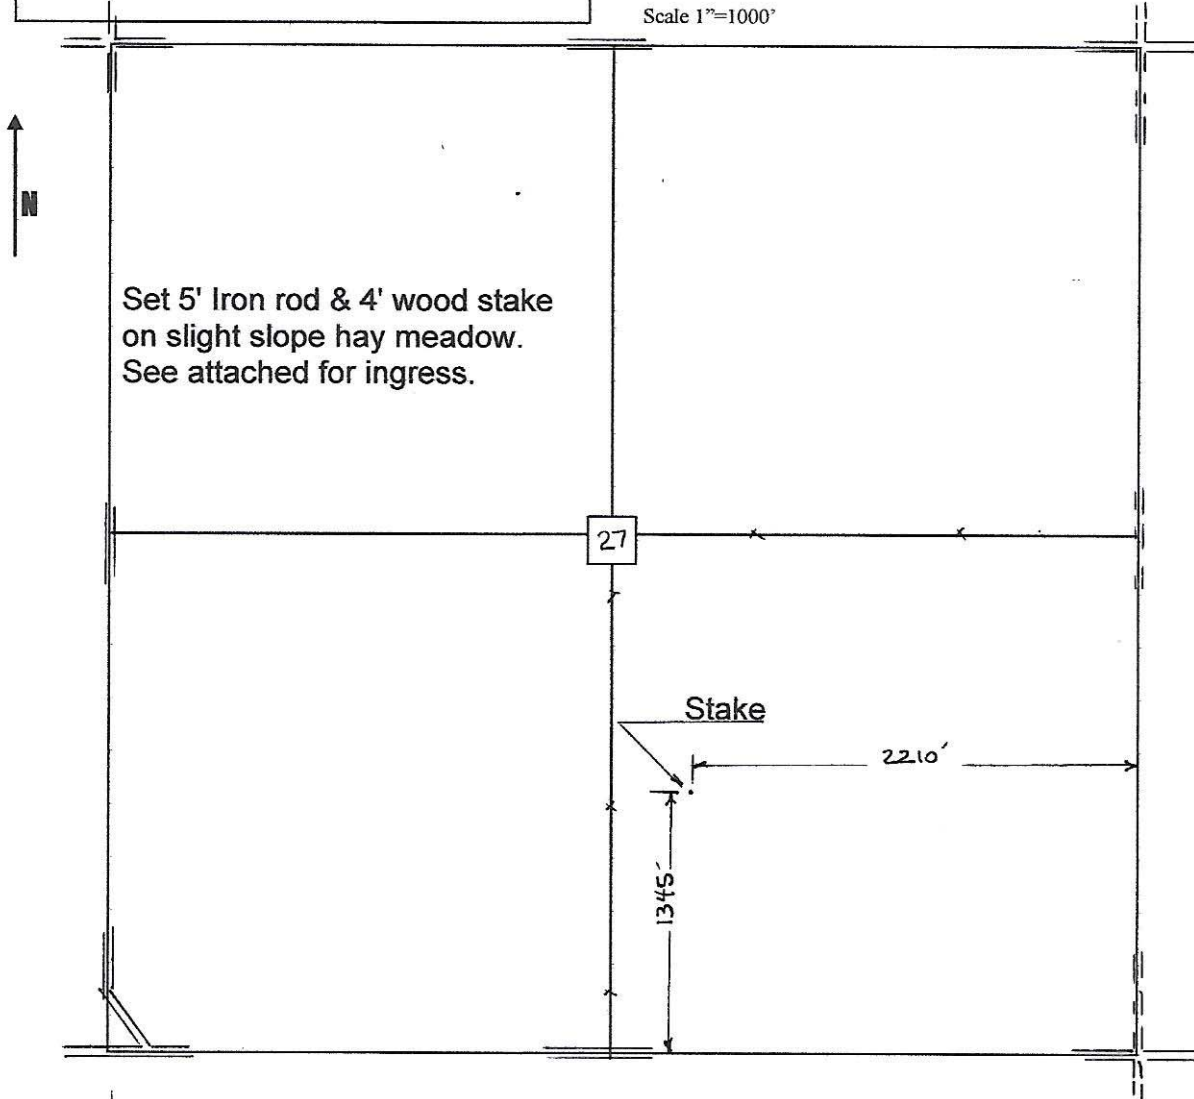

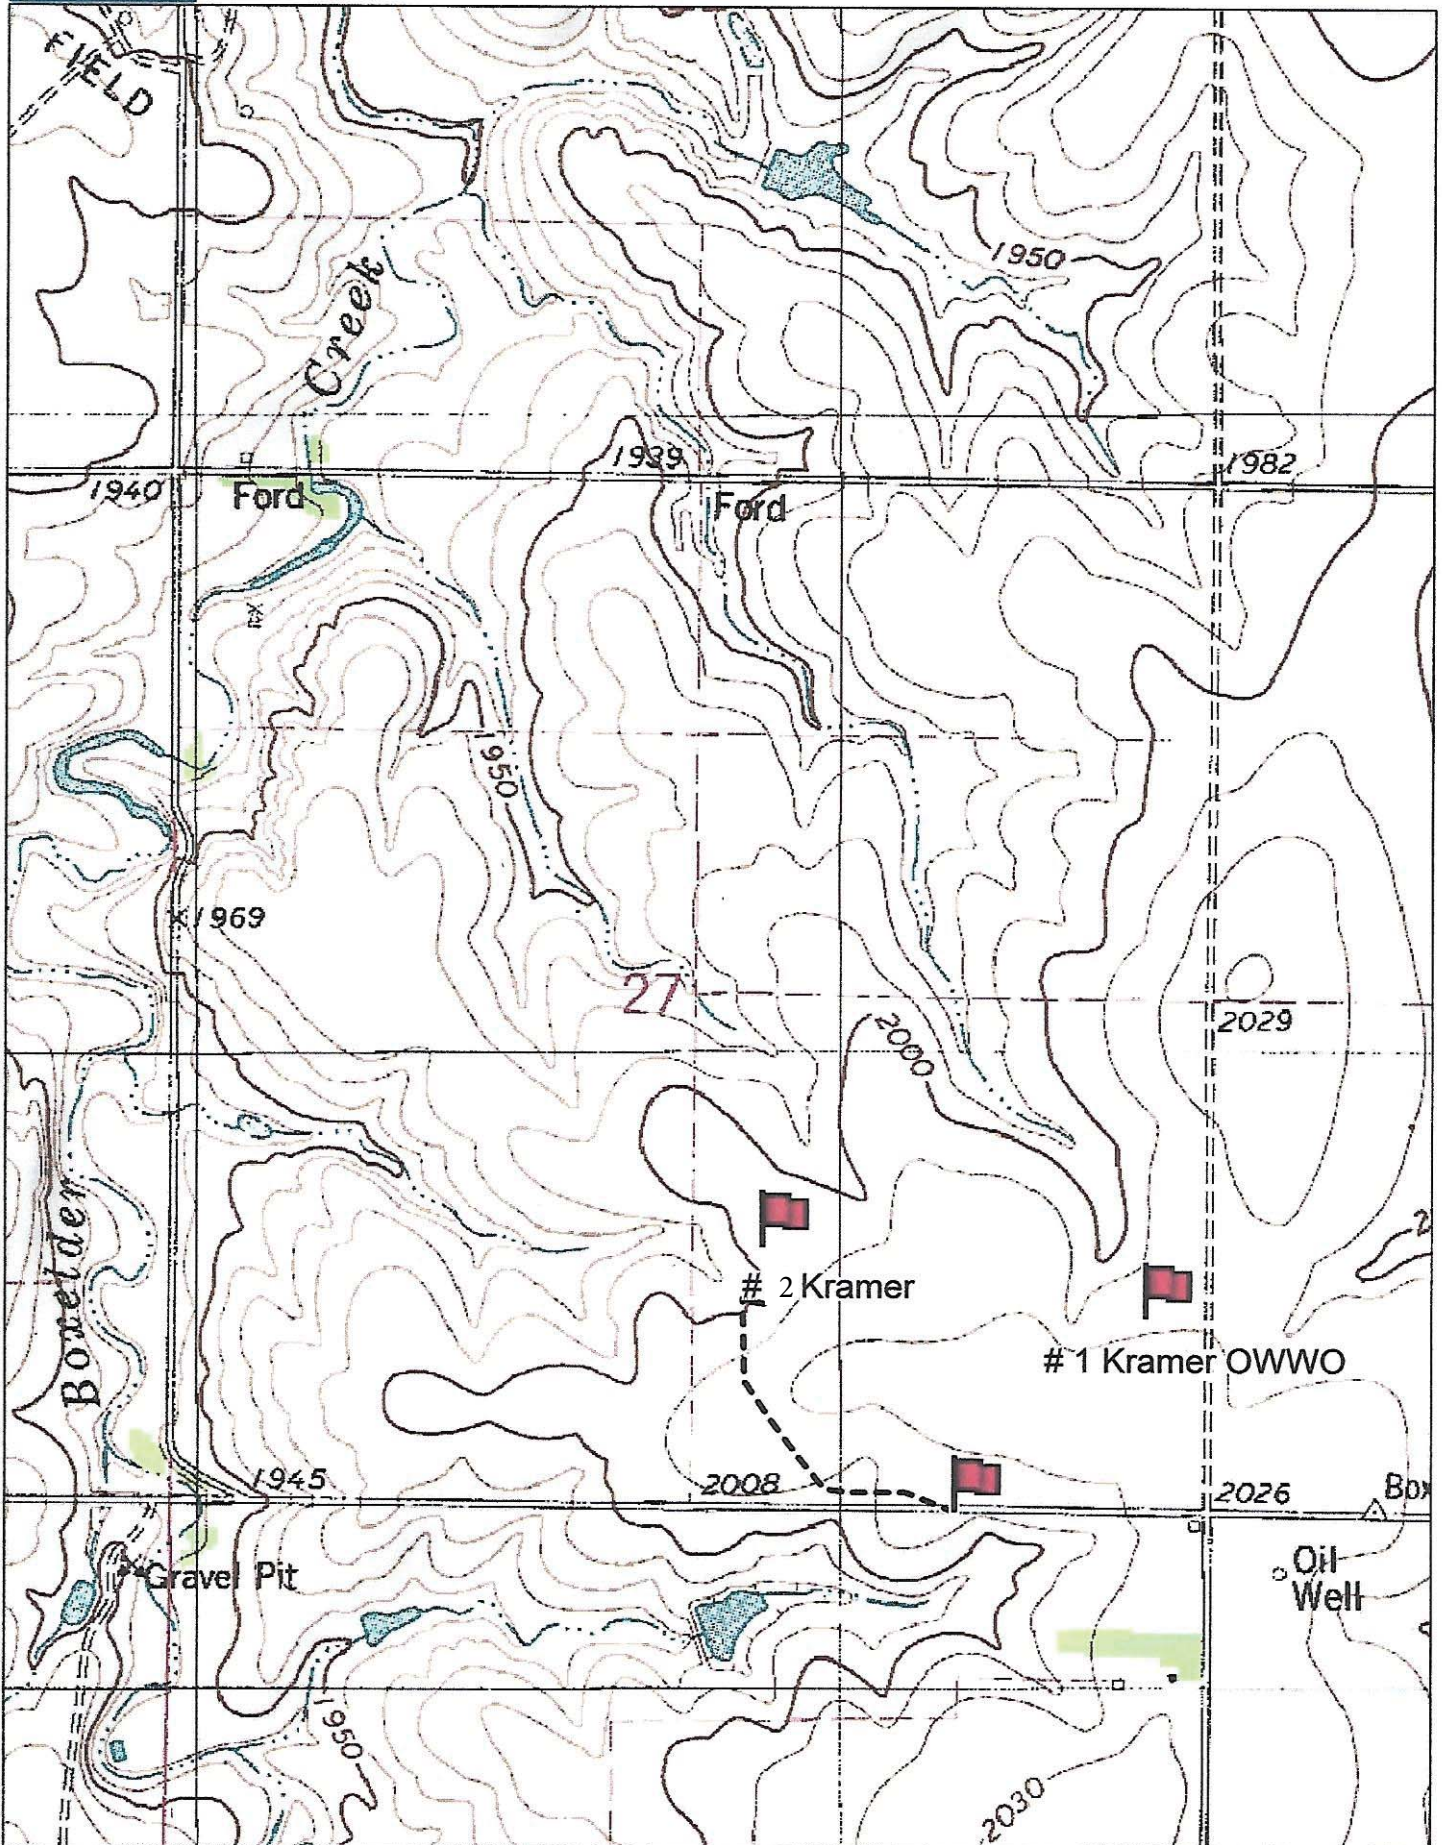

Data use subject to license.

© DeLorme. Topo North America™ 9.

www.delorme.com

