


[Empty rectangular box]

Township: \_\_\_\_\_ Range: \_\_\_\_\_ County: \_\_\_\_\_ State: \_\_\_\_\_

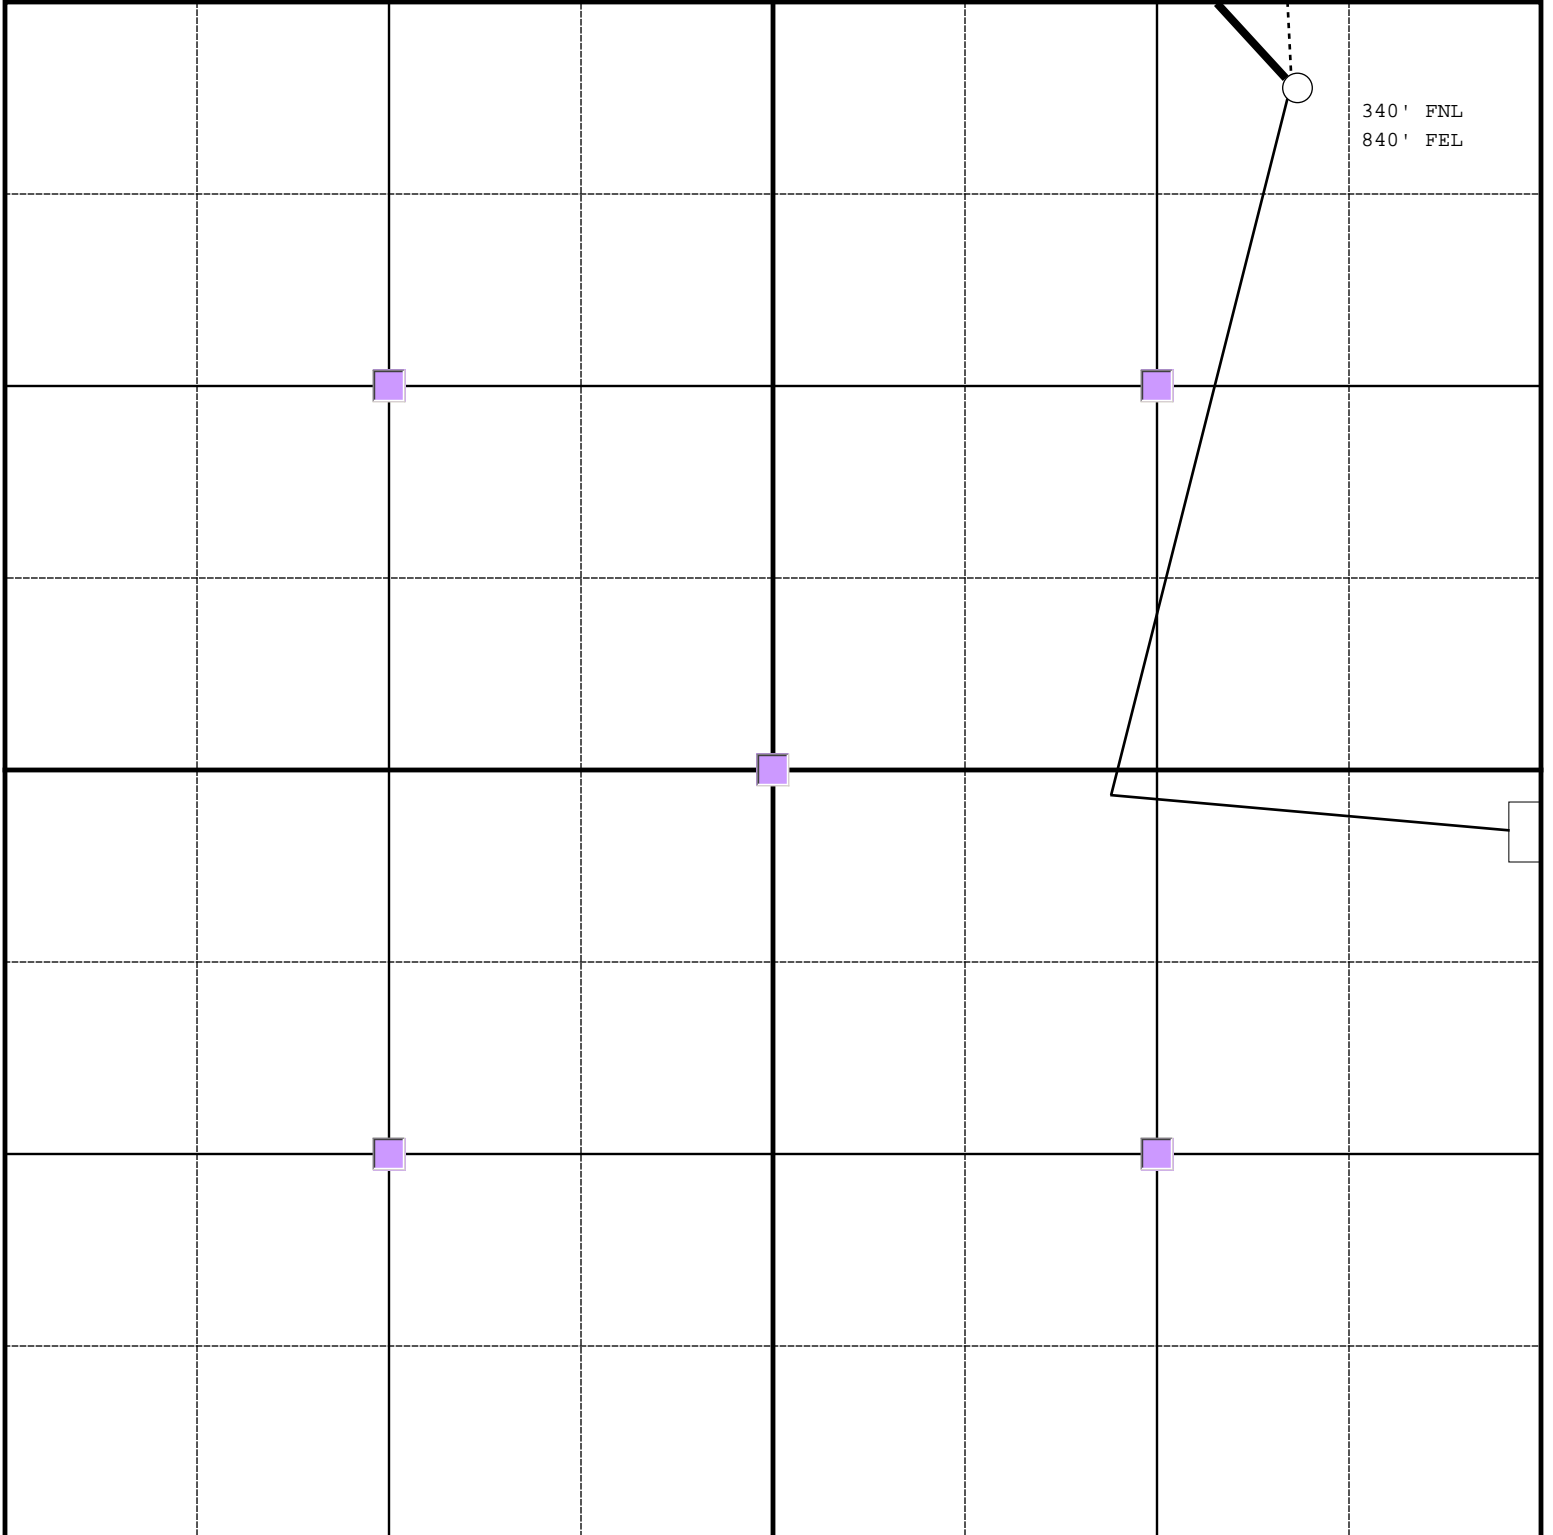

-  Tank Battery
-  Road
-  Pipeline
-  Electric Line