

KANSAS CORPORATION COMMISSION
OIL & GAS CONSERVATION DIVISION

Form CP-1
March 2010

This Form must be Typed
Form must be Signed
All blanks must be Filled

WELL PLUGGING APPLICATION

Form KSONA-1, Certification of Compliance with the Kansas Surface Owner Notification Act,
MUST be submitted with this form.

OPERATOR: License #: _____
Name: _____
Address 1: _____
Address 2: _____
City: _____ State: _____ Zip: _____ + _____
Contact Person: _____
Phone: (_____) _____

API No. 15 - _____
If pre 1967, supply original completion date: _____
Spot Description: _____
____ - ____ - ____ Sec. ____ Twp. ____ S. R. ____ East West
____ Feet from North / South Line of Section
____ Feet from East / West Line of Section
Footages Calculated from Nearest Outside Section Corner:
 NE NW SE SW
County: _____
Lease Name: _____ Well #: _____

Check One: Oil Well Gas Well OG D&A Cathodic Water Supply Well Other: _____
 SWD Permit #: _____ ENHR Permit #: _____ Gas Storage Permit #: _____

Conductor Casing Size: _____ Set at: _____ Cemented with: _____ Sacks
Surface Casing Size: _____ Set at: _____ Cemented with: _____ Sacks
Production Casing Size: _____ Set at: _____ Cemented with: _____ Sacks

List (ALL) Perforations and Bridge Plug Sets:

Elevation: _____ (G.L. / K.B.) T.D.: _____ PBTD: _____ Anhydrite Depth: _____
(Stone Corral Formation)

Condition of Well: Good Poor Junk in Hole Casing Leak at: _____
(Interval)

Proposed Method of Plugging (attach a separate page if additional space is needed):

Is Well Log attached to this application? Yes No Is ACO-1 filed? Yes No

If ACO-1 not filed, explain why:

Plugging of this Well will be done in accordance with K.S.A. 55-101 et. seq. and the Rules and Regulations of the State Corporation Commission

Company Representative authorized to supervise plugging operations: _____
Address: _____ City: _____ State: _____ Zip: _____ + _____
Phone: (_____) _____
Plugging Contractor License #: _____ Name: _____
Address 1: _____ Address 2: _____
City: _____ State: _____ Zip: _____ + _____
Phone: (_____) _____

Proposed Date of Plugging (if known): _____

Payment of the Plugging Fee (K.A.R. 82-3-118) will be guaranteed by Operator or Agent

Submitted Electronically

KANSAS CORPORATION COMMISSION
OIL & GAS CONSERVATION DIVISION

Form KSONA-1
January 2014
Form Must Be Typed
Form must be Signed
All blanks must be Filled

**CERTIFICATION OF COMPLIANCE WITH THE
KANSAS SURFACE OWNER NOTIFICATION ACT**

This form must be submitted with all Forms C-1 (Notice of Intent to Drill); CB-1 (Cathodic Protection Borehole Intent); T-1 (Request for Change of Operator Transfer of Injection or Surface Pit Permit); and CP-1 (Well Plugging Application). Any such form submitted without an accompanying Form KSONA-1 will be returned.

Select the corresponding form being filed: C-1 (Intent) CB-1 (Cathodic Protection Borehole Intent) T-1 (Transfer) CP-1 (Plugging Application)

OPERATOR: License # _____
Name: _____
Address 1: _____
Address 2: _____
City: _____ State: _____ Zip: _____ + _____
Contact Person: _____
Phone: (_____) _____ Fax: (_____) _____
Email Address: _____

Well Location:
____ - ____ - ____ - ____ Sec. ____ Twp. ____ S. R. ____ East West
County: _____
Lease Name: _____ Well #: _____

If filing a Form T-1 for multiple wells on a lease, enter the legal description of the lease below:

Surface Owner Information:

Name: _____
Address 1: _____
Address 2: _____
City: _____ State: _____ Zip: _____ + _____

When filing a Form T-1 involving multiple surface owners, attach an additional sheet listing all of the information to the left for each surface owner. Surface owner information can be found in the records of the register of deeds for the county, and in the real estate property tax records of the county treasurer.

If this form is being submitted with a Form C-1 (Intent) or CB-1 (Cathodic Protection Borehole Intent), you must supply the surface owners and the KCC with a plat showing the predicted locations of lease roads, tank batteries, pipelines, and electrical lines. The locations shown on the plat are preliminary non-binding estimates. The locations may be entered on the Form C-1 plat, Form CB-1 plat, or a separate plat may be submitted.

Select one of the following:

- I certify that, pursuant to the Kansas Surface Owner Notice Act (House Bill 2032), I have provided the following to the surface owner(s) of the land upon which the subject well is or will be located: 1) a copy of the Form C-1, Form CB-1, Form T-1, or Form CP-1 that I am filing in connection with this form; 2) if the form being filed is a Form C-1 or Form CB-1, the plat(s) required by this form; and 3) my operator name, address, phone number, fax, and email address.
- I have not provided this information to the surface owner(s). I acknowledge that, because I have not provided this information, the KCC will be required to send this information to the surface owner(s). To mitigate the additional cost of the KCC performing this task, I acknowledge that I must provide the name and address of the surface owner by filling out the top section of this form and that I am being charged a \$30.00 handling fee, payable to the KCC, which is enclosed with this form.

If choosing the second option, submit payment of the \$30.00 handling fee with this form. If the fee is not received with this form, the KSONA-1 form and the associated Form C-1, Form CB-1, Form T-1, or Form CP-1 will be returned.

I Submitted Electronically

I

KB: 1909 DF DF:

GL:

20 , #, cond.,@14

Sqzd 7"- 644' w/370 sx - 4/46

10 , #, csg,@951
w/0 sx

Hole 2494-2525' - not sqzd - 1/80

Perf'd & Sqzd - 2747' w/35 sx - 1/80

2700'

2749 -2753 TOPEKA 1/80

Vess Oil Corporation

Well: RUSCH A ,2 ,471100--2
Operator: VESS OIL CORPORATION
Location: N/2 SE SW 19-12S-15W RUSSELL C
Legal: SW SEC 19 12S-15W

Dir:

Spud Date:
Drilling Finished:
Completion Date:
First Production:

PUMPING DATA:

PU:
PM:
BHP: 2" x 1 1/2" x 12' RWT - 76" MSL
Anchor:

PRODUCTION FACILITY:

TUBING #1:

Type	#Jts	Size	Wt#/f	Grade	Set@
11.5 Reg;	8	102	2 3/8		2993

ROD:

Type	#Rods	Size	Length
SR	118	3/4	25
PY	1	3/4	6
PY	1	3/4	4

HISTORY:

11/36 COMPLETION
07/39 DEEPENED TO 3114
04/46 REPAIR CSG LEAKS @ 644' W/ 370 SX. DEEPENED TO 3140.
09/47 PULLED 5 1/2" LOOSE LINER & DEEPENED TO REAGAN. RAN & CEMENTED 5 1/2" LINER FROM 2895-3265'. RAN 4 1/2" LOOSE LINER FROM 3255-3310'.
08/64 CMT'D OFF REAGAN W/ 100 SX. PERF'D LKC A-L ZONES & ACIDIZED W/ 12,250 GAL.
05/67 WATERFLOOD BEGAN.
01/73 TA'D WELL
10/79 PULLED TBG,RODS & PUMP TO USE IN RUSCH A 4. LEFT MA & 1 JT TBG IN.
01/80 SET BP @ 3056, SET EZ DRILL PKR @ 3000'. SQ LINER TOP W/ 100 SX. PERF @ 2747 & SQ W/ 35 SX HOLE @ 2494-2525. PERF & ACIDIZE PLATT,TORONTO & TOPEKA. TESTED 29 BO, 64 BWPD.
10/15/97 BHP CHANGE. BBL AND PLUNGER WORE OUT, VLVS LEAKING, FAIRLY CLEAN INSIDE.

Input by:
Approved by:
Last Update:

2926 -2928 PLATT 1/80
2941 -2945 TORONTO 1/80
7 , #, csg,@2937
w/20 sx

2987 -2992 TORONTO 1/80

3019 -3033 LKC A(2) 8/64

3046 -3048 B 8/64

3068 -3081 D(2) 8/64

3094 -3096 F 8/64

3106 -3120 G(2) 8/64

3155 -3157 H 8/64

3176 -3198 I(2) 8/64

3208 -3210 J 8/64

3228 -3230 K 8/64

3252 -3254 L 8/64

5 1/2 , #, csg,@3265
w/275 sx

3265 -3310 Reagan Sd Sqzd 9/47

4 1/2 , #, csg,@3310
w/Loosesx.


TOC@ 2895'

CIBP@3000

CIBP@3056

OPBTD: 3255'

TD: 3310'

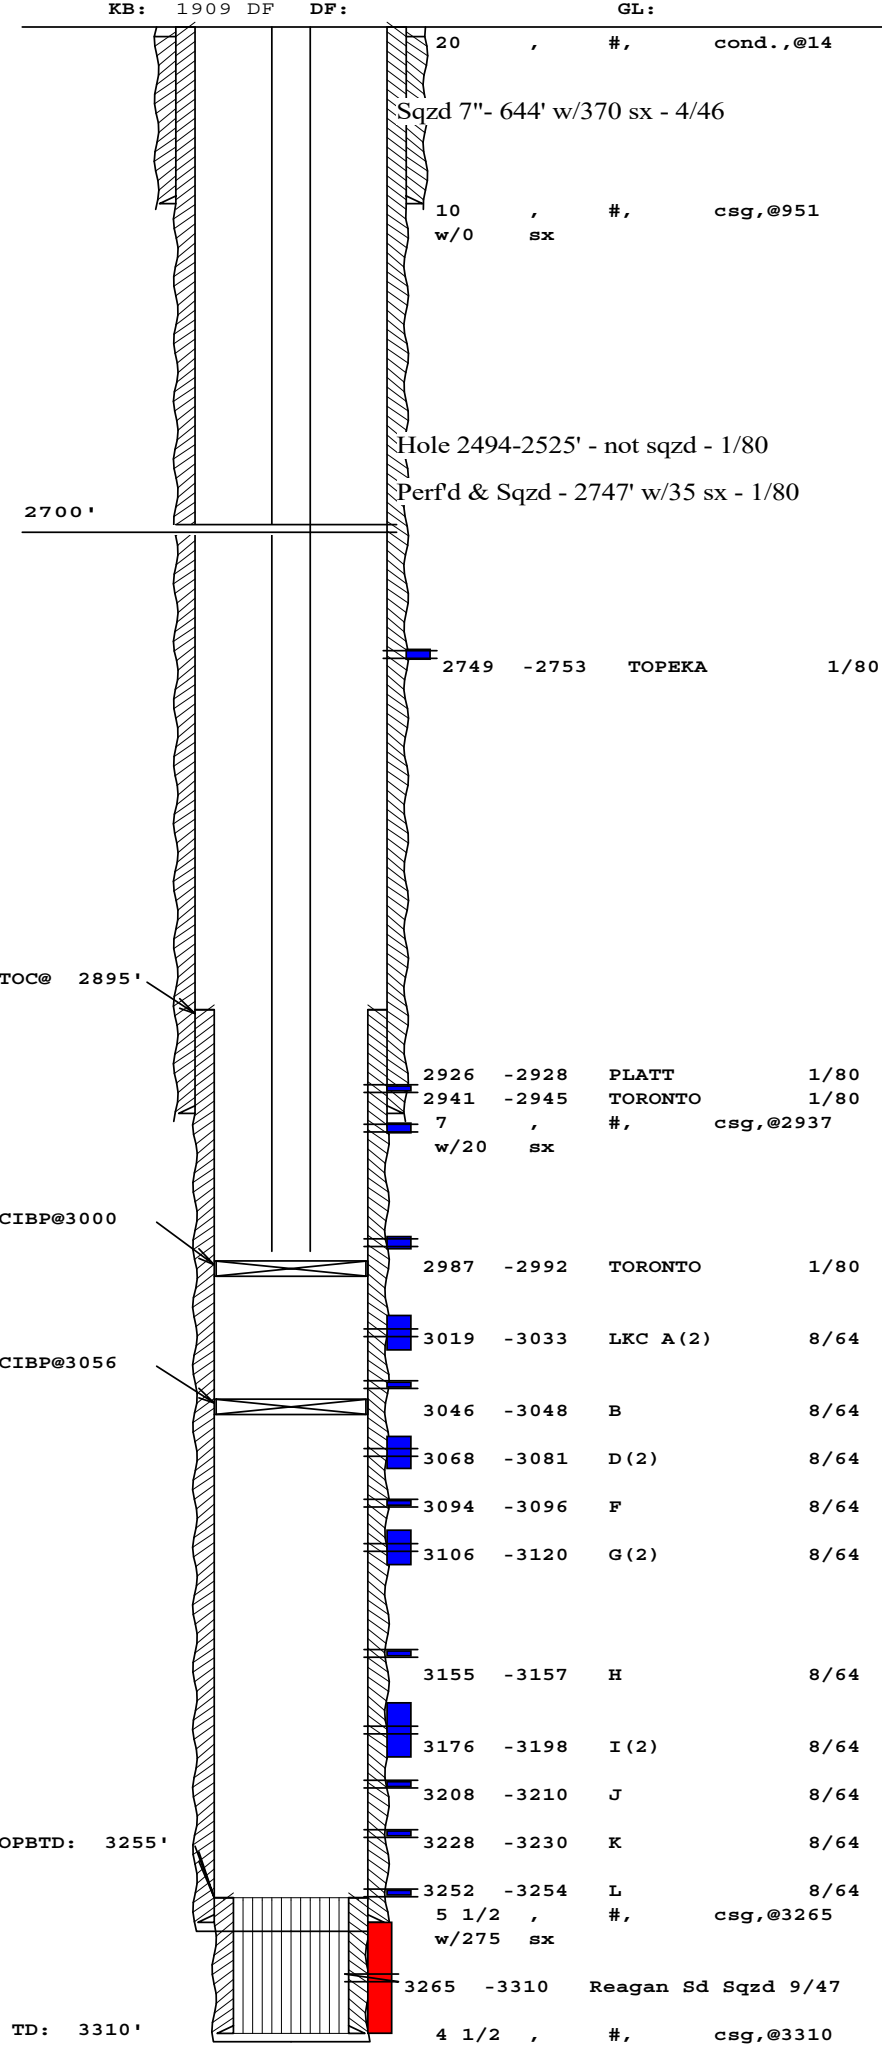

October 15, 2019

Dylan Klaus
Vess Oil Corporation
1700 N WATERFRONT PKWY BLDG 500
WICHITA, KS 67206-6619

Re: Plugging Application
API 15-167-19431-00-02
RUSCH A 2
SW/4 Sec.19-12S-15W
Russell County, Kansas

Dear Dylan Klaus:

The Conservation Division has received your Well Plugging Application (CP-1).

Under K.A.R. 82-3-113(b)(2), you must notify DISTRICT 4 of your proposed plugging plan at least 5 days before plugging the well. DISTRICT 4's phone number is (785) 261-6250. Failure to notify DISTRICT 4, or failure to file a Well Plugging Record (CP-4) after the well is plugged will result in a penalty recommendation.

Under K.A.R. 82-3-600, you must file an Application for Surface Pit (CDP-1) if you wish to use a workover pit while plugging the well. Failure to timely file a CDP-1, failure to timely remove fluids, or failure to timely file Closure of Surface Pit (CDP-4) or Waste Transfer (CDP-5) forms will result in a penalty recommendation.

This receipt does NOT constitute authorization to plug this well if you do not otherwise have the legal right to do so.

This receipt is VOID after April 12, 2020. If the well is not plugged by then, you will have to submit a new CP-1 if you wish to plug the well.

The April 12, 2020 deadline does NOT override any compliance deadline given to you by Legal, District, or other Commission Staff. Failure to comply with any given deadline will still result in the Commission assessing penalties, or taking other legal action.

Sincerely,
Production Department Supervisor

cc: DISTRICT 4