

K & N PETROLEUM, INC.
NORMAN KLEPPER LEASE
SW. 1/4, SECTION 17, T22S, R11W
STAFFORD COUNTY, KANSAS

(NE. 130TH ST.) SAND ROAD (GATE CLOSED) NO ROAD

ROAD (NE. 100TH AVE.)

ROAD

Notes:

1. Set "T" post at location site.
2. All flagging Red & Yellow.
3. No overhead power available in Sec. 17.
4. Kansas One Call System Inc. should be notified before excavation (1-800-344-7233).
5. **CAUTION: Various pipelines in Sec. 17.**
6. Cattle in pasture at date of staking.
7. Contact landowner for best access.

TANK BATTERY

17

Drillsite Location
Norman Klepper "A" #2
962' FSL 2259' FWL
Ground Elevation = 1826
Y = 533522 X = 1983731
 State Plane-NAD 27-Kansas South
 Latitude 38.131939
 Longitude -98.556907
 WGS 84-NAD 83

(Old Well) Klepper SW #1
 2297' FSL 912' FWL
 Elev. 1820

PASTURE (SANDHILLS)

NORMAN KLEPPER "A" #1
 1830

TRAIL


NO

NO

NO

ROAD

* Ingress and egress to location as shown on this plat is per usage only and may not be legally gained for public use. Contact landowner, tenant and county road department for access.

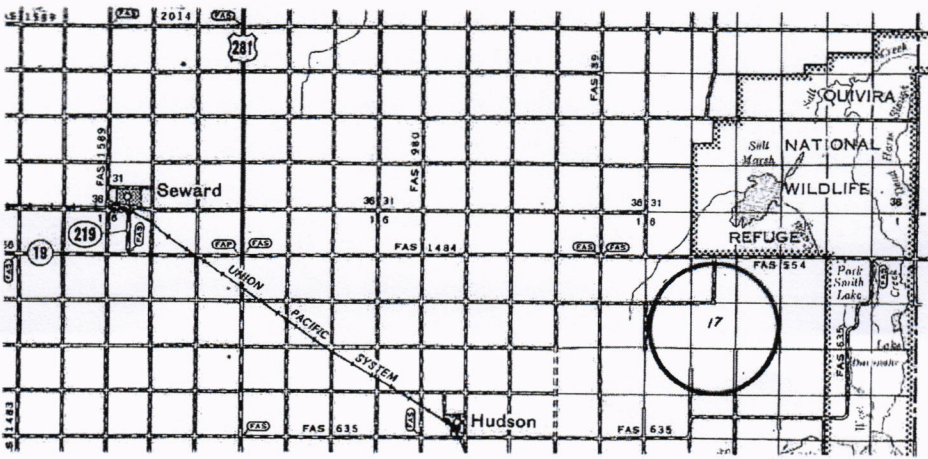

* Controlling data is based upon the best maps and photographs available to us and upon a regular section of land containing 640 acres.
 * Approximate section lines were determined using the normal standard of care of oilfield surveyors practicing in the state of Kansas. The section corners, which establish the precise section lines, were not necessarily located, and the exact location of the drillsite location in the section is not guaranteed. Therefore, the operator securing this service and accepting this plat and all other parties relying thereon agree to hold Central Kansas Oilfield Services, Inc., its officers and employees harmless from all losses, costs and expenses and said parties released from any liability from incidental or consequential damages.
 * Elevations derived from National Geodetic Vertical Datum.

Date April 19, 2019