


[Empty rectangular box]

Township: _____ Range: _____ County: _____ State: _____

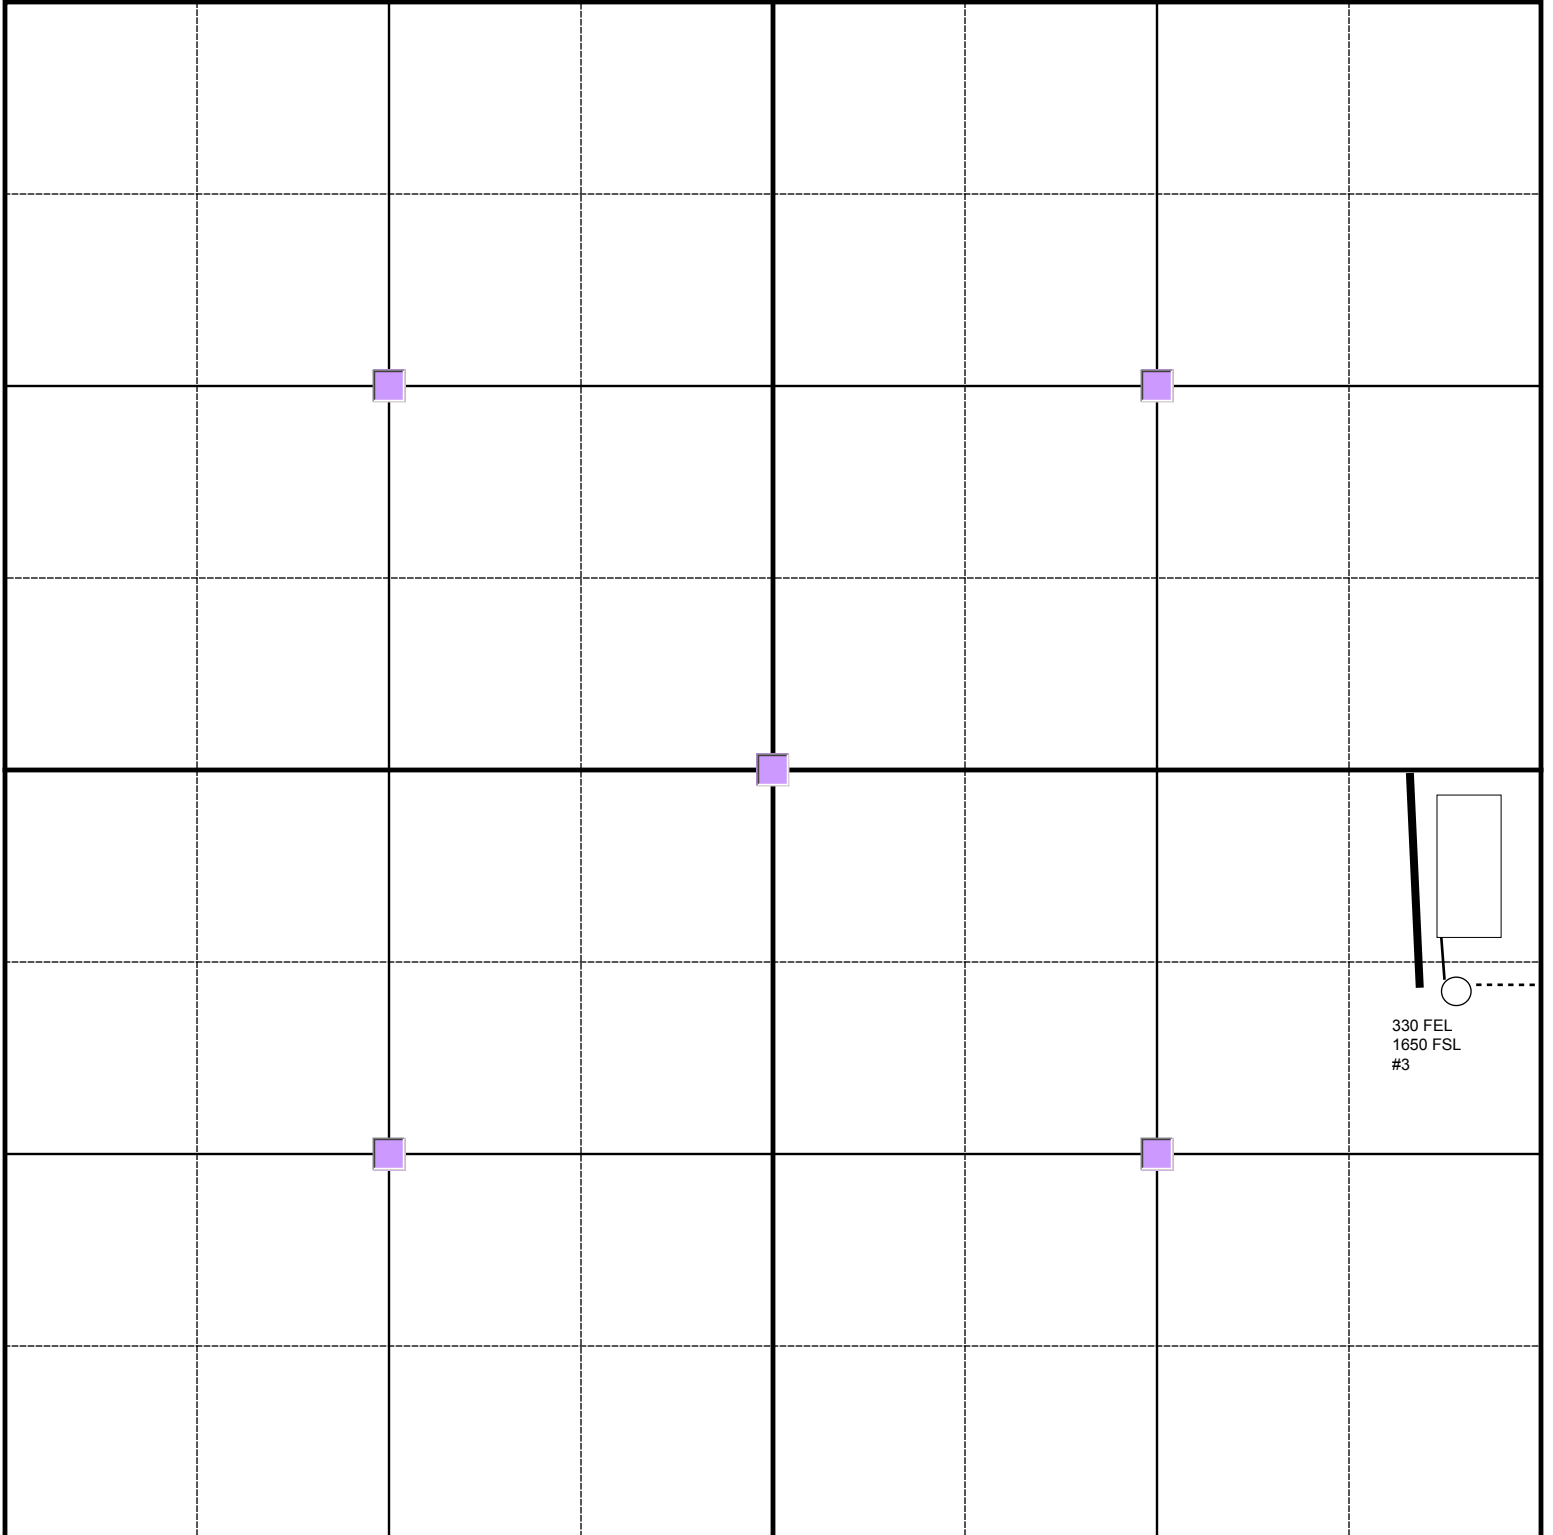

[Empty rectangle] Tank Battery

[Thick solid line] Road

[Thin solid line] Pipeline

[Dashed line] Electric Line

330 FEL
1650 FSL
#3