


[Empty rectangular box]

Township: _____ Range: _____ County: _____ State: _____

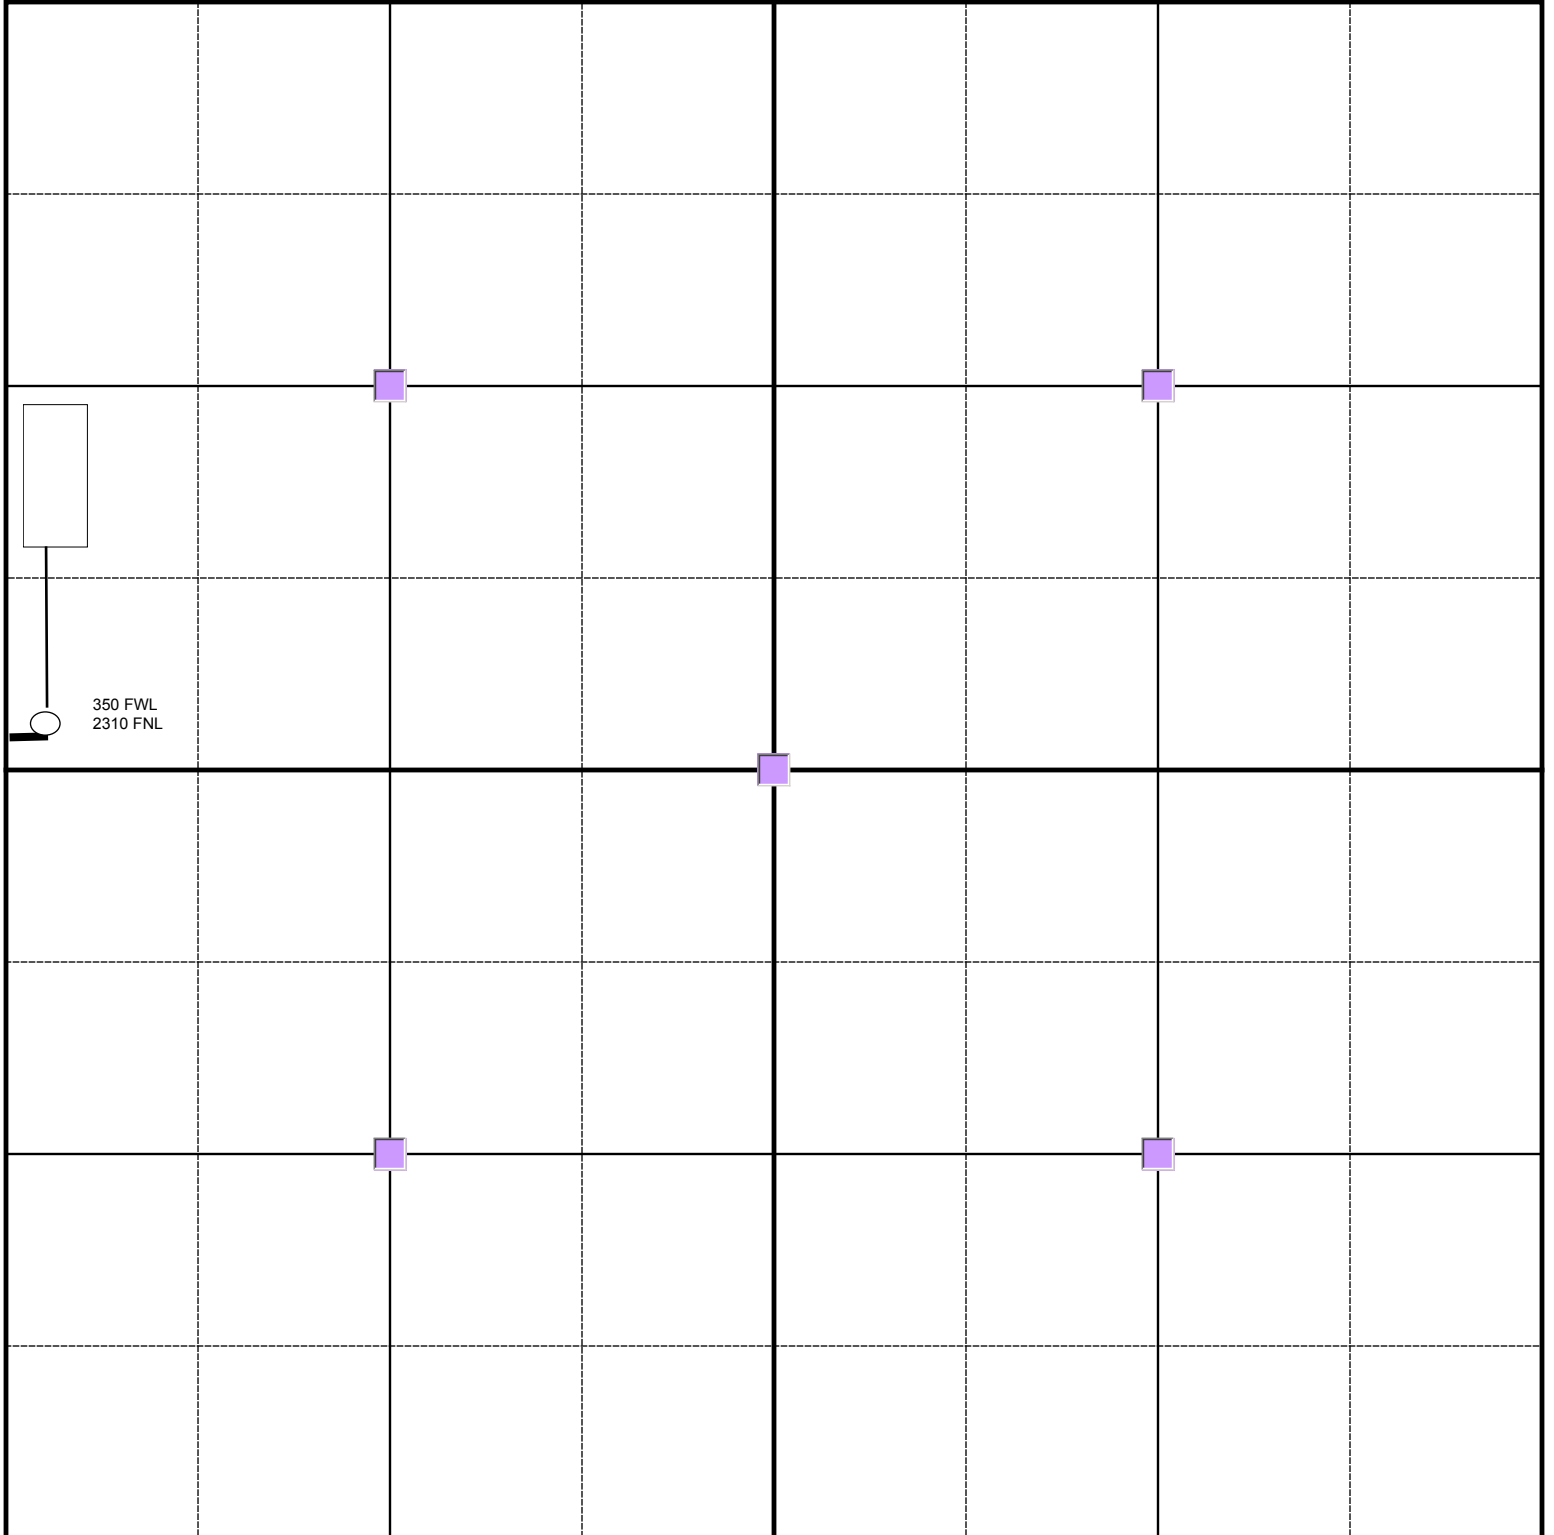

[Empty rectangular box] Tank Battery

— Road

— Pipeline

- - - - - Electric Line