

**BEREXCO, LLC
 BBLL LEASE
 SW. 1/4, SECTION 16, T8S, R23W
 GRAHAM COUNTY, KANSAS**


HIGHWAY 24

Notes:


1. Set iron rod at location site.
2. All flagging Red & Yellow.
3. Overhead power available in Sec. 16.
4. Kansas One Call System Inc. should be notified before excavation (1-800-344-7233).
5. CAUTION; Various pipelines in Sec. 16.
6. Contact landowner for best access.

●●● - BBLL Tank battery
 — Lead line
 — electric line
 — lease Road

*Ingress and egress to location as shown on this plot is per usage only and may not be legally opened for public use. Contact landowner, tenant and county road department for access.

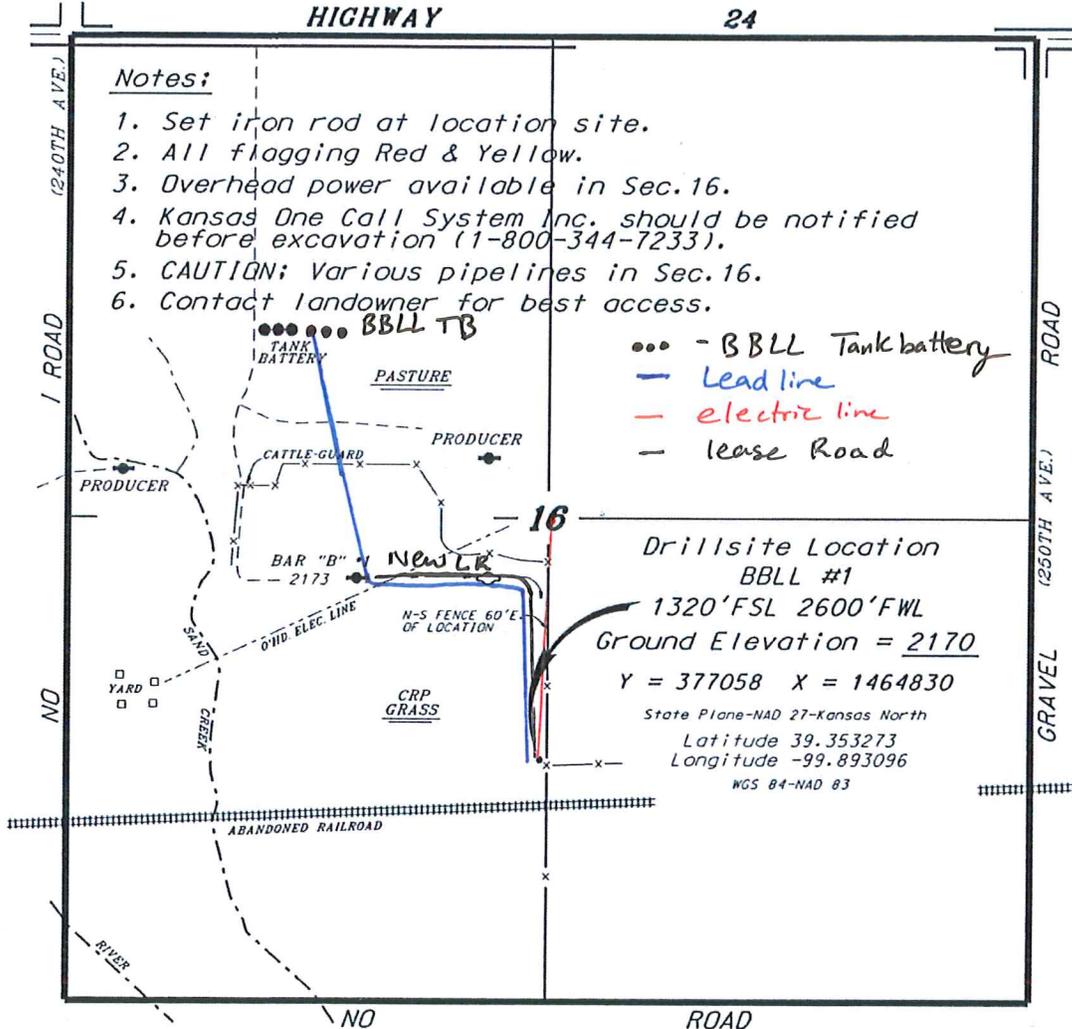

**Drillsite Location
 BBLL #1
 1320' FSL 2600' FWL
 Ground Elevation = 2170
 Y = 377058 X = 1464830
 State Plane-NAD 27-Kansas North
 Latitude 39.353273
 Longitude -99.893096
 WGS 84-NAD 83**

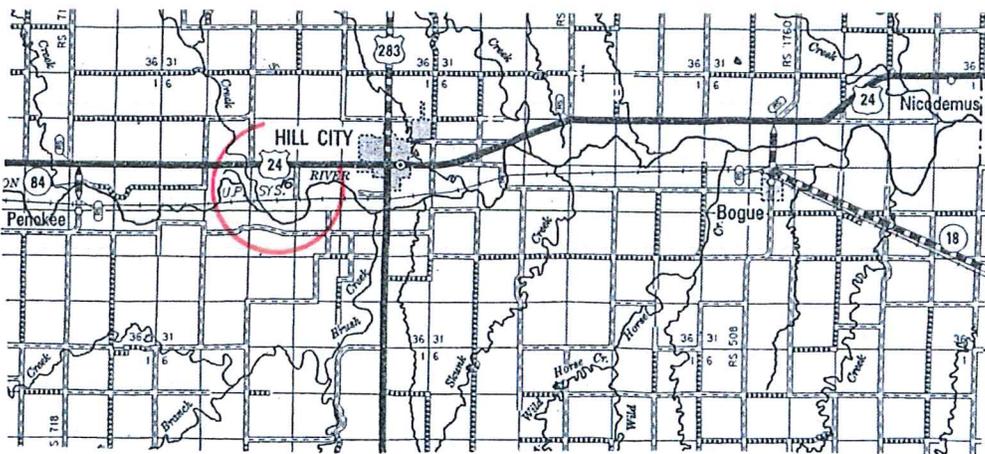

• Controlling data is based upon the best maps and photographs available to us and upon a regular section of land containing 640 acres.
 • Approximate section lines were determined using the normal standard of care of oilfield surveyors practicing in the state of Kansas. The section corners, which establish the precise section lines, were not necessarily located, and the exact location of the drillsite location in the section is not guaranteed. Therefore, the operator securing this service and accepting this plot and all other parties relying thereon agree to hold Central Kansas Oilfield Services, Inc., its officers and employees harmless from all losses, costs and expenses and said entities released from any liability from incidental or consequential damages.
 • Elevations derived from National Geodetic Vertical Datum.

Date October 3, 2019