

# ADVANTAGE ELEVATIONS

OIL FIELD SURVEYORS

BOX 8604 - PRATT, KS 67124  
(620) 672-6491

107191  
INVOICE NO.

AGV CORPORATION  
OPERATOR

1-28 BUSENITZ  
NO. FARM

BUTLER 28 24s 3e 670' FSL & 992' FWL of SE/4  
COUNTY S T R LOCATION


ELEVATION: 1375' GR



AGV CORPORATION  
PO BOX 377  
ATTICA, KS 67009-0377

AUTHORIZED BY: Kent Roberts

SCALE: 1" = 1000'

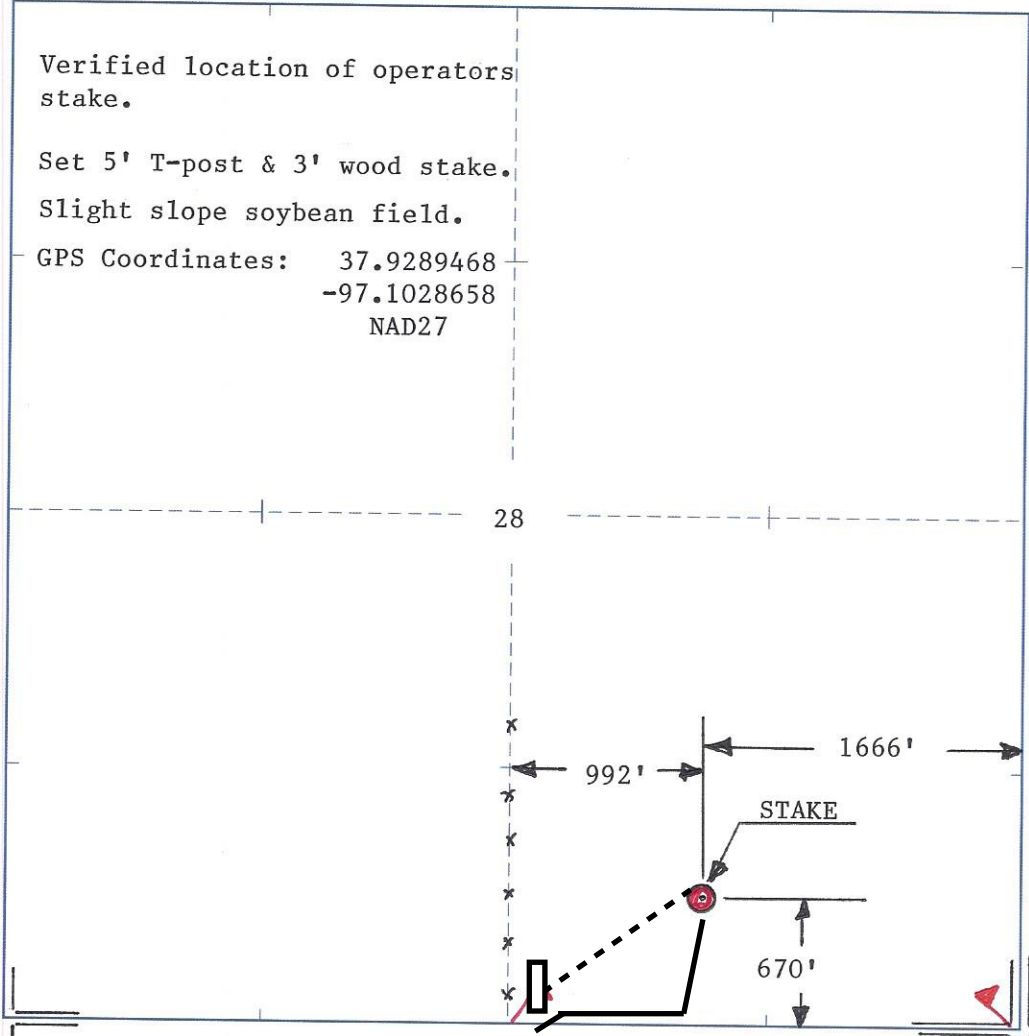

Verified location of operators  
stake.

Set 5' T-post & 3' wood stake.

Slight slope soybean field.

GPS Coordinates: 37.9289468  
-97.1028658  
NAD27

Proposed & Non-Binding

— Road

- - - Lead Line

□ Tank Battery

DATE STAKED: 10/7/19