WELLBORE SCHEMATIC

PROPOSED

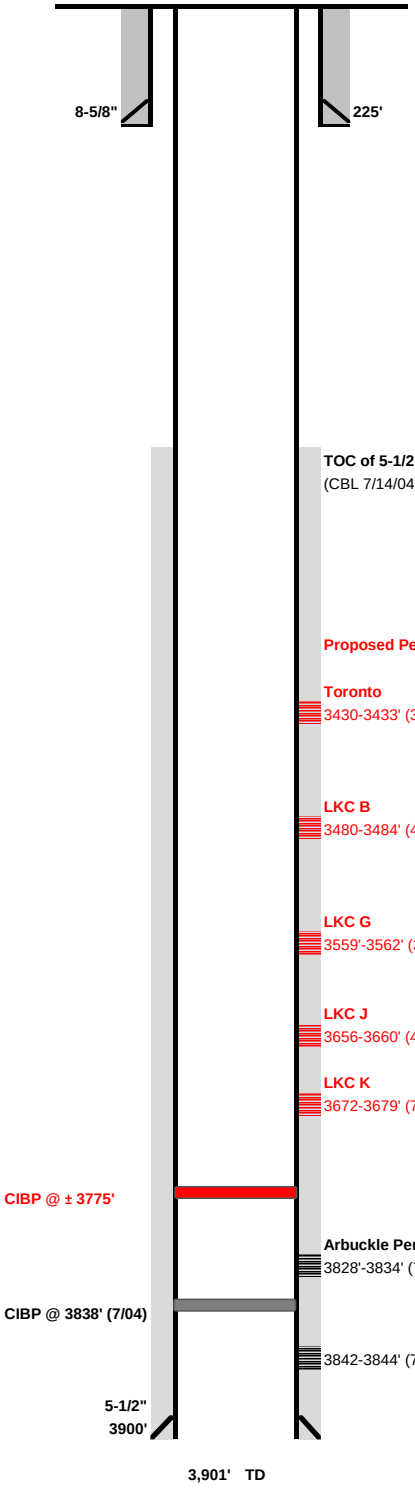

Lease:	**Moran A**			**Well No.**	**5**
API No.	15-165-21765			**Status**	Active
Location:	SWSESE Section 6 T17S R19W				
County:	Rush	**State:**	Kansas	**Field:**	Hampton
TD	3901'	**GL**	2090'	**Spud Date:**	6/30/2004
PBTD	3838'	**KB**	2098'	**Comp Date:**	7/21/2004
Current Perfs/OH:	3828-34'	**Current Zone:**		**Arbuckle**	

Surface Equipment

Unit Make:		**Unit Size:**	
SL's of Unit		**SL Unit is in**	

Casing Breakdown

	Size	Grade / Wt	Depth	Cement
Surface	8-5/8"	23#	225'	150 sx
Production	5-1/2"	17#	3900'	525 sx
Production				
Production				
Liner				

Completion Assembly

Qty	Description	Footage	
			0.00'
			0.00'
			0.00'
			0.00'
			0.00'
			0.00'
			0.00'
			0.00'
			0.00'
			0.00'
			0.00'
			0.00'
			0.00'
	Total	**0.00'**	

Rod Breakdown

Qty	Description	Footage	
			0.00'
			0.00'
			0.00'
			0.00'
			0.00'
			0.00'
			0.00'
			0.00'
			0.00'
			0.00'
			0.00'
			0.00'
	Total	**0.00'**	

Comments

7/04: Perf'd 3842-3844' wet. Completed on 3828-3834' for 13 BO, 251 BW w/ 1,580' FAP
4/08: Polymer treated w/ 1130 BBL gel 1500-6000 PPB, achieved positive WHP, Pf: 883 PSI
IP: 46 BO, 43 BW pumped off. Pre-treatment: 4 BO, 264 BW w/ 2,527' FAP.
6/19: SI as uneconomic. 5/19 WT: 1 BO, 149 BW w/ 2,448' FAP.

PREPARED BY: L. Campo **UPDATED:** 9/25/2019