


R 26 W

1 360 000 FEET

100

393000mE

394

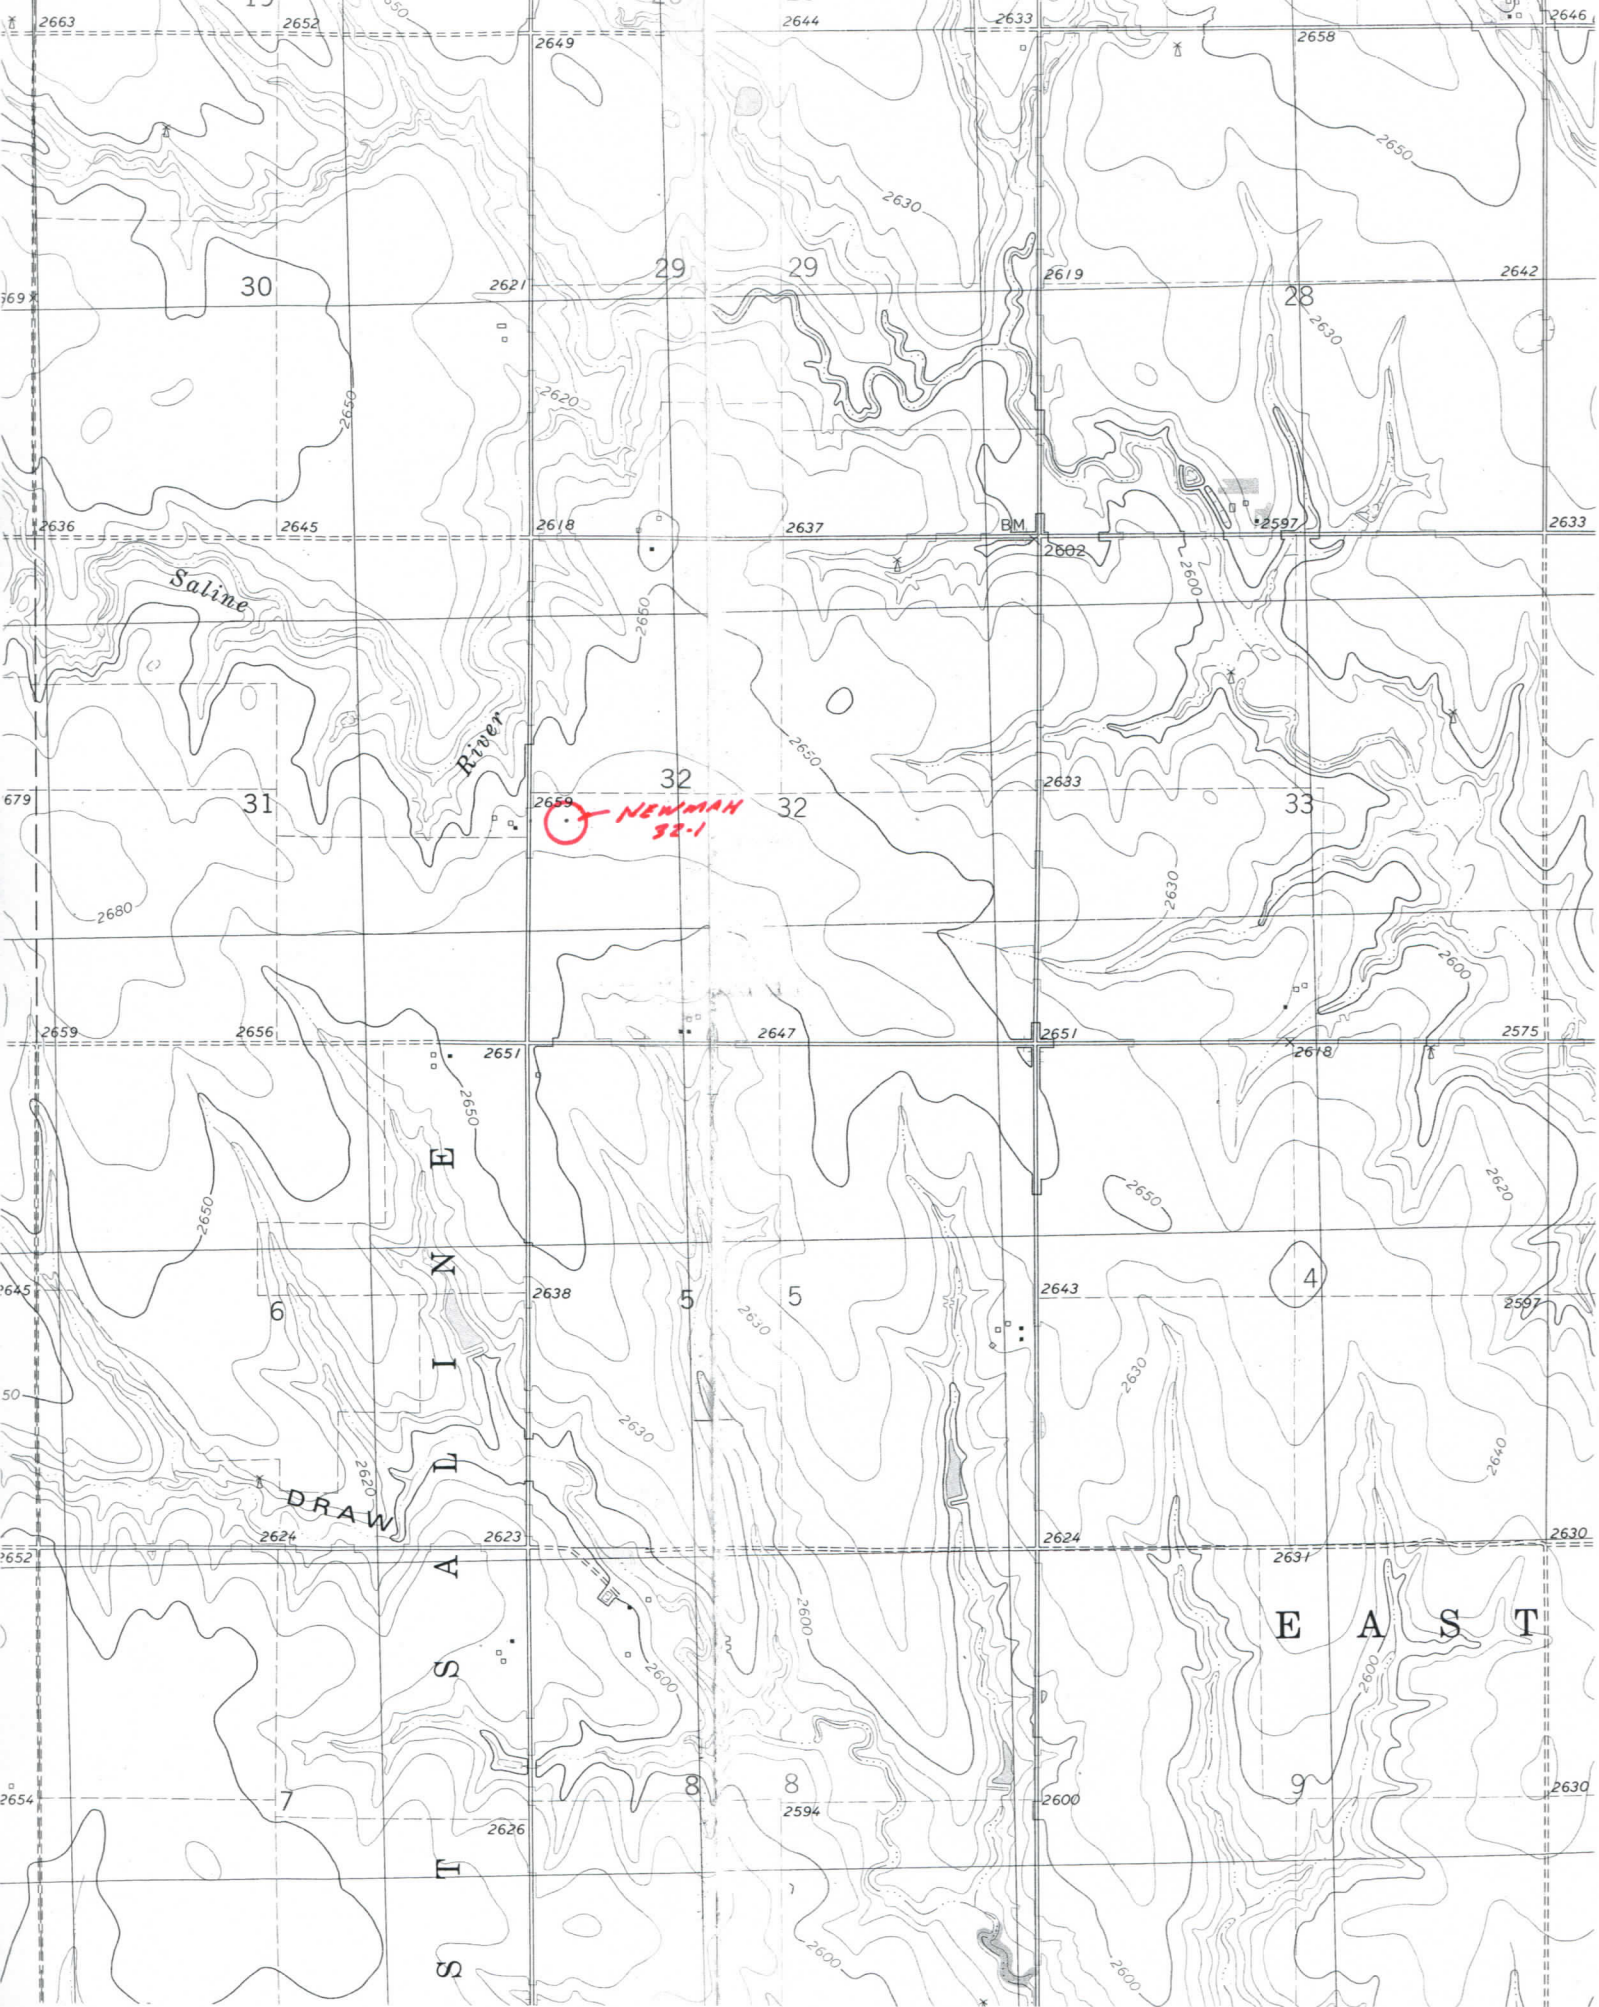

Saline

River

DRAW

S  
A  
L  
I  
N  
E

E  
A  
S  
T

NEWMAN  
32-1

4