


[Empty rectangular box]

Township: _____ Range: _____ County: _____ State: _____

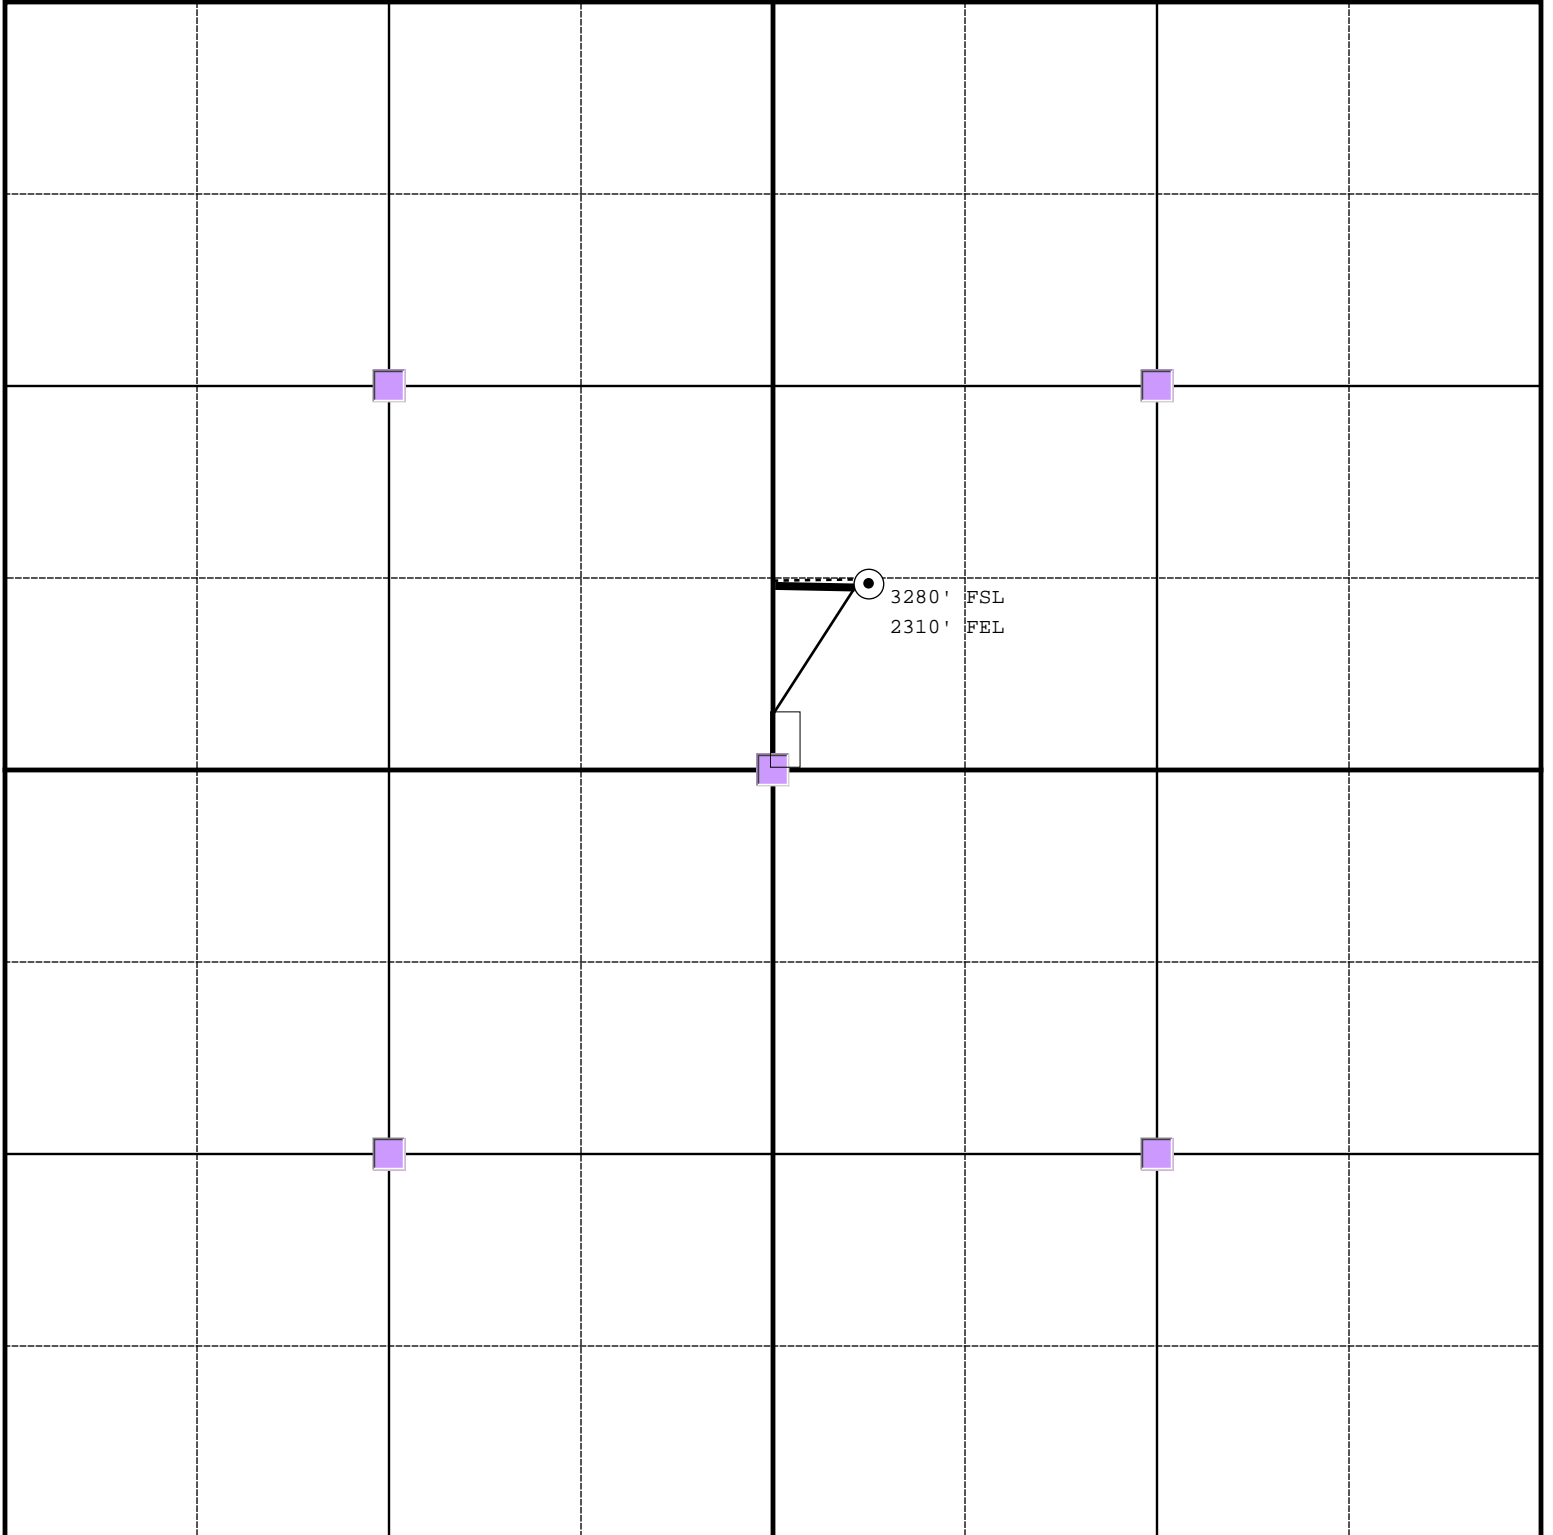

-  Tank Battery
-  Road
-  Pipeline
-  Electric Line