


SECTION MAP

SECTION 34  
TOWNSHIP 6S  
RANGE 20W

LEASE Ross Trust #1-34

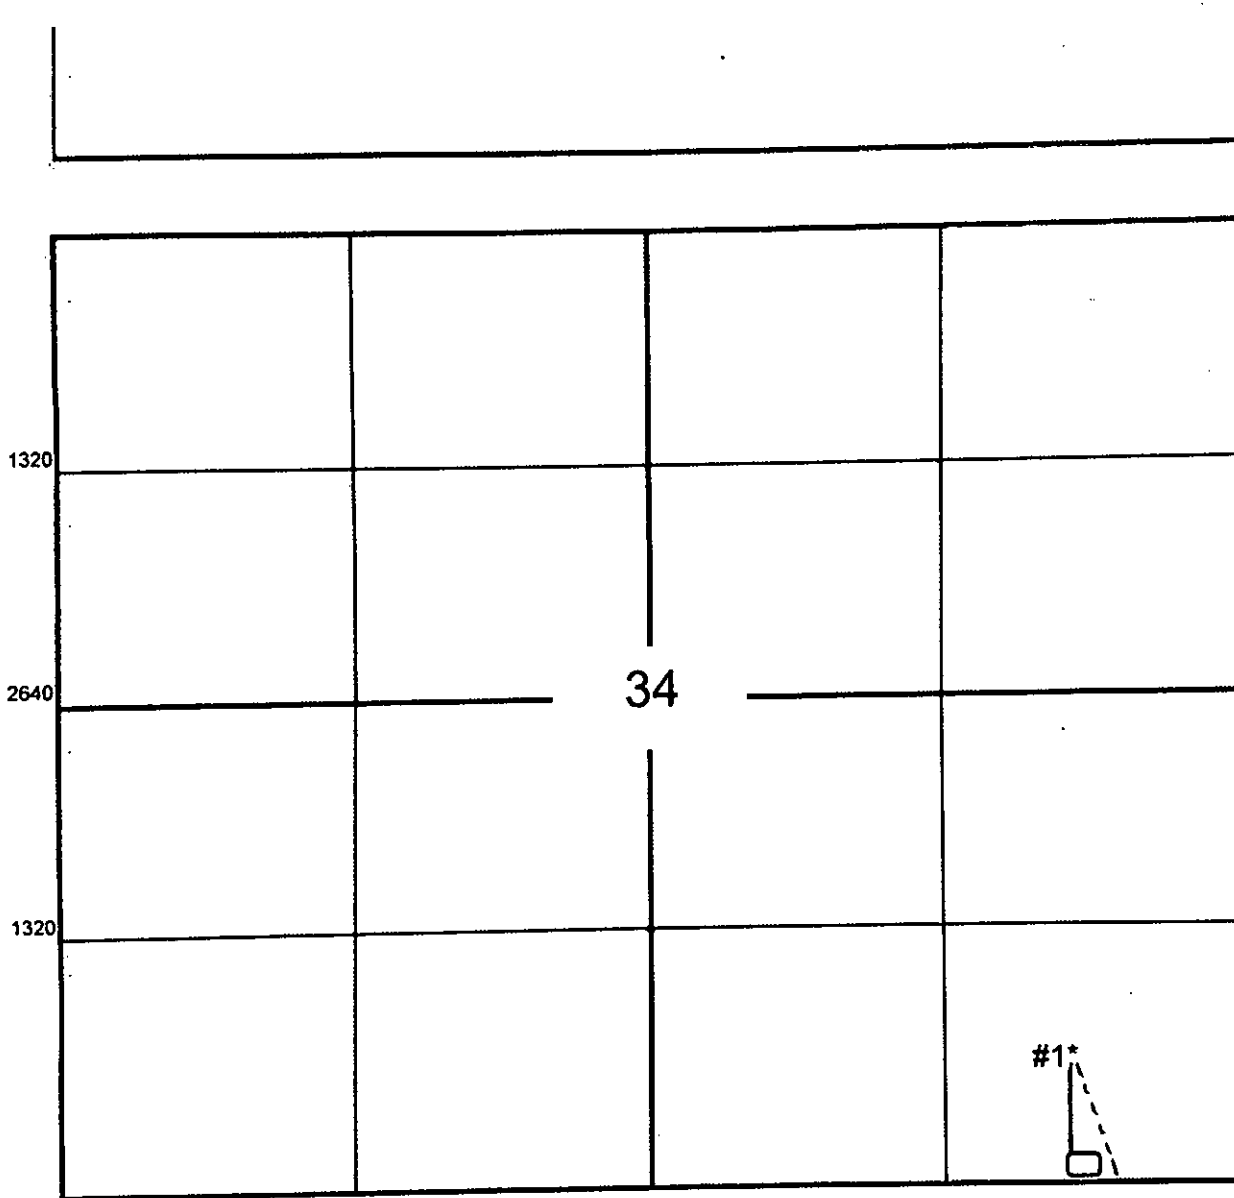

LEGEND:

FLOWLINES —  
ELECTRICAL LINES  
GAS LINES  
SALTWATER LINES  
INJECTION LINES

PIPELINE  
PHONE LINES  
CONTROL WIRING  
FRESHWATER LINES  
TRANSFORMERS

STOCK TANKS □  
GUN BARREL  
WELL/PRODUCING \*  
WELL/TAD  
WELL/PLUGGED

WELL/INJECTION  
WELL/DISPOSAL  
LEASE ROAD - - -