ADVANTAGE ELEVATIONS
OIL FIELD SURVEYORS

BOX 8604 - PRATT, KS 67124
(620) 672-6491

1025191
INVOICE NO.

AGV Corp.
OPERATOR

1
NO.

SPRAGUE
FARM

BUTLER
COUNTY

35 S 25s T 3e R

1310' FSL & 1395' FEL of Sec
LOCATION

ELEVATION: 1304' GR

N

ZEAL OIL DEVELOPMENT LLC
212 N. Market
Suite 312
Wichita, KS 67202

AUTHORIZED BY: Hi Lewis

SCALE: 1" = 1000'

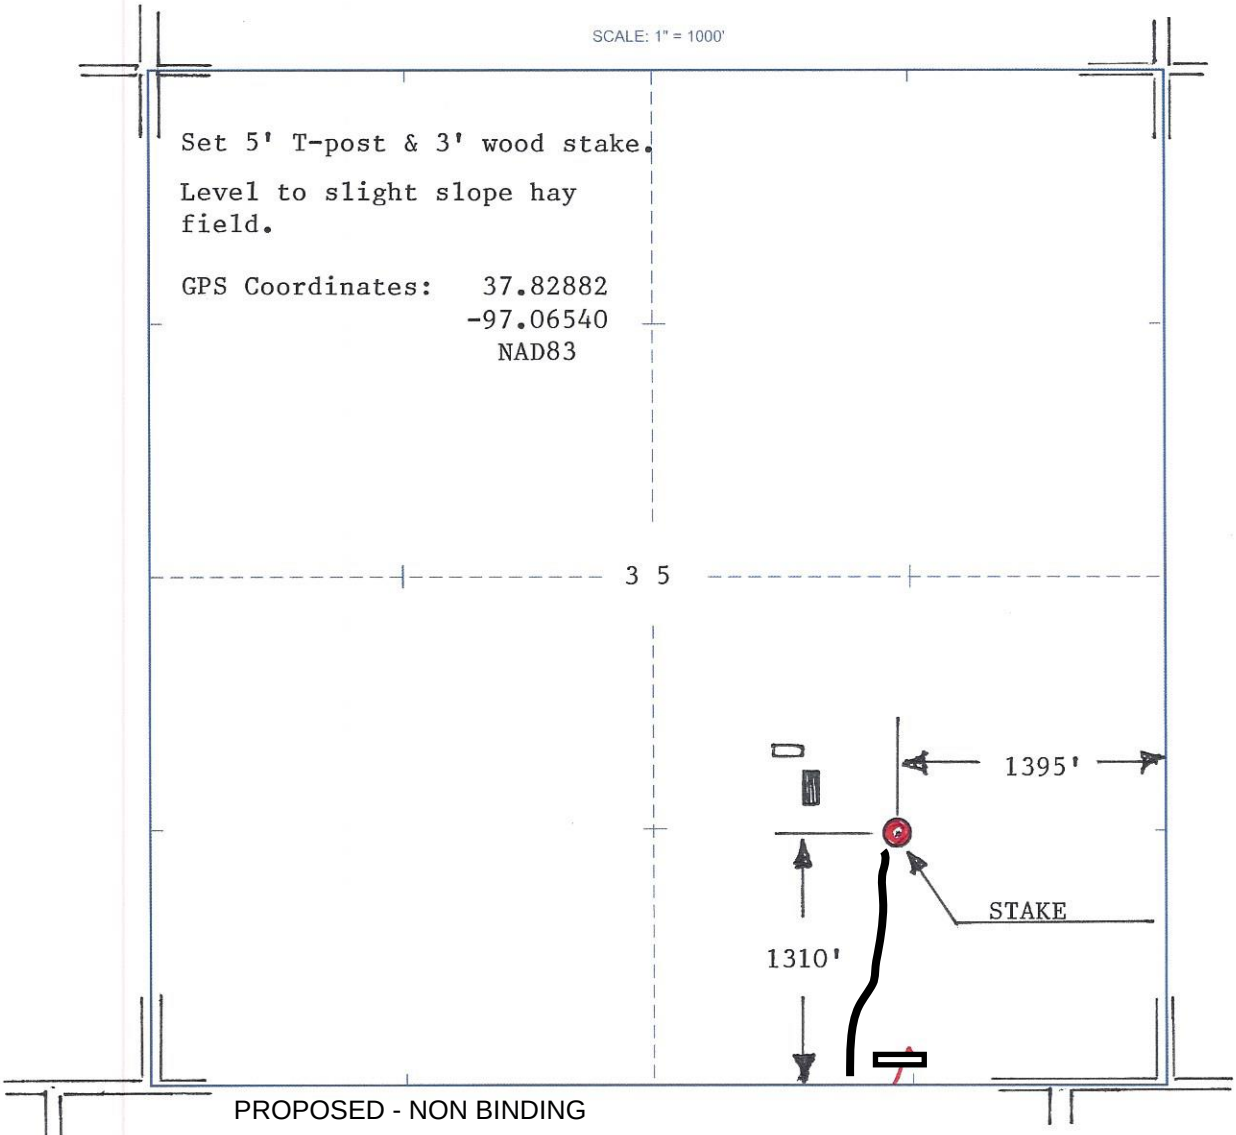

PROPOSED - NON BINDING

Tank Battery

Lease Road & Electric

DATE STAKED: 10/25/19

Taylor Printing Inc., • Pratt, KS 67124 • 620-672-3656