


Map of Kansas Oil and Gas

Kansas Oil and Gas

*Newman*

Kan

Statewide View | Zoom to Location | Filter Wells | Label Wells | Download Wells | Print to PDF | Clear Highlight | Help

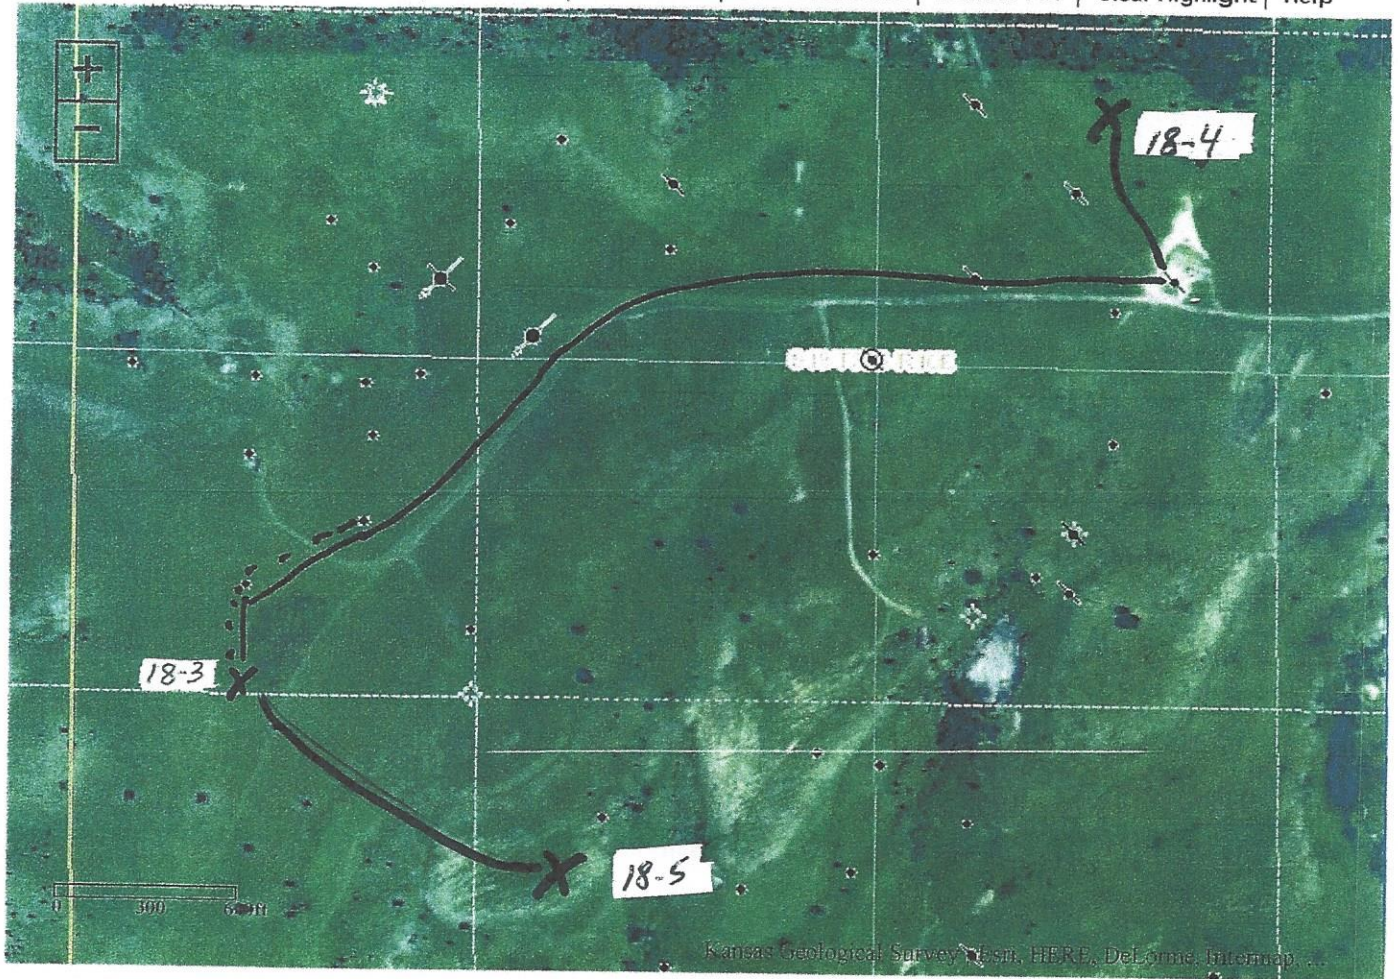

<http://maps.kgs.ku.edu/oilgas/index.cfm?extenttype=well&extentvalue=1002897141>