


Castle Resources Inc

License # 9860

Chesney #1

1954 GL

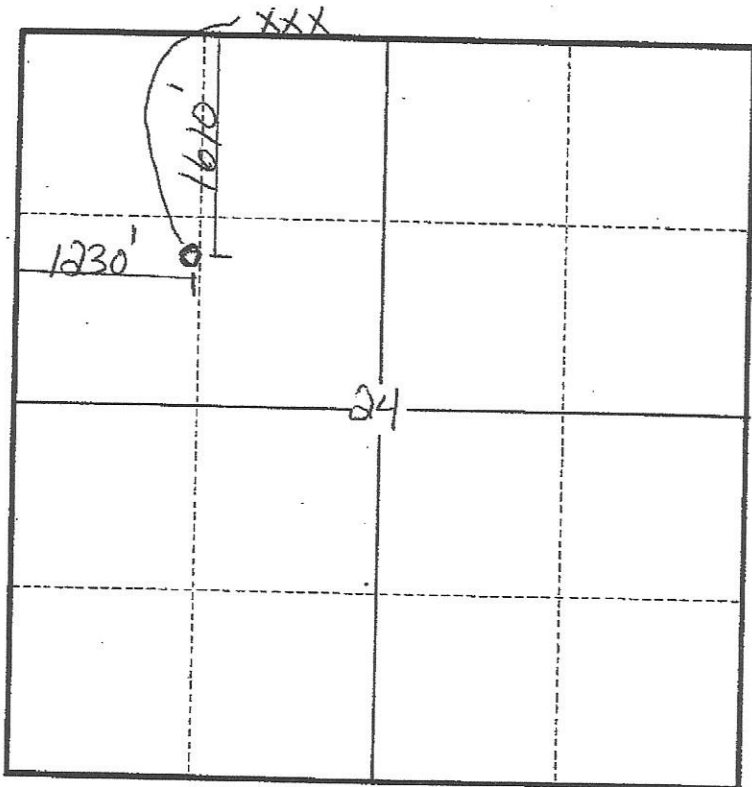

— = Trail into Location

XXX = Proposed tank battery
to be determined by landowner

O = Location