

ADVANTAGE ELEVATIONS

OIL FIELD SURVEYORS

BOX 8604 - PRATT, KS 67124
(620) 672-6491

1118191

INVOICE NO.

VAL ENERGY OPERATOR 1-1 NO. CROW FARM
COWLEY COUNTY 1 34s 6e S T R 990' FSL & 990' FEL of Sec. LOCATION


ELEVATION: 1251' GR



VAL ENERGY INC
125 N Market, Ste 1110
Wichita, KS 67202

AUTHORIZED BY: Todd Allam

SCALE: 1" = 1000'

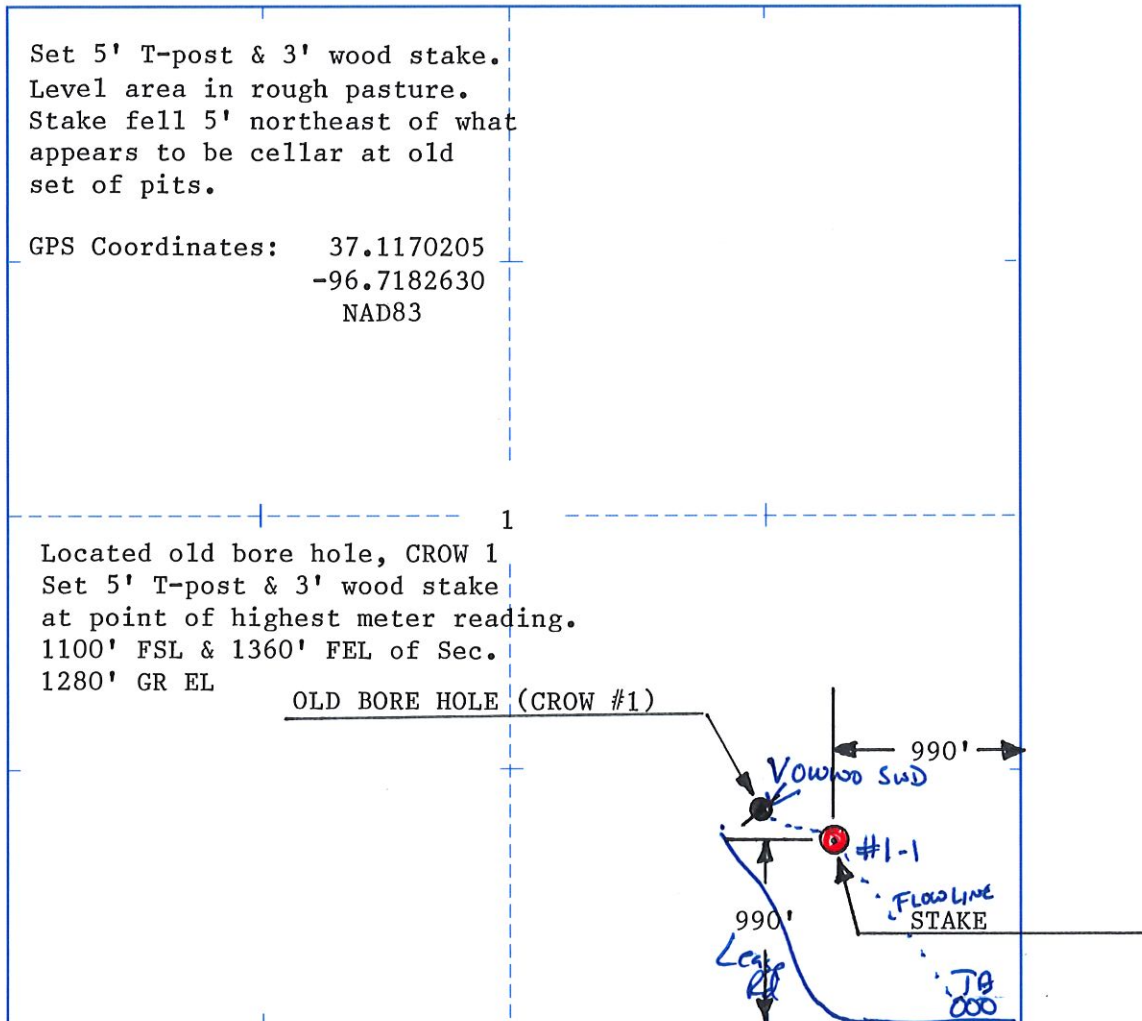

DATE STAKED: 11/20/19