


*Ingress and egress to location as shown on this plot is per usage only and may not be legally opened for public use. Contact landowner, tenant and county road department for access.

1. Set iron rod at location site.
2. All flogging Red & Yellow.
3. Overhead power available in Sec.17.
4. Kansas One Call System Inc. should be notified before excavation (1-800-344-7233).
5. CAUTION: Various pipelines in Sec.17.
6. Contact landowner for best access.
7. Original location (660'FSL 990'FEL) fell in a draw, set new location per representative.

WGS 84-NAD 83

ROAD

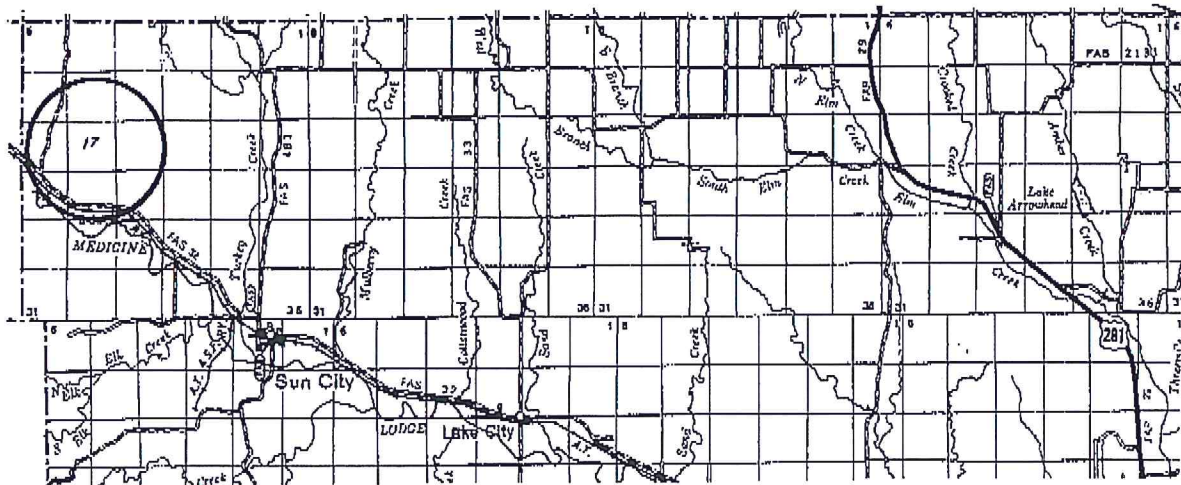

- Approximate section lines were determined using the normal standard of care of oilfield surveyors practicing in the state of Kansas. The section corners, which establish the precise section lines, were not necessarily located, and the exact location of the oilfield location in the section is not quantified. Therefore, the operator securing this service and accepting this plot and all other parties relying thereon agree to hold Central Kansas Oilfield Services, Inc., its officers and employees harmless from all losses, costs and expenses and said parties released from any liability from incidental or consequential damages.

November 4, 2019

CENTRAL KANSAS OILFIELD SERVICES INC (820)792-1977

SCALE 1" = 1000'

