——— Road

- - - - - - Production Line
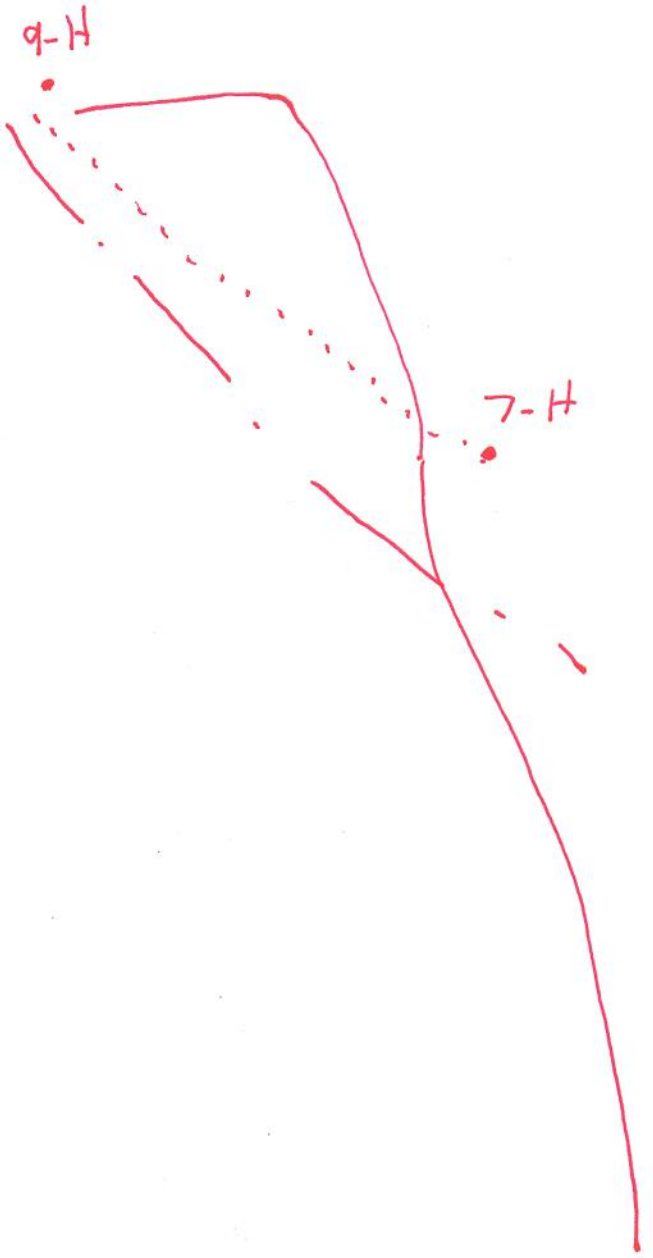
_ — . — Electric Line