


- Road
- - - Production Line
- · - · - Electric Line

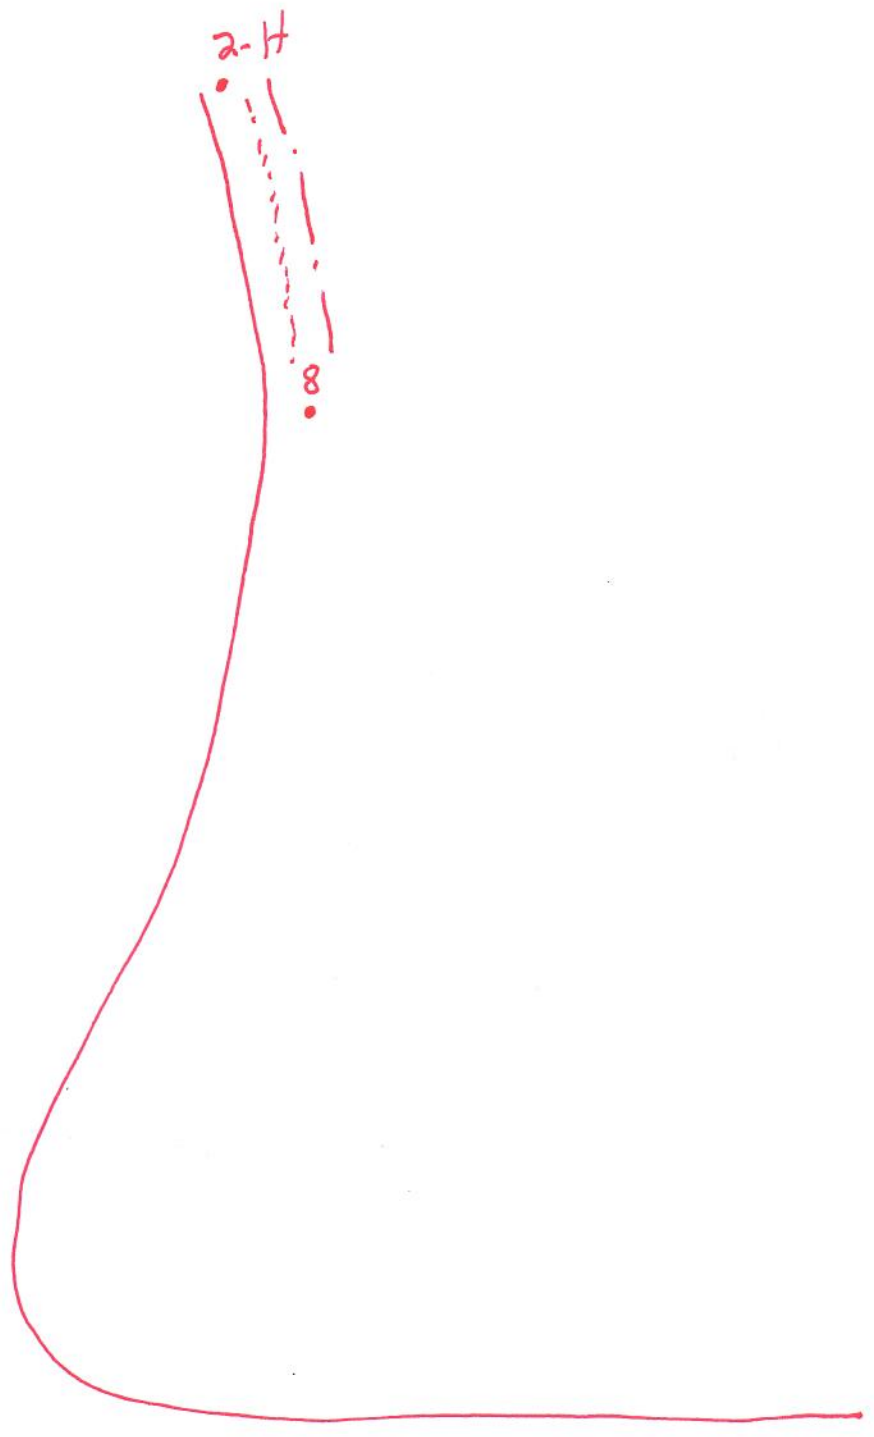

1-H

2-H

8