


Castle Resources Inc #9860

Erickson #2

C S/2 11-55-31W

Rawlins CO KS

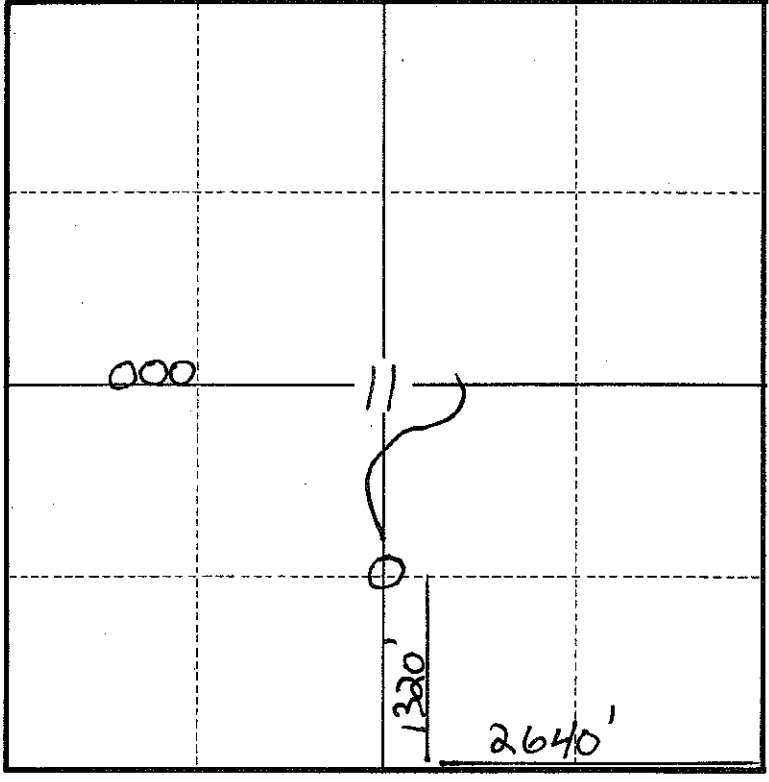

o = Location

ooo = Existing Tank battery

~ = Trail into location