


Road —————
Production Line
Electric Line - - - - -

1-17

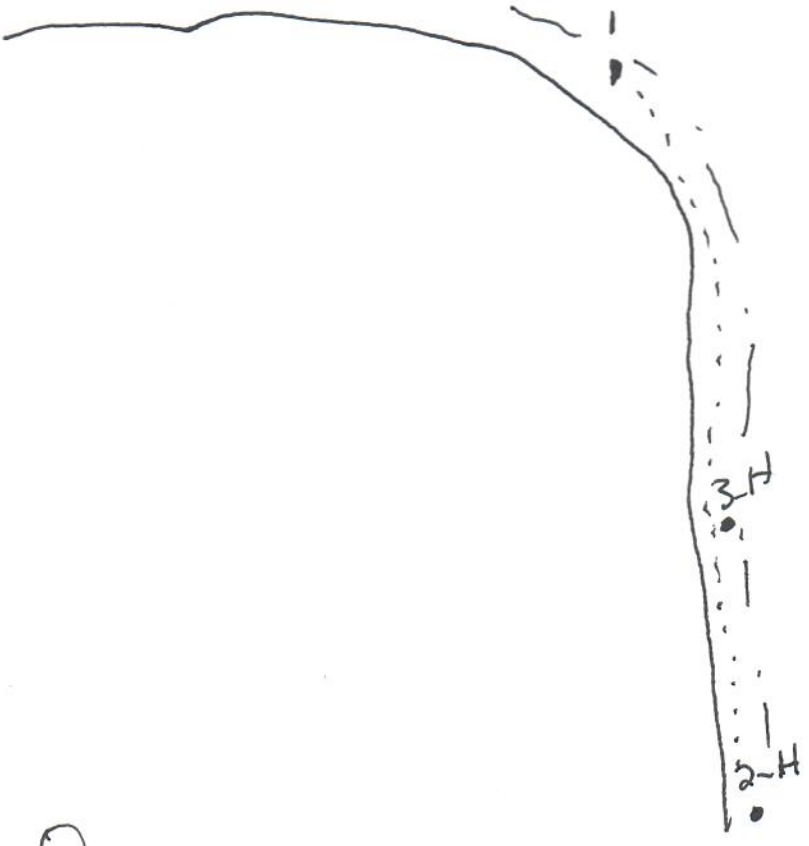

0
0
0