


*DEUTSCH OIL COMPANY
MARDIS LEASE
SE. 1/4, SECTION 26, T26S, R12W
PRATT COUNTY, KANSAS*

*Ingress and egress to location as shown on this plat is per usage only and may not be legally opened for public use. Contact landowner, tenant and county road department for access.

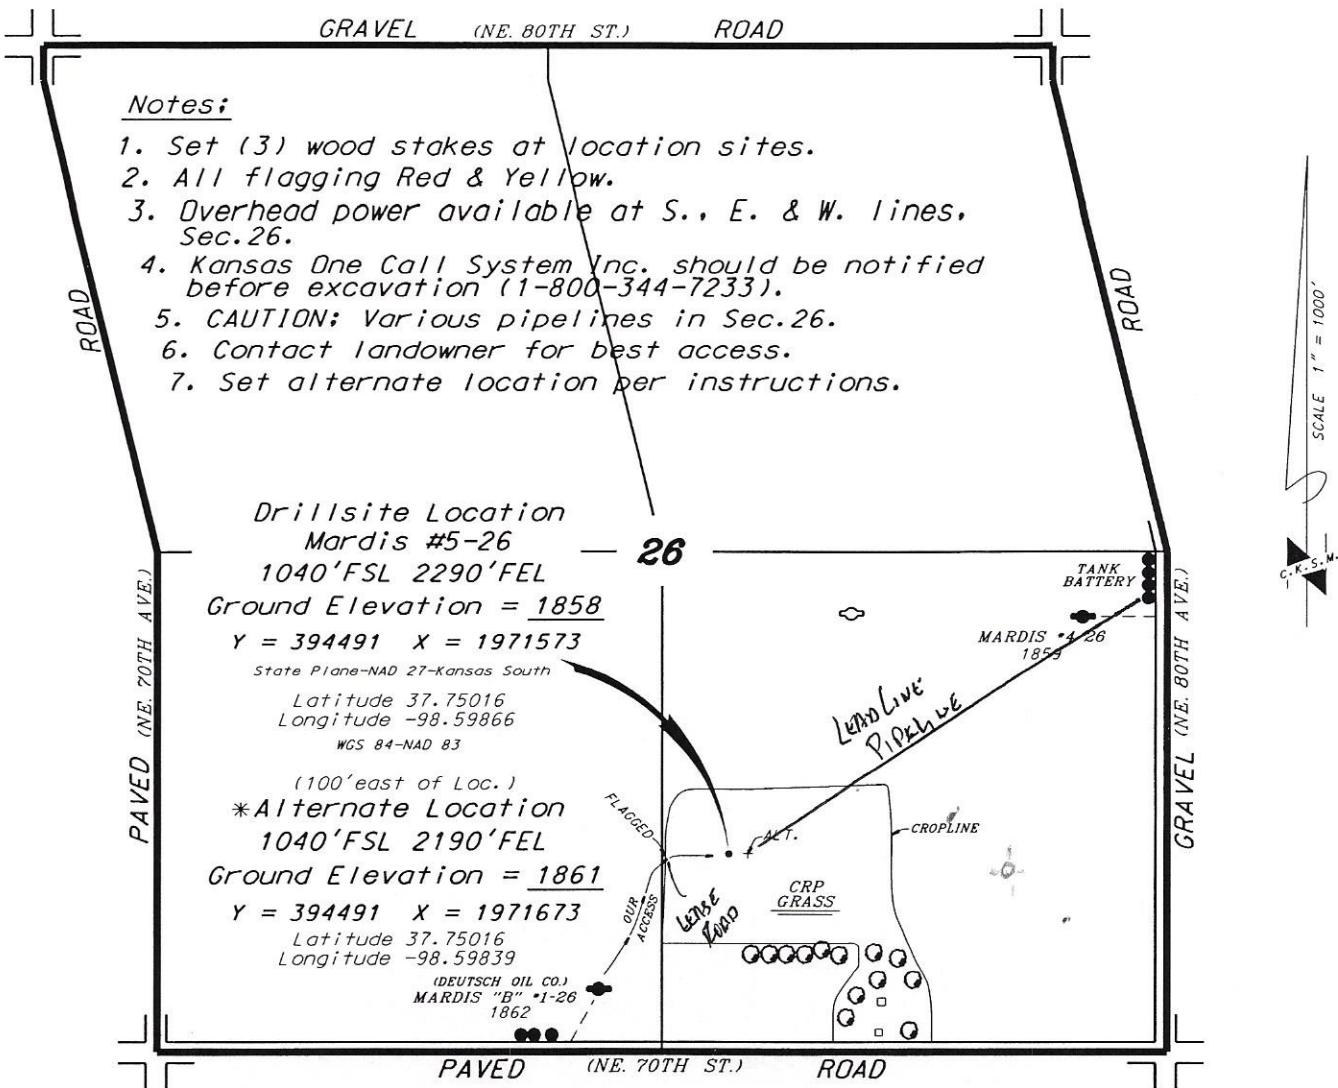

* Controlling data is based upon the best maps and photographs available to us and upon a regular section of land containing 640 acres.

* Approximate section lines were determined using the normal standard of care of oilfield surveyors practicing in the state of Kansas. The section corners, which establish the precise section lines, were not necessarily located, and the exact location of the drillsite location in the section is not guaranteed. Therefore, the operator securing this service and accepting this plat and all other documents herein shall agree to hold Central Kansas Oilfield Services, Inc., its officers and employees harmless from all legal costs and expenses and said entities released from any liability from incidental or consequential damages.

*Elevations derived from National Geodetic Vertical Datum.

Date November 12, 2019

CENTRAL KANSAS OILFIELD SERVICES, INC. (620)792-1977

