


The Loftis Company
 P.O. Box 7847
 Midland, Texas 79708
 432-682-8343

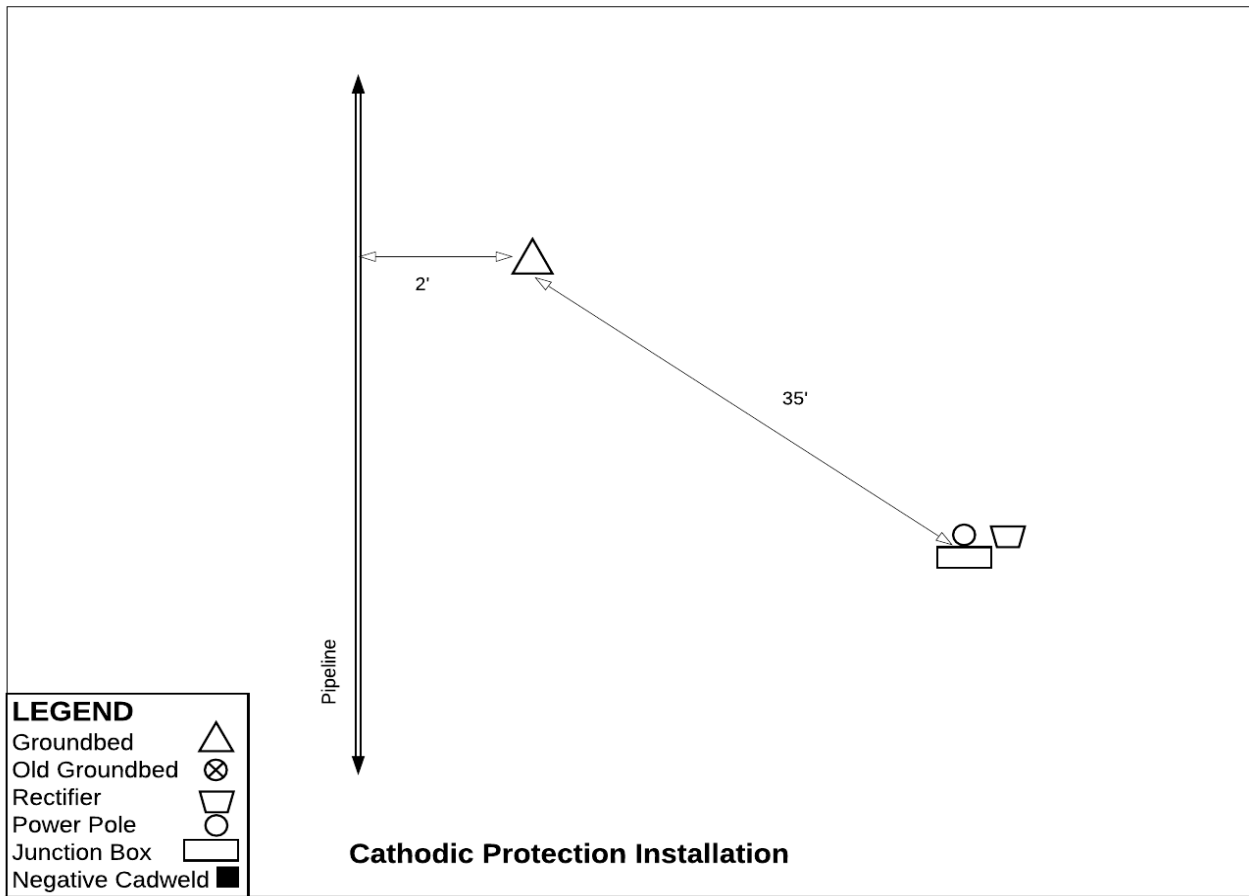

| | | |
|--|-------------------------|----------------------------------|
| CUSTOMER: DCP Midstream | | PO 466213 |
| LOCATION: Mobil Hickok 1 CP Unit, Off N Road S, Hickok, Grant Co., KS | | |
| DATE DRILLED: 9/10/019 | | DATE COMPLETED: 9/12/2019 |
| DRAWN BY: JM/MLT | APPROVED BY: MFL | DRAWING # 1 |