


395'

17

TANK BATTERY
1-2020
165'

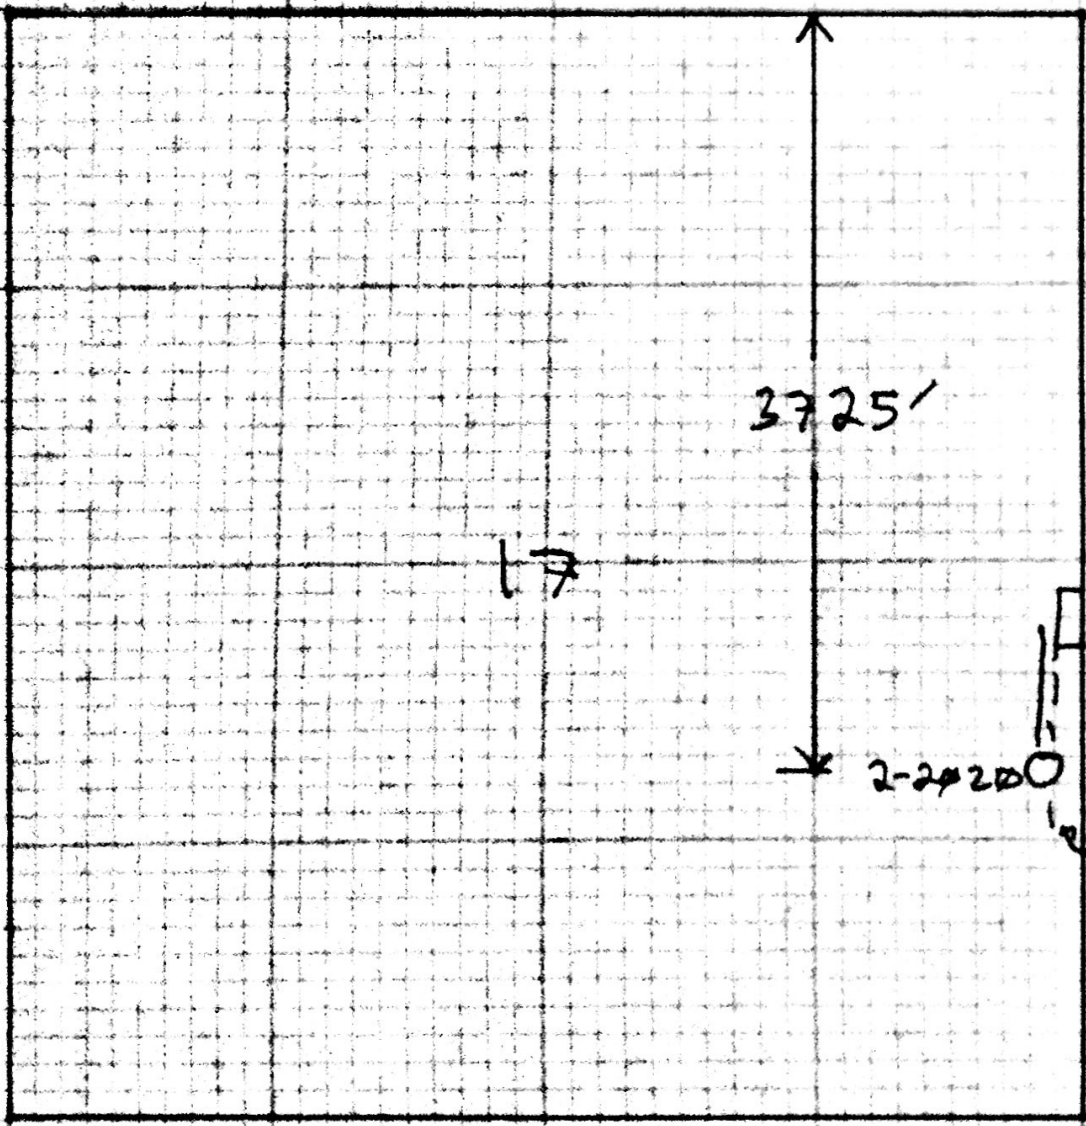


3725'

7

TRAIL
BATTERY

2-2#200

165'

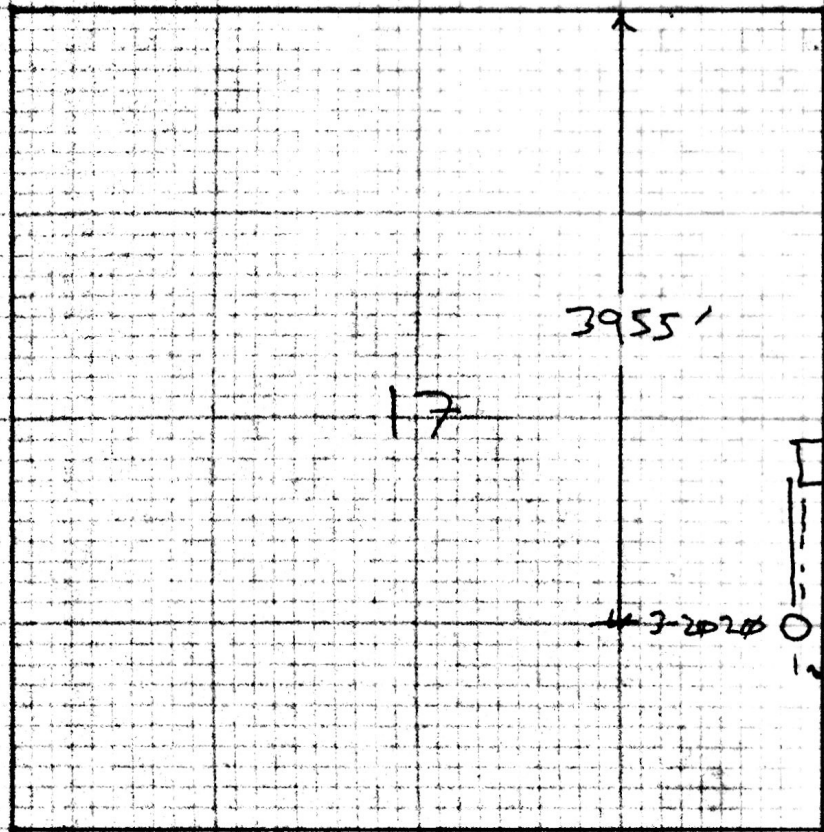

3955'

17

TANK
BATTERY

3-2020

165'