



395'

17

TANK BATTERY
1-2020
165'

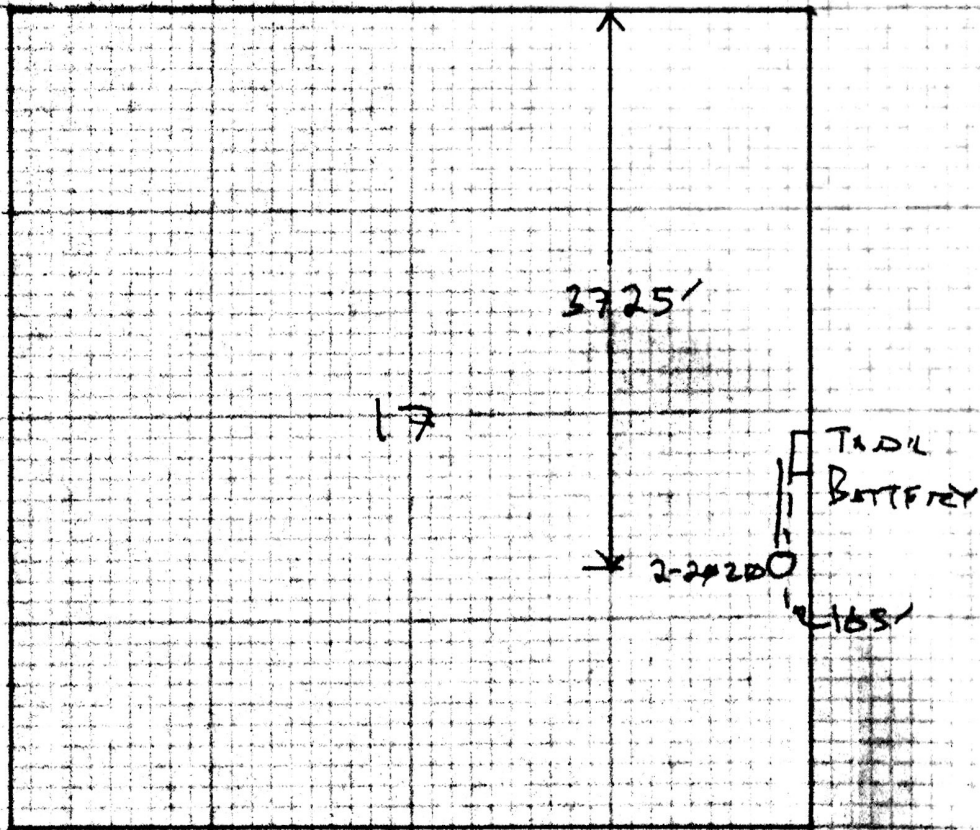

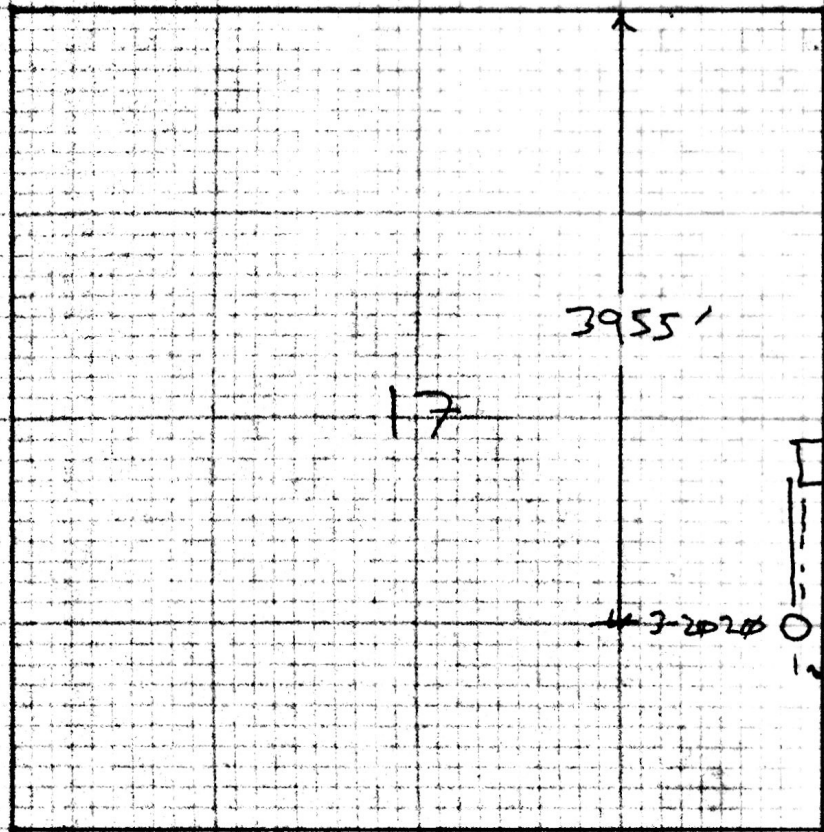

3955'

17

TANK
BATTERY

3-2020

165'