


395'

17

1-2020
TANK BATTERY
165'

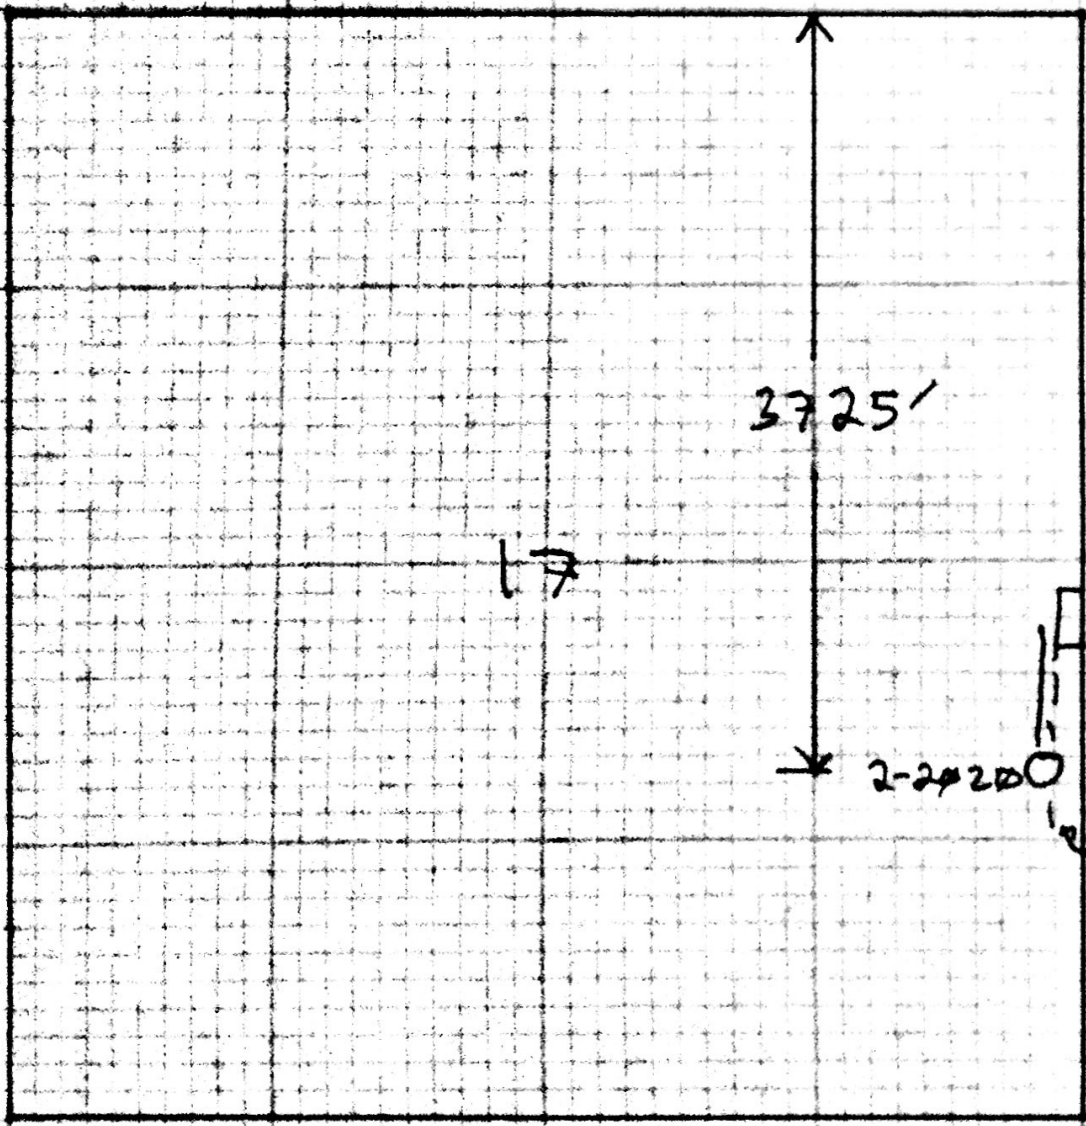


3725'

→

2-2#200

TRAIL
BATTERY

2165'

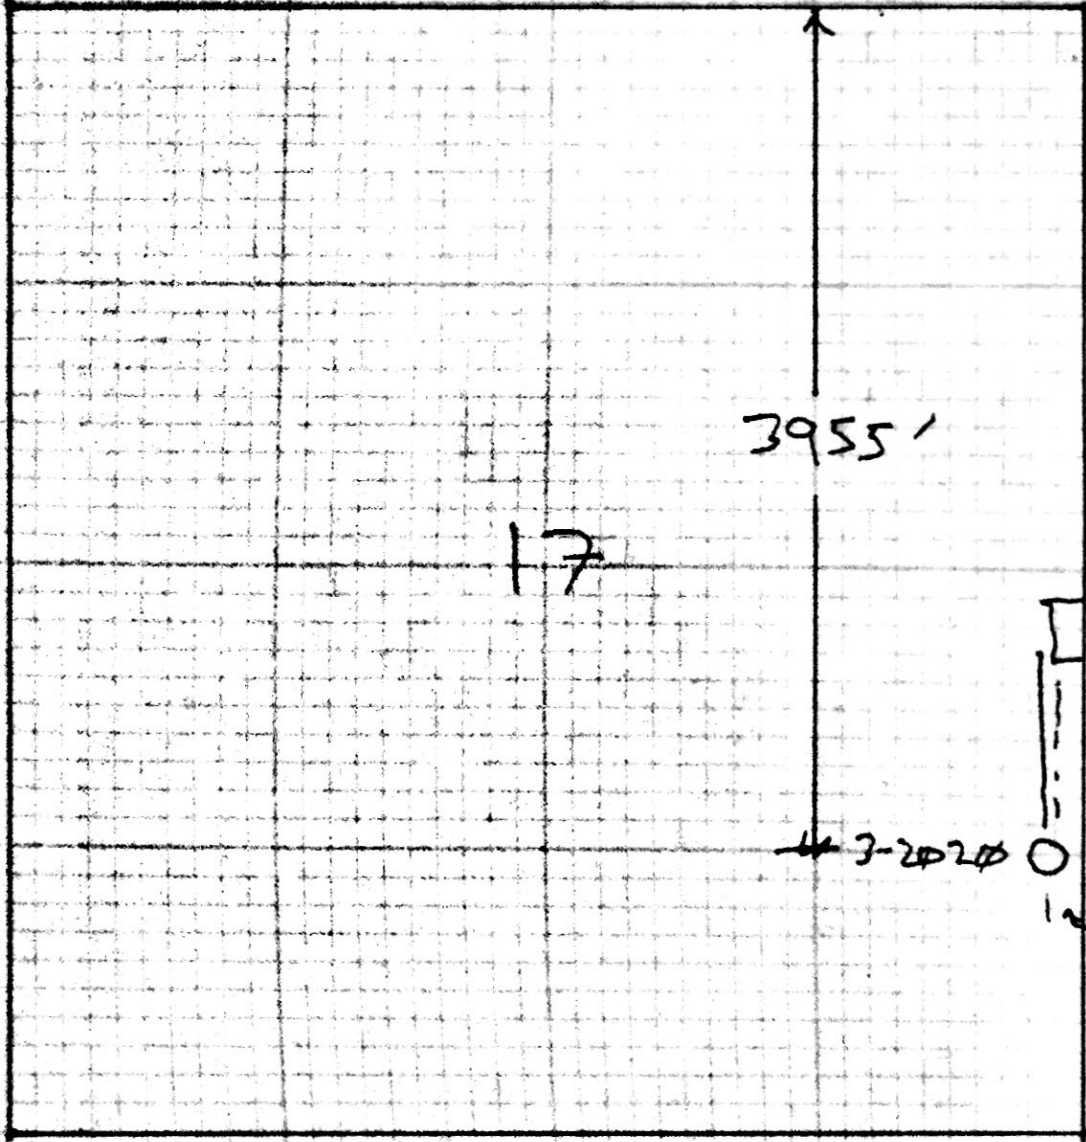

3955'

17

TANK
BATTERY

3-2020

165'