



Fall & Associates

Stake and Elevation Service

P.O. Box 222

Pretty Prairie, KS. 67570

785-243-7506

Date 10-15-19

Invoice Number 0913192

MURFIN DRILLING

2-19

Culwell 'H'

Operator

Number

Farm Name

Cheyenne-KS

19

2s

37w

1980'FSL 1550'FEL

County-State

S

T

R


Location


Murfin Drilling
250 N Water
Suite 300
Wichita, KS. 67202

Elevation 3396 Gr.

Ordered By: Shauna

Scale 1"=1000'

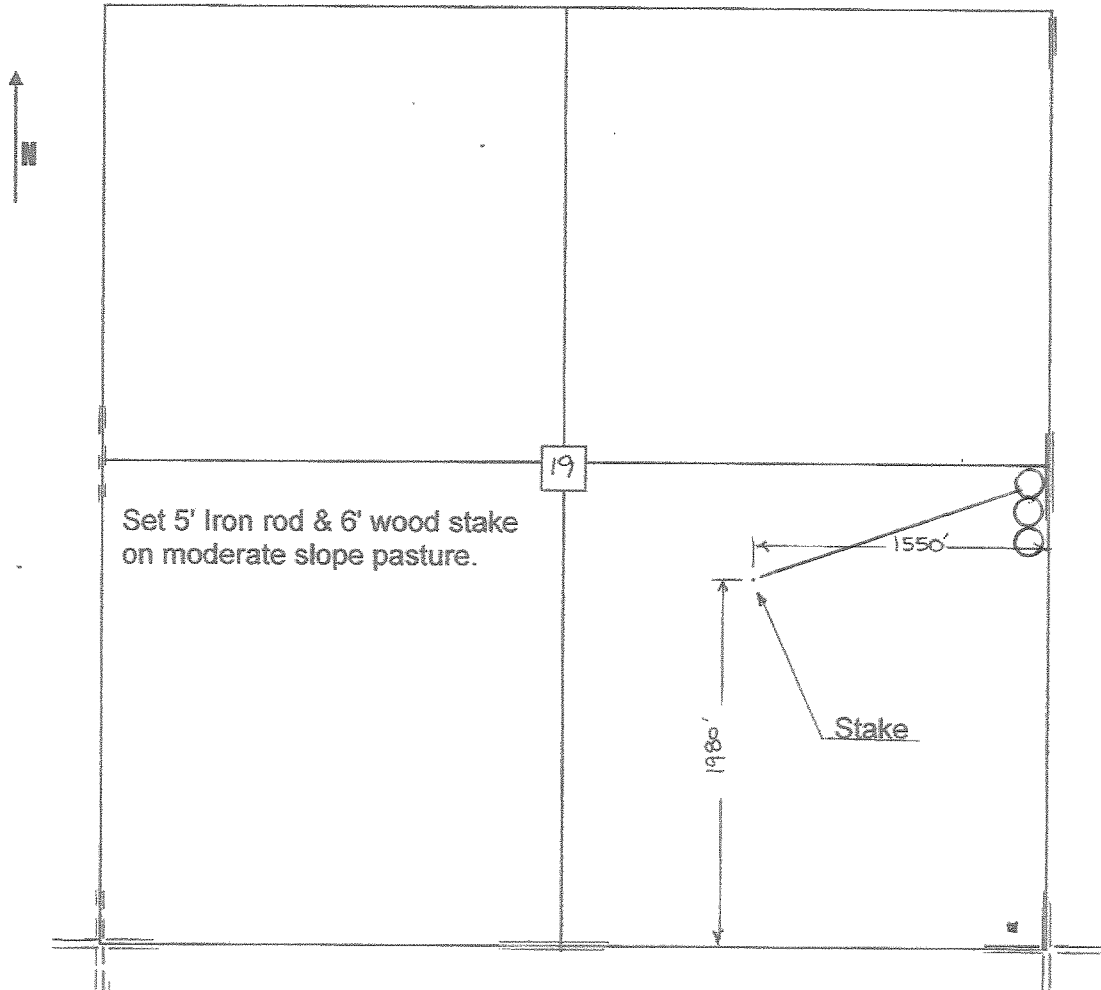

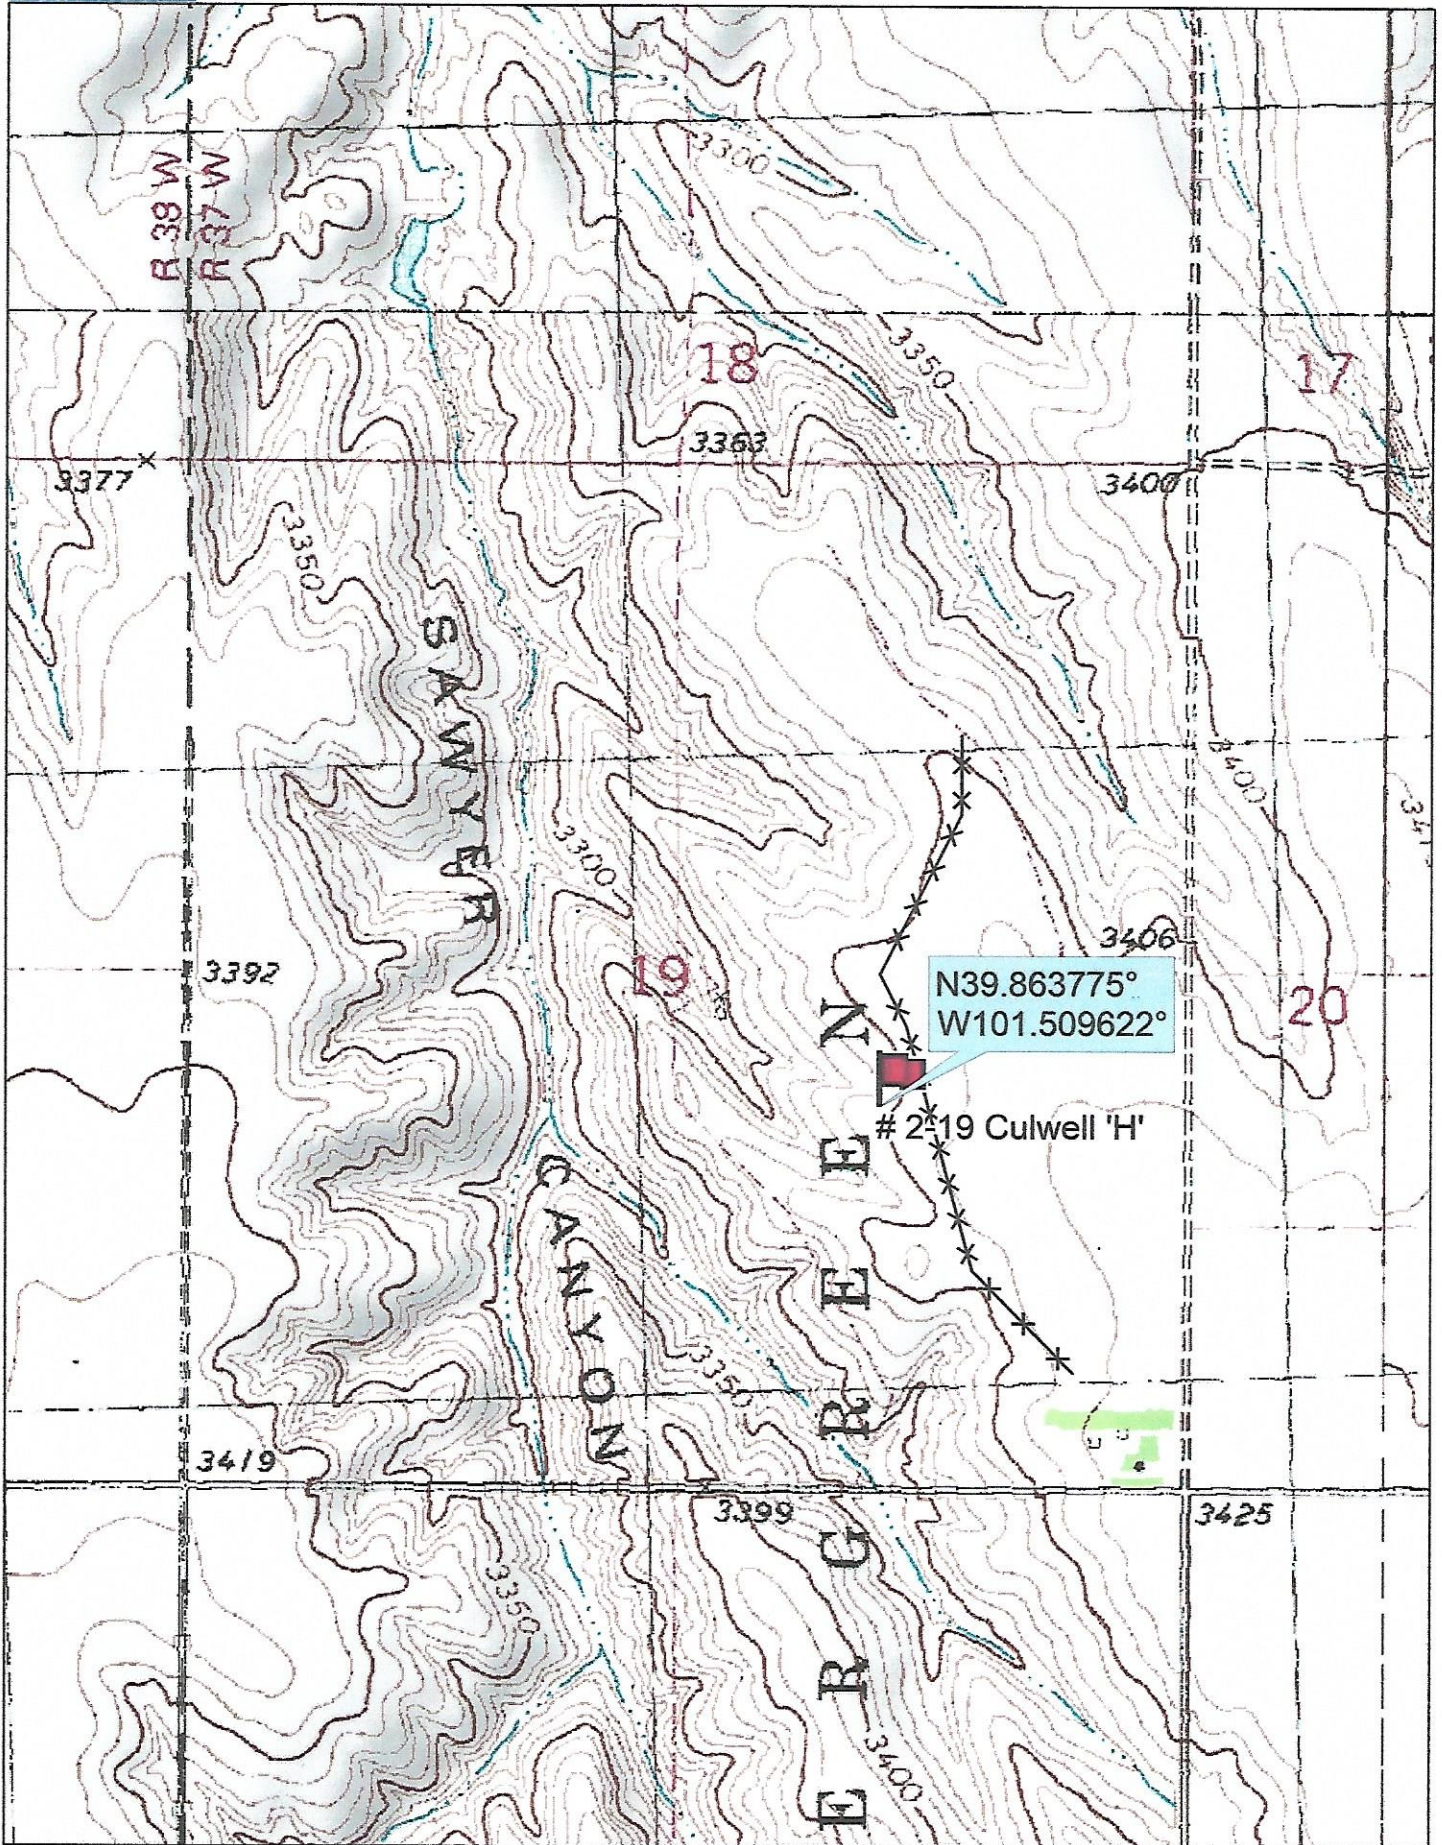

Data use subject to license.

© DeLorme. Topo North America™ 9.

www.delorme.com

