


John O. Farmer, Inc.  
Don #1 Location Map  
1/15/2020

Tank Battery

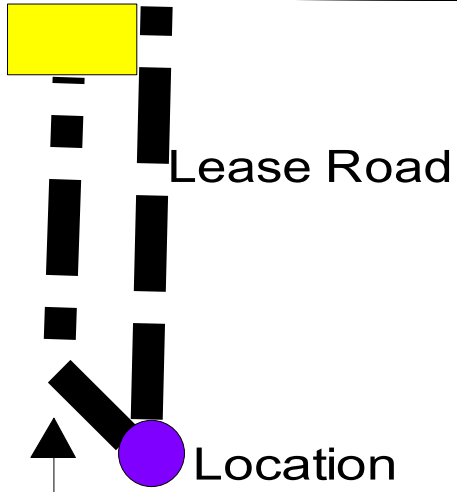

Electrical and  
Lead Line

28

