KANSAS CORPORATION COMMISSION OIL & GAS CONSERVATION DIVISION

All blanks must be complete

TEMPORARY ABANDONMENT WELL APPLICATION


OPERATOR: License#					API No. 15						
Name:					Spot Descr	iption:					
Address 1:					Sec Twp S. R E [] W						
Address 2:								feet from			
City:	State:	Zip:	+								
Contact Person:											
Phone:()								tion:		GL	КВ
Contact Person Email:								W			
Field Contact Person:					Well Type: (check one) [Oil Gas		Other:		
Field Contact Person Phone								ENHR Pe	ermit #:		
	.()						#:				
					Spud Date:			_ Date Shut-In: _			
	Conductor	Surfa	ace	Proc	duction	Interm	ediate	Liner		Tubing	
Size											
Setting Depth											
Amount of Cement											
Top of Cement											
Bottom of Cement											
Casing Fluid Level from Sur	face.		How Deter	mined?					Date:		
Casing Squeeze(s):				-							
Do you have a valid Oil & Ga	as Lease? 🗌 Yes	No									
Depth and Type: 🗌 Junk i	n Hole at	Tools in Ho	le at	_ Cas	ing Leaks:	Yes No	Depth of c	asing leak(s):			
											cement
Type Completion: ALT.			,					(depth)	• /	_ 5000 01	coment
Packer Type:	Size: .			_ Inch S	Set at:		Feet				
Total Depth:	Plug B	ack Depth:		P	lug Back Meth	od:		_			
Geological Date:											
	e Formation Top Formation Base			Completion Information							
Formation Name				- <i>(</i>		to	Foot o	r Onan Hala Inta	nyol	to	Fact
Formation Name		to	Feet	Perfor	ation Interval.			r Open Hole Inter	i vai	10	reel

Submitted Electronically

Do NOT Write in This Space - KCC USE ONLY	Date Tested:	Results:	Date Plugged:	Date Repaired:	Date Put Back in Service:
Review Completed by:		Comments:			
TA Approved: 🗌 Yes 🗌 De	enied Date:				

Mail to the Appropriate KCC Conservation Office:

	KCC District Office #1 - 210 E. Frontview, Suite A, Dodge City, KS 67801	Phone 620.682.7933
	KCC District Office #2 - 3450 N. Rock Road, Building 600, Suite 601, Wichita, KS 67226	Phone 316.337.7400
	KCC District Office #3 - 137 E. 21st St., Chanute, KS 66720	Phone 620.902.6450
	KCC District Office #4 - 2301 E. 13th Street, Hays, KS 67601-2651	Phone 785.261.6250

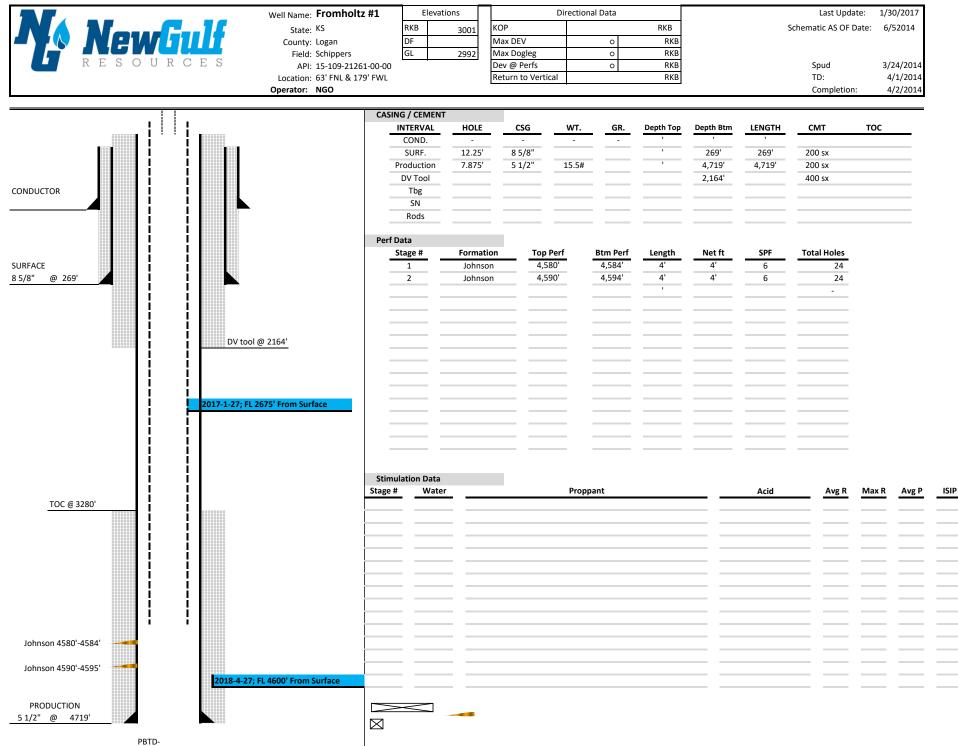

FG

Total Depth Drilled- 4720'

Conservation Division District Office No. 4 2301 E. 13th Street Hays, KS 67601-2651



Phone: 785-261-6250 Fax: 785-625-0564 http://kcc.ks.gov/

Susan K. Duffy, Chair Shari Feist Albrecht, Commissioner Dwight D. Keen, Commissioner Laura Kelly, Governor

March 30, 2020

Dillan Carney Culbreath Oil & Gas Company, Inc. 3501 S YALE AVE Suite B TULSA, OK 74135-8014

Re: Temporary Abandonment API 15-109-21261-00-00 FROMHOLTZ 1-14 NW/4 Sec.14-12S-32W Logan County, Kansas

Dear Dillan Carney:

Your application for Temporary Abandonment (TA) for the above-listed well is denied for the following reasons(s):

Lack of Lease

Pursuant to K.A.R. 82-3-111, the well must be plugged, or returned to service, or obtain temporary abandonment status by 04/29/2020.

This deadline does NOT override any compliance deadline given to you in any Commission Order.

You may contact me if you have any questions.

Sincerely, RICHARD WILLIAMS KCC DISTRICT 4