

Confidentiality Requested:

 Yes  NoKANSAS CORPORATION COMMISSION  
OIL & GAS CONSERVATION DIVISIONForm ACO-1  
January 2018Form must be Typed  
Form must be Signed  
All blanks must be FilledWELL COMPLETION FORM  
WELL HISTORY - DESCRIPTION OF WELL & LEASE

OPERATOR: License # \_\_\_\_\_

Name: \_\_\_\_\_

Address 1: \_\_\_\_\_

Address 2: \_\_\_\_\_

City: \_\_\_\_\_ State: \_\_\_\_\_ Zip: \_\_\_\_\_ + \_\_\_\_\_

Contact Person: \_\_\_\_\_

Phone: (\_\_\_\_\_) \_\_\_\_\_

CONTRACTOR: License # \_\_\_\_\_

Name: \_\_\_\_\_

Wellsite Geologist: \_\_\_\_\_

Purchaser: \_\_\_\_\_

Designate Type of Completion:

 New Well  Re-Entry  Workover Oil  WSW  SWD Gas  DH  EOR OG  GSW CM (Coal Bed Methane) Cathodic  Other (Core, Expl., etc.): \_\_\_\_\_

If Workover/Re-entry: Old Well Info as follows:

Operator: \_\_\_\_\_

Well Name: \_\_\_\_\_

Original Comp. Date: \_\_\_\_\_ Original Total Depth: \_\_\_\_\_

 Deepening  Re-perf.  Conv. to EOR  Conv. to SWD Plug Back  Liner  Conv. to GSW  Conv. to Producer Commingled Permit #: \_\_\_\_\_ Dual Completion Permit #: \_\_\_\_\_ SWD Permit #: \_\_\_\_\_ EOR Permit #: \_\_\_\_\_ GSW Permit #: \_\_\_\_\_Spud Date or  
Recompletion Date

Date Reached TD

Completion Date or  
Recompletion Date

API No.: \_\_\_\_\_

Spot Description: \_\_\_\_\_

\_\_\_\_ - \_\_\_\_ - \_\_\_\_ Sec. \_\_\_\_ Twp. \_\_\_\_ S. R. \_\_\_\_  East  West\_\_\_\_ Feet from  North /  South Line of Section\_\_\_\_ Feet from  East /  West Line of Section

Footages Calculated from Nearest Outside Section Corner:

 NE  NW  SE  SW

GPS Location: Lat: \_\_\_\_\_ (e.g. xx.xxxxx), Long: \_\_\_\_\_ (e.g. -xxx.xxxxx)

Datum:  NAD27  NAD83  WGS84

County: \_\_\_\_\_

Lease Name: \_\_\_\_\_ Well #: \_\_\_\_\_

Field Name: \_\_\_\_\_

Producing Formation: \_\_\_\_\_

Elevation: Ground: \_\_\_\_\_ Kelly Bushing: \_\_\_\_\_

Total Vertical Depth: \_\_\_\_\_ Plug Back Total Depth: \_\_\_\_\_

Amount of Surface Pipe Set and Cemented at: \_\_\_\_\_ Feet

Multiple Stage Cementing Collar Used?  Yes  No

If yes, show depth set: \_\_\_\_\_ Feet

If Alternate II completion, cement circulated from: \_\_\_\_\_

feet depth to: \_\_\_\_\_ w/ \_\_\_\_\_ sx cmt.

## Drilling Fluid Management Plan

(Data must be collected from the Reserve Pit)

Chloride content: \_\_\_\_\_ ppm Fluid volume: \_\_\_\_\_ bbls

Dewatering method used: \_\_\_\_\_

Location of fluid disposal if hauled offsite: \_\_\_\_\_

Operator Name: \_\_\_\_\_

Lease Name: \_\_\_\_\_ License #: \_\_\_\_\_

Quarter \_\_\_\_\_ Sec. \_\_\_\_\_ Twp. \_\_\_\_\_ S. R. \_\_\_\_\_  East  West

County: \_\_\_\_\_ Permit #: \_\_\_\_\_

## AFFIDAVIT

I am the affiant and I hereby certify that all requirements of the statutes, rules and regulations promulgated to regulate the oil and gas industry have been fully complied with and the statements herein are complete and correct to the best of my knowledge.

Submitted Electronically

## KCC Office Use ONLY

 Confidentiality Requested

Date: \_\_\_\_\_

 Confidential Release Date: \_\_\_\_\_ Wireline Log Received  Drill Stem Tests Received Geologist Report / Mud Logs Received UIC DistributionALT  I  II  III Approved by: \_\_\_\_\_ Date: \_\_\_\_\_

Operator Name: \_\_\_\_\_ Lease Name: \_\_\_\_\_ Well #: \_\_\_\_\_

Sec. \_\_\_\_\_ Twp. \_\_\_\_\_ S. R. \_\_\_\_\_  East  West County: \_\_\_\_\_

**INSTRUCTIONS:** Show important tops of formations penetrated. Detail all cores. Report all final copies of drill stems tests giving interval tested, time tool open and closed, flowing and shut-in pressures, whether shut-in pressure reached static level, hydrostatic pressures, bottom hole temperature, fluid recovery, and flow rates if gas to surface test, along with final chart(s). Attach extra sheet if more space is needed.

Final Radioactivity Log, Final Logs run to obtain Geophysical Data and Final Electric Logs must be emailed to [kcc-well-logs@kcc.ks.gov](mailto:kcc-well-logs@kcc.ks.gov). Digital electronic log files must be submitted in LAS version 2.0 or newer AND an image file (TIFF or PDF).

Drill Stem Tests Taken (Attach Additional Sheets)	<input type="checkbox"/> Yes <input type="checkbox"/> No	<input type="checkbox"/> Log	Formation (Top), Depth and Datum	<input type="checkbox"/> Sample
Samples Sent to Geological Survey	<input type="checkbox"/> Yes <input type="checkbox"/> No	Name	Top	Datum
Cores Taken	<input type="checkbox"/> Yes <input type="checkbox"/> No			
Electric Log Run	<input type="checkbox"/> Yes <input type="checkbox"/> No			
Geologist Report / Mud Logs	<input type="checkbox"/> Yes <input type="checkbox"/> No			
List All E. Logs Run:				

<b>CASING RECORD</b> <input type="checkbox"/> New <input type="checkbox"/> Used Report all strings set-conductor, surface, intermediate, production, etc.							
Purpose of String	Size Hole Drilled	Size Casing Set (In O.D.)	Weight Lbs. / Ft.	Setting Depth	Type of Cement	# Sacks Used	Type and Percent Additives

**ADDITIONAL CEMENTING / SQUEEZE RECORD**

Purpose:  <input type="checkbox"/> Perforate <input type="checkbox"/> Protect Casing <input type="checkbox"/> Plug Back TD <input type="checkbox"/> Plug Off Zone	Depth Top Bottom	Type of Cement	# Sacks Used	Type and Percent Additives

1. Did you perform a hydraulic fracturing treatment on this well?  Yes  No (If No, skip questions 2 and 3)
2. Does the volume of the total base fluid of the hydraulic fracturing treatment exceed 350,000 gallons?  Yes  No (If No, skip question 3)
3. Was the hydraulic fracturing treatment information submitted to the chemical disclosure registry?  Yes  No (If No, fill out Page Three of the ACO-1)

Date of first Production/Injection or Resumed Production/Injection:	Producing Method: <input type="checkbox"/> Flowing <input type="checkbox"/> Pumping <input type="checkbox"/> Gas Lift <input type="checkbox"/> Other (Explain) _____				
Estimated Production Per 24 Hours	Oil Bbls.	Gas Mcf	Water Bbls.	Gas-Oil Ratio	Gravity

DISPOSITION OF GAS:  <input type="checkbox"/> Vented <input type="checkbox"/> Sold <input type="checkbox"/> Used on Lease (If vented, Submit ACO-18.)		METHOD OF COMPLETION:  <input type="checkbox"/> Open Hole <input type="checkbox"/> Perf. <input type="checkbox"/> Dually Comp. <input type="checkbox"/> Commingled (Submit ACO-5) <input type="checkbox"/> Commingled (Submit ACO-4)			PRODUCTION INTERVAL: Top _____ Bottom _____	
--	--	--	--	--	--	--

Shots Per Foot	Perforation Top	Perforation Bottom	Bridge Plug Type	Bridge Plug Set At	Acid, Fracture, Shot, Cementing Squeeze Record (Amount and Kind of Material Used)	
TUBING RECORD: Size: Set At: Packer At:						

Form	ACO1 - Well Completion						
Operator	Southern Star Central Gas Pipeline, Inc.						
Well Name	C61262 02						
Doc ID	1515004						


Casing

Purpose Of String	Size Hole Drilled	Size Casing Set	Weight	Setting Depth	Type Of Cement	Number of Sacks Used	Type and Percent Additives
Surface	16.500	10.500	70	20	BENTONITE	27	WATER

BELLOW GROUND COMPLETION

Well Name: C61262

County: TREGO

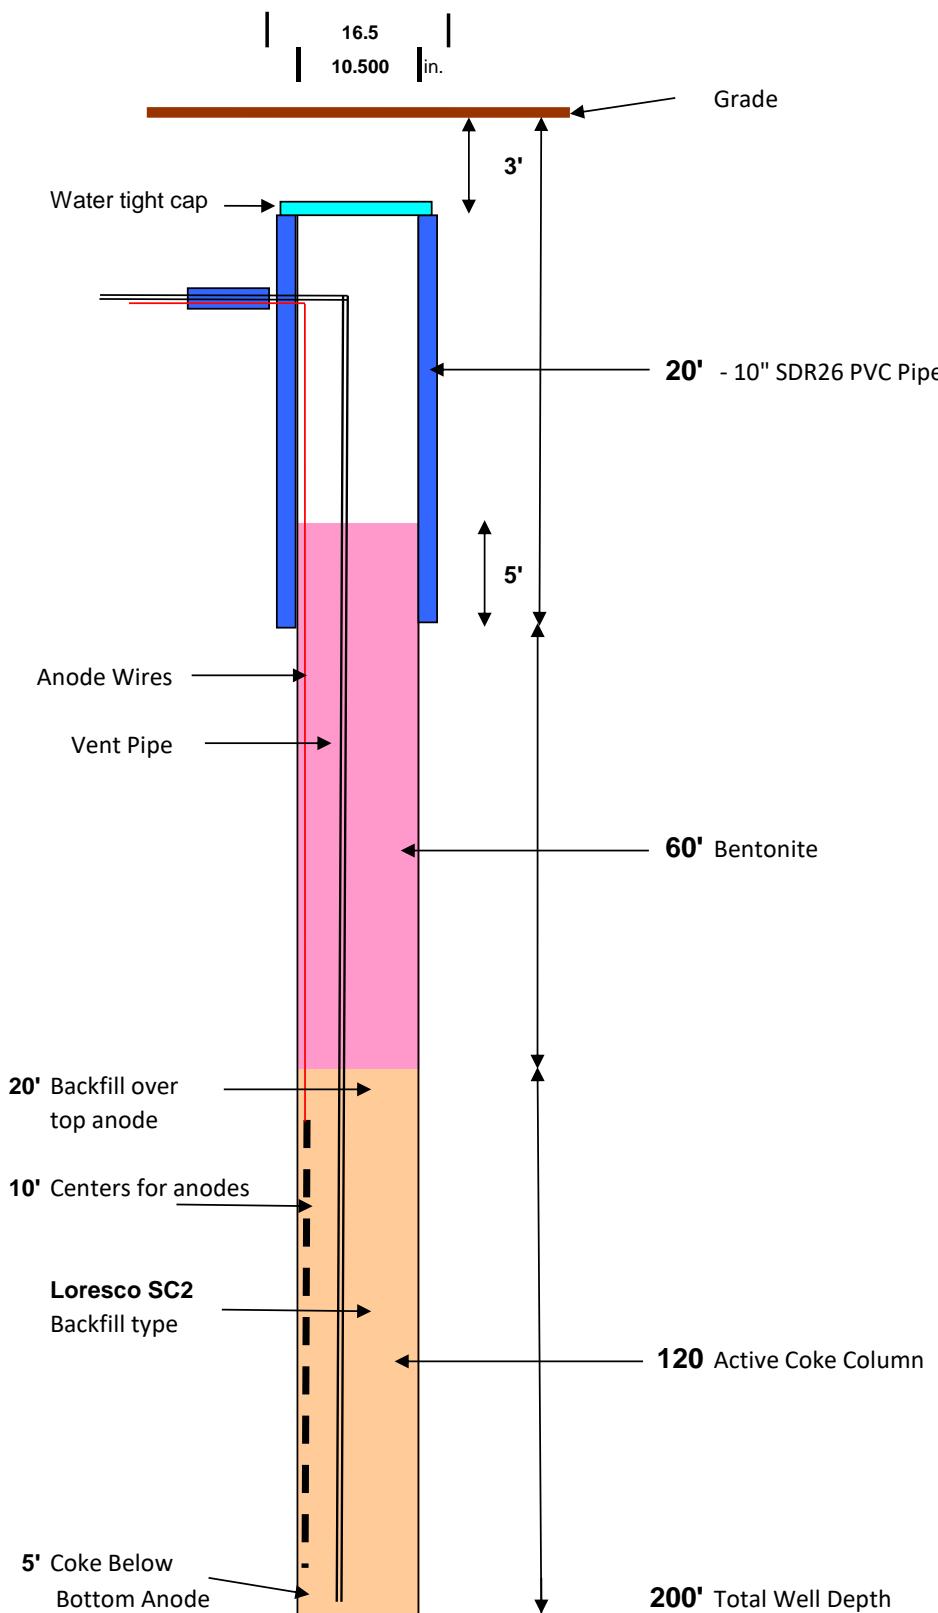



4520 State Hwy 136, Amarillo, TX 79108-7617 • tel. 806-383-5047 • fax 806-383-1716

Deep Well GroundBed Data:		Date:	04/28/20
Job Number:	SST23B-2018-KS	Drilling Contractor:	MCLEANS CP INSTALLATION, INC.
Company Name:	SOUTHERN STAR CENTRAL GAS PL	Facility/Line:	C61262
Subject:	DEEP WELL	State:	KS
Well Depth:	200 FT	County:	TREGO
Diameter:	10 IN	Other-Driller:	TR
Casing:	20 FT OF 10 IN	Drilling Method:	MUD
Type of Backfill:	SC2	Base Useable Water:	N/A
Anode Type:	1 SET OF 20 ANOTECH 2684		
GPS:	N38.92933655, W99.74319458	TEST VOLTS:	11.54
Remarks:	SST23A&B - 2 HOLES		

Drilling Log			Electrical Log			Anode Log		
Depth:	Formation Type:	Material:	BEFORE BACKFILL			AFTER BACKFILL		
			Volt	Anode	Anode #	Volt	Anode	Anode #
Depth	Formation Type	Material						
0'	SANDY CLAY	CASING/HOLEPLUG						
5'	SANDY CLAY	CASING/HOLEPLUG						
10'	SANDY CLAY	CASING/HOLEPLUG						
15'	SANDY CLAY	CASING/HOLEPLUG						
20	SANDY CLAY	CASING/HOLEPLUG						
25	SAND	HOLEPUG						
30	SAND	HOLEPUG						
35	SANDY CLAY	HOLEPUG						
40	SANDY CLAY	HOLEPUG						
45	SANDY CLAY	HOLEPUG						
50	SANDY CLAY	HOLEPUG	0.5					
55	SANDY CLAY	HOLEPUG						
60	SANDY CLAY	HOLEPUG	0.4					
65	SANDY CLAY	HOLEPUG						
70	SHALE	HOLEPUG	0.4					
75	SHALE	COKE						
80	SHALE	COKE	1.2					
85	SHALE	COKE						
90	SHALE	COKE	1.2					
95	SHALE	COKE						
100	SHALE	COKE	1.6					
105	SHALE	COKE			10			
110	SHALE	COKE	1.6					
115	SHALE	COKE			9			
120	SHALE	COKE	1.2					
125	SHALE	COKE			8			
130	SHALE	COKE	1.2					
135	SHALE	COKE			7			
140	SHALE	COKE	1.4					
145	SHALE	COKE			6			
150	SHALE	COKE	1.6					
155	SHALE	COKE			5			
160	SHALE	COKE	1.4					
165	SHALE	COKE			4			
170	SHALE	COKE	1.4					
175	SHALE	COKE			3			
180	SHALE	COKE	1.1					
185	SHALE	COKE			2			
190	SHALE	COKE	1.4					
195	SHALE	COKE			1			
200	SHALE	COKE	1.6					