## KANSAS CORPORATION COMMISSION OIL & GAS CONSERVATION DIVISION

All blanks must be complete

## TEMPORARY ABANDONMENT WELL APPLICATION


OPERATOR: License#					API No. 15					
					Spot Description:					
Address 1:						Se	ec	_ Twp S. R		E 🗌 W
Address 2:								feet from N /	=	
City:	State:	Zip:	+		feet from E / W Line of Section					
Contact Person:					GPS Location: Lat: , Long:    Datum:  NAD27    NAD27  NAD83    WGS84    County:					
Field Contact Person:								OG WSW O		
Field Contact Person Phone	e:()				SWD Permit #: ENHR Permit #:					
	( /					rage Permit #: _		Date Shut-In:		
					Spud Date:					
	Conductor	Surf	ace	Proc	luction	Intermedia	ate	Liner	Tubing	
Size										
Setting Depth										
Amount of Cement										
Top of Cement										
Bottom of Cement										
Casing Fluid Level from Sur	face:		How Deter	mined? _				Date	e:	
Casing Squeeze(s):	to w	/	sacks of ceme	ent,	<i>(top)</i> to	(bottom) w /		sacks of cement. Date	ə:	
Do you have a valid Oil & G	as Lease? 🗌 Yes	No								
Depth and Type: 🗌 Junk i	in Hole at	Tools in Ho	ole at	Cas	ing Leaks:	Yes No	Depth of ca	asing leak(s):		
										f cement
Type Completion: ALT			,					(depth)		i comon
Packer Type:										
Total Depth:	Plug B	ack Depth:		P	lug Back Metho	od:		-		
Geological Date:										
Formation Name	ion Name Formation Top Formation Base			Completion Information						
1	At:	to	Feet	Perfor	ation Interval _	to	Feet or	Open Hole Interval	to	Feet
1										

## Submitted Electronically

Do NOT Write in This Space - KCC USE ONLY	Date Tested:	Results:	Date Plugged:	Date Repaired:	Date Put Back in Service:
Review Completed by:		Comments:			
TA Approved: Yes D	enied Date:				

## Mail to the Appropriate KCC Conservation Office:

	KCC District Office #1 - 210 E. Frontview, Suite A, Dodge City, KS 67801	Phone 620.682.7933
	KCC District Office #2 - 3450 N. Rock Road, Building 600, Suite 601, Wichita, KS 67226	Phone 316.337.7400
	KCC District Office #3 - 137 E. 21st St., Chanute, KS 66720	Phone 620.902.6450
	KCC District Office #4 - 2301 E. 13th Street, Hays, KS 67601-2651	Phone 785.261.6250

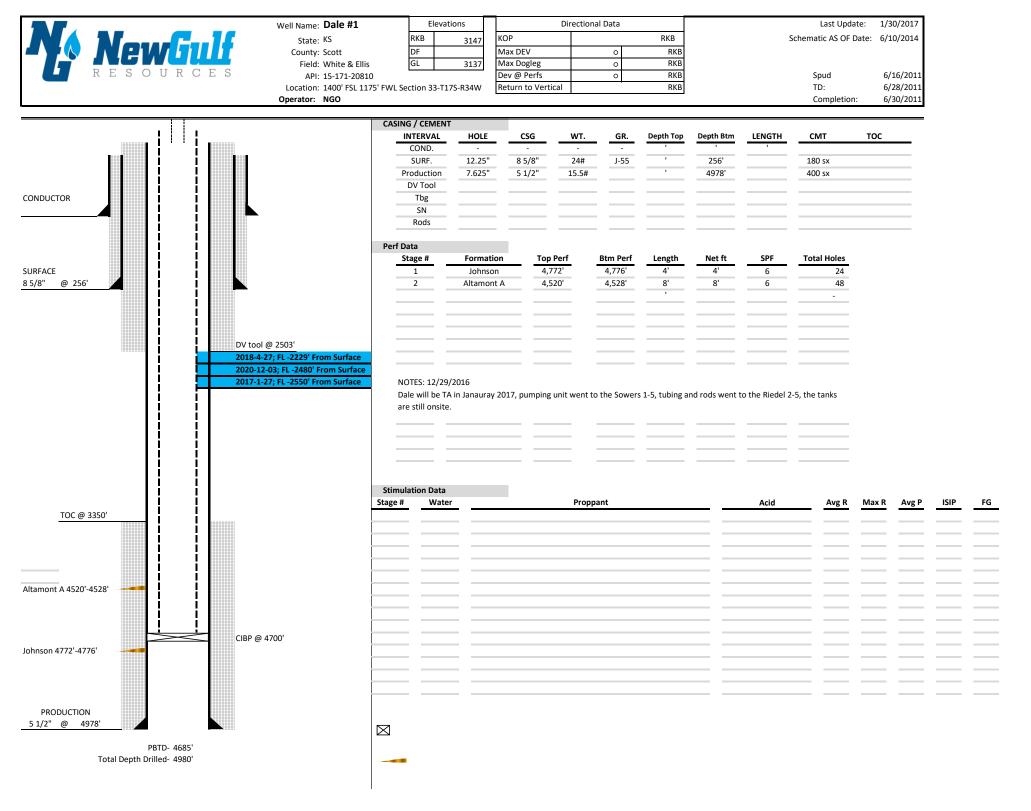

Conservation Division District Office No. 1 210 E. Frontview, Suite A Dodge City, KS 67801



Phone: 620-682-7933 http://kcc.ks.gov/

Susan K. Duffy, Chair Dwight D. Keen, Commissioner Andrew J. French, Commissioner Laura Kelly, Governor

December 08, 2020

Dillan Carney Culbreath Oil & Gas Company, Inc. 3501 S YALE AVE Suite B TULSA, OK 74135-8014

Re: Temporary Abandonment API 15-171-20810-00-00 DALE 1 SW/4 Sec.33-17S-34W Scott County, Kansas

Dear Dillan Carney:

"Your temporary abandonment (TA) application for the well listed above has been approved. In accordance with K.A.R. 82-3-111 the TA status of this well will expire 12/08/2021.

\* If you return this well to service or plug it, please notify the District Office.

\* If you sell this well you are required to file a Transfer of Operator form, T-1.

\* If the well will remain temporarily abandoned, you must submit a new TA application, CP-111, before 12/08/2021.

You may contact me at the number above if you have questions.

Very truly yours,

Michael Maier"