



Form	ACO1 - Well Completion
Operator	Tallgrass Interstate Gas Transmission, LLC
Well Name	PXP #53A WELL #1
Doc ID	1603227

Casing

Purpose Of String	Size Hole Drilled	Size Casing Set	Weight	Setting Depth	Type Of Cement	Number of Sacks Used	Type and Percent Additives
Surface	16	10	11.132	20	Bentonite Chips	18	100% Bentonite

NOT DRAWN TO SCALE

PXP #53A
2021 Deephole Groundbed Installation

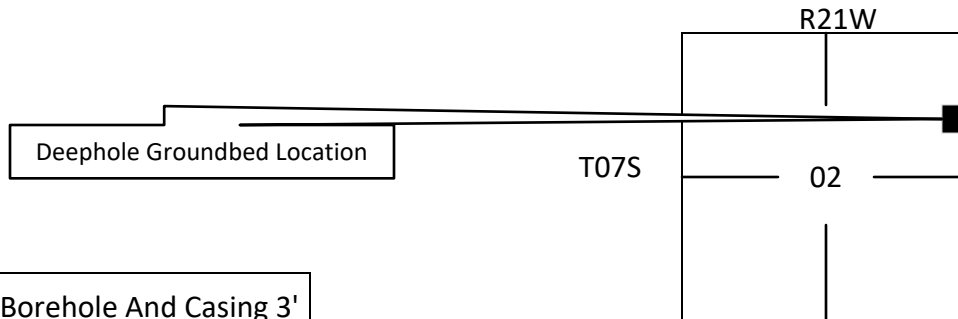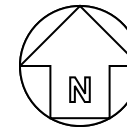

NE/4 02-T07S-R21W
Graham Co., KS

Well Bore Diagram

