

For KCC Use:
Effective Date:
District #
SGA? Yes No

KANSAS CORPORATION COMMISSION
OIL & GAS CONSERVATION DIVISION

Form C-1
March 2010

Form must be Typed
Form must be Signed
All blanks must be Filled

NOTICE OF INTENT TO DRILL

Must be approved by KCC five (5) days prior to commencing well

Form KSONA-1, Certification of Compliance with the Kansas Surface Owner Notification Act, MUST be submitted with this form.

Expected Spud Date: month day year

Spot Description:

OPERATOR: License#
Name:
Address 1:
Address 2:
City: State: Zip:
Contact Person:
Phone:

Sec. Twp. S. R. E W
feet from N / S Line of Section
feet from E / W Line of Section

Is SECTION: Regular Irregular?

(Note: Locate well on the Section Plat on reverse side)

CONTRACTOR: License#
Name:

County:

Lease Name: Well #:

Field Name:

Is this a Prorated / Spaced Field? Yes No

Target Formation(s):

Nearest Lease or unit boundary line (in footage):

Ground Surface Elevation: feet MSL

Water well within one-quarter mile: Yes No

Public water supply well within one mile: Yes No

Depth to bottom of fresh water:

Depth to bottom of usable water:

Surface Pipe by Alternate: I II

Length of Surface Pipe Planned to be set:

Length of Conductor Pipe (if any):

Projected Total Depth:

Formation at Total Depth:

Water Source for Drilling Operations:

Well Farm Pond Other:

DWR Permit #: (Note: Apply for Permit with DWR)

Will Cores be taken? Yes No

If Yes, proposed zone:

AFFIDAVIT

The undersigned hereby affirms that the drilling, completion and eventual plugging of this well will comply with K.S.A. 55 et. seq.

It is agreed that the following minimum requirements will be met:

- 1. Notify the appropriate district office prior to spudding of well;
2. A copy of the approved notice of intent to drill shall be posted on each drilling rig;
3. The minimum amount of surface pipe as specified below shall be set by circulating cement to the top; in all cases surface pipe shall be set through all unconsolidated materials plus a minimum of 20 feet into the underlying formation.
4. If the well is dry hole, an agreement between the operator and the district office on plug length and placement is necessary prior to plugging;
5. The appropriate district office will be notified before well is either plugged or production casing is cemented in;
6. If an ALTERNATE II COMPLETION, production pipe shall be cemented from below any usable water to surface within 120 DAYS of spud date. Or pursuant to Appendix "B" - Eastern Kansas surface casing order #133,891-C, which applies to the KCC District 3 area, alternate II cementing must be completed within 30 days of the spud date or the well shall be plugged. In all cases, NOTIFY district office prior to any cementing.

Submitted Electronically

For KCC Use ONLY
API # 15 -
Conductor pipe required feet
Minimum surface pipe required feet per ALT. I II
Approved by:
This authorization expires:
(This authorization void if drilling not started within 12 months of approval date.)
Spud date: Agent:

Remember to:

- File Certification of Compliance with the Kansas Surface Owner Notification Act (KSONA-1) with Intent to Drill;
- File Drill Pit Application (form CDP-1) with Intent to Drill;
- File Completion Form ACO-1 within 120 days of spud date;
- File acreage attribution plat according to field proration orders;
- Notify appropriate district office 48 hours prior to workover or re-entry;
- Submit plugging report (CP-4) after plugging is completed (within 60 days);
- Obtain written approval before disposing or injecting salt water.
- If well will not be drilled or permit has expired (See: authorized expiration date) please check the box below and return to the address below.

Well will not be drilled or Permit Expired Date:
Signature of Operator or Agent:

E
W

For KCC Use ONLY

API # 15 - _____

IN ALL CASES PLOT THE INTENDED WELL ON THE PLAT BELOW

In all cases, please fully complete this side of the form. Include items 1 through 5 at the bottom of this page.

Operator: _____
 Lease: _____
 Well Number: _____
 Field: _____
 Number of Acres attributable to well: _____
 QTR/QTR/QTR/QTR of acreage: _____ - _____ - _____ - _____

Location of Well: County: _____
 _____ feet from N / S Line of Section
 _____ feet from E / W Line of Section
 Sec. _____ Twp. _____ S. R. _____ E W


Is Section: Regular or Irregular

If Section is Irregular, locate well from nearest corner boundary.

Section corner used: NE NW SE SW

PLAT

Show location of the well. Show footage to the nearest lease or unit boundary line. Show the predicted locations of lease roads, tank batteries, pipelines and electrical lines, as required by the Kansas Surface Owner Notice Act (House Bill 2032).
 You may attach a separate plat if desired.

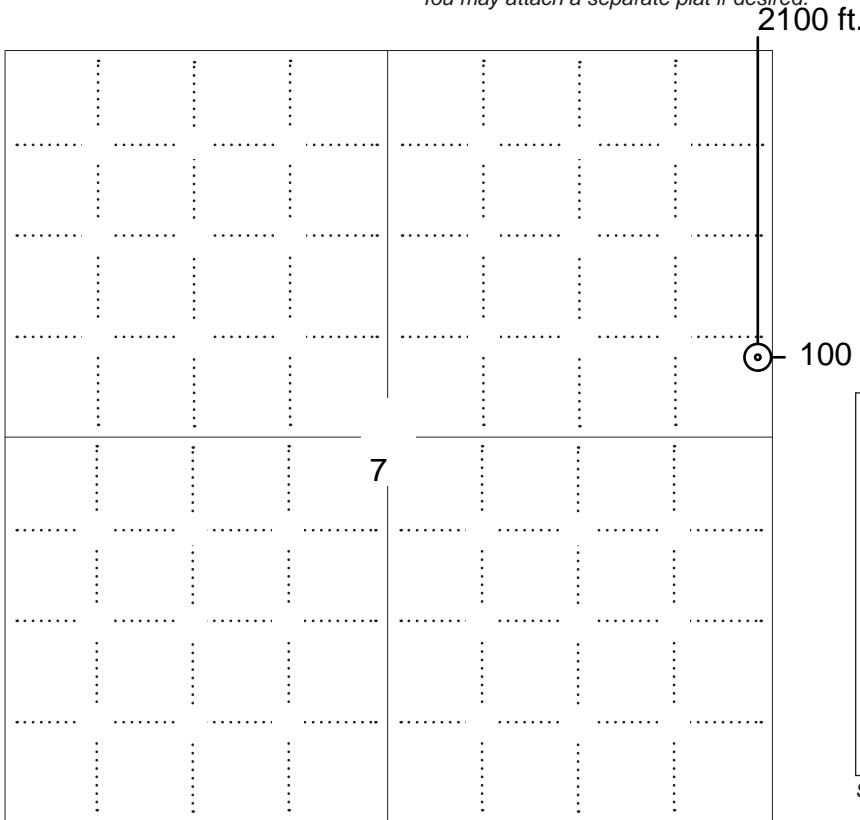

LEGEND

- Well Location
- Tank Battery Location
- Pipeline Location
- Electric Line Location
- Lease Road Location



NOTE: In all cases locate the spot of the proposed drilling locaton.

In plotting the proposed location of the well, you must show:

1. The manner in which you are using the depicted plat by identifying section lines, i.e. 1 section, 1 section with 8 surrounding sections, 4 sections, etc.
2. The distance of the proposed drilling location from the south / north and east / west outside section lines.
3. The distance to the nearest lease or unit boundary line (in footage).
4. If proposed location is located within a prorated or spaced field a certificate of acreage attribution plat must be attached: (C0-7 for oil wells; CG-8 for gas wells).
5. The predicted locations of lease roads, tank batteries, pipelines, and electrical lines.

**KANSAS CORPORATION COMMISSION
OIL & GAS CONSERVATION DIVISION
APPLICATION FOR SURFACE PIT**

Form CDP-1
May 2010
Form must be Typed

Submit in Duplicate

Operator Name: _____		License Number: _____	
Operator Address: _____			
Contact Person: _____		Phone Number: _____	
Lease Name & Well No.: _____		Pit Location (QQQQ): _____-_____-_____-_____	
Type of Pit: <input type="checkbox"/> Emergency Pit <input type="checkbox"/> Burn Pit <input type="checkbox"/> Settling Pit <input type="checkbox"/> Drilling Pit <input type="checkbox"/> Workover Pit <input type="checkbox"/> Haul-Off Pit <i>(If WP Supply API No. or Year Drilled)</i>		Pit is: <input type="checkbox"/> Proposed <input type="checkbox"/> Existing If Existing, date constructed: _____ Pit capacity: _____ (bbls)	
Is the pit located in a Sensitive Ground Water Area? <input type="checkbox"/> Yes <input type="checkbox"/> No		Chloride concentration: _____ mg/l <i>(For Emergency Pits and Settling Pits only)</i>	
Is the bottom below ground level? <input type="checkbox"/> Yes <input type="checkbox"/> No		Artificial Liner? <input type="checkbox"/> Yes <input type="checkbox"/> No	
How is the pit lined if a plastic liner is not used?		_____	
Pit dimensions (all but working pits): _____ Length (feet) _____ Width (feet) <input type="checkbox"/> N/A: Steel Pits Depth from ground level to deepest point: _____ (feet) <input type="checkbox"/> No Pit			
If the pit is lined give a brief description of the liner material, thickness and installation procedure.		Describe procedures for periodic maintenance and determining liner integrity, including any special monitoring.	
Distance to nearest water well within one-mile of pit: _____ feet Depth of water well _____ feet		Depth to shallowest fresh water _____ feet. Source of information: <input type="checkbox"/> measured <input type="checkbox"/> well owner <input type="checkbox"/> electric log <input type="checkbox"/> KDWR	
Emergency, Settling and Burn Pits ONLY: Producing Formation: _____ Number of producing wells on lease: _____ Barrels of fluid produced daily: _____ Does the slope from the tank battery allow all spilled fluids to flow into the pit? <input type="checkbox"/> Yes <input type="checkbox"/> No		Drilling, Workover and Haul-Off Pits ONLY: Type of material utilized in drilling/workover: _____ Number of working pits to be utilized: _____ Abandonment procedure: _____ _____ Drill pits must be closed within 365 days of spud date.	
Submitted Electronically			

KCC OFFICE USE ONLY			
		<input type="checkbox"/> Liner <input type="checkbox"/> Steel Pit <input type="checkbox"/> RFAC <input type="checkbox"/> RFAS	
Date Received: _____	Permit Number: _____	Permit Date: _____	Lease Inspection: <input type="checkbox"/> Yes <input type="checkbox"/> No

KANSAS CORPORATION COMMISSION
OIL & GAS CONSERVATION DIVISION

Form KSONA-1

July 2021

Form Must Be Typed

Form must be Signed

All blanks must be Filled

**CERTIFICATION OF COMPLIANCE WITH THE
KANSAS SURFACE OWNER NOTIFICATION ACT**

This form must be submitted with all Forms C-1 (Notice of Intent to Drill); CB-1 (Cathodic Protection Borehole Intent); T-1 (Request for Change of Operator Transfer of Injection or Surface Pit Permit); and CP-1 (Well Plugging Application). Any such form submitted without an accompanying Form KSONA-1 will be returned.

Select the corresponding form being filed: C-1 (Intent) CB-1 (Cathodic Protection Borehole Intent) T-1 (Transfer) CP-1 (Plugging Application)

OPERATOR: License # _____

Name: _____

Address 1: _____

Address 2: _____

City: _____ State: _____ Zip: _____ + _____

Contact Person: _____

Phone: (_____) _____ Fax: (_____) _____

Email Address: _____

Well Location:

____ - ____ - ____ - ____ Sec. ____ Twp. ____ S. R. ____ East West

County: _____

Lease Name: _____ Well #: _____

If filing a Form T-1 for multiple wells on a lease, enter the legal description of the lease below:

Surface Owner Information:

Name: _____

Address 1: _____

Address 2: _____

City: _____ State: _____ Zip: _____ + _____

When filing a Form T-1 involving multiple surface owners, attach an additional sheet listing all of the information to the left for each surface owner. Surface owner information can be found in the records of the register of deeds for the county, and in the real estate property tax records of the county treasurer.

If this form is being submitted with a Form C-1 (Intent) or CB-1 (Cathodic Protection Borehole Intent), you must supply the surface owners and the KCC with a plat showing the predicted locations of lease roads, tank batteries, pipelines, and electrical lines. The locations shown on the plat are preliminary non-binding estimates. The locations may be entered on the Form C-1 plat, Form CB-1 plat, or a separate plat may be submitted.

Select one of the following:

- I certify that, pursuant to the Kansas Surface Owner Notice Act (see Chapter 55 of the Kansas Statutes Annotated), I have provided the following to the surface owner(s) of the land upon which the subject well is or will be located: 1) a copy of the Form C-1, Form CB-1, Form T-1, or Form CP-1 that I am filing in connection with this form; 2) if the form being filed is a Form C-1 or Form CB-1, the plat(s) required by this form; and 3) my operator name, address, phone number, fax, and email address.
- I have not provided this information to the surface owner(s). I acknowledge that, because I have not provided this information, the KCC will be required to send this information to the surface owner(s). To mitigate the additional cost of the KCC performing this task, I acknowledge that I must provide the name and address of the surface owner by filling out the top section of this form and that I am being charged a \$30.00 handling fee, payable to the KCC, which is enclosed with this form.

If choosing the second option, submit payment of the \$30.00 handling fee with this form. If the fee is not received with this form, the KSONA-1 form and the associated Form C-1, Form CB-1, Form T-1, or Form CP-1 will be returned.

I Submitted Electronically

I



63U (Rev. 1993)

OIL AND GAS LEASE

AGREEMENT, Made and entered into the 4th day of April, 2019

by and between Klein Family Limited Partnership, a Kansas limited partnership AND The Revocable Inter Vivos Trust of Douglas L. Klein, dated September 9, 2012 AND The Revocable Inter Vivos Trust of Jan L. Klein, dated September 6, 2012

whose mailing address is 14000 Rd Q75 (for LP) or 17602 Rd W (for Trusts), Atwood, KS 67730 hereinafter called Lessor (whether one or more),

and Murfin Drilling Company, Inc

250 N. Water, Suite 300, Wichita, KS 67202

hereinafter called Lessee:

Lessor, in consideration of One and More Dollars (\$) 1.00 & More) in hand paid,

receipt of which is here acknowledged and of the royalties herein provided and of the agreements of the lessee herein contained, hereby grants, leases and lets exclusively unto lessee for the purpose of investigating, exploring by geophysical and other means, prospecting drilling, mining and operating for and producing oil, liquid hydrocarbons, all gases, and their respective constituent products, injecting gas, water, other fluids, and air into subsurface strata, laying pipe lines, storing oil, building tanks, power stations, telephone lines, and other structures and things thereon to produce, save, take care of, treat, manufacture, process, store and transport said oil, liquid hydrocarbons, gases and their respective constituent products and other products manufactured therefrom, and housing and otherwise caring for its employees, the following described land, together with any reversionary rights and after-acquired interest, therein situated in County of Rawlins State of Kansas Described as follows to wit:

Township 3 South, Range 34 West
Tract 1: Section 7: NW/4, SW/4, W/2SE/4, NE/4SE/4 & S/2NE/4
Tract 2: Section 8: N/2 lying South of the County Road & S/2
Tract 3: Section 17: NW/4, W/2NE/4 & NE/4NE/4

In Section XXX Township XXX Range XXX and containing 1.280 acres, more or less and all accretions thereto

Subject to the provisions herein contained, this lease shall remain in force for a term of Four (4) years from this date (called "primary term") and as long thereafter as oil, liquid hydrocarbons, gas or other respective constituent products, or any of them, is produced from said land or land with which said land is pooled

In consideration of the premises the said lessee covenants and agrees:

1st. To deliver to the credit of lessor, free of cost, in the pipe line to which lessee may connect wells on said land, the equal one-eighth (1/8) part of all oil produced and saved from the leased premises.

2nd. To pay lessor for gas of whatsoever nature or kind produced and sold, or used off the premises, or used in the manufacture of any products therefrom, one-eighth (1/8), at the market price at the well, (but, as to gas sold by lessee, in no event more than one-eighth (1/8) of the proceeds received by lessee from such sales), for the gas sold, used off the premises, or in the manufacture of products therefrom, said payments to be made monthly. Where gas from a well producing gas only is not sold or used, lessee may pay or tender as royalty One Dollar (\$1.00) per year per net mineral acre retained hereunder, and if such payment or tender is made it will be considered that gas is being produced within the meaning of the preceding paragraph.

This lease may be maintained during the primary term hereof without further payment or drilling operations. If the lessee shall commence to drill a well within the term of this lease or any extension thereof, the lessor shall have the right to drill such well to completion with reasonable diligence and dispatch, and if oil or gas, or either of them, be found in paying quantities, this lease shall continue and be in force with like effect as if such well had been completed within the term of years first mentioned.

If said lessor owns a less interest in the above described land than the entire and undivided fee simple estate therein, then the royalties herein provided for shall be paid the said lessor only in the proportion which lessor's interest bears to the whole and undivided fee.

Lessee shall have the right to use, free of cost, gas, oil and water produced on said land for lessee's operation thereon, except water from the wells of lessor.

When requested by lessor, lessee shall bury lessee's pipe lines below plow depth.

No well shall be drilled nearer than 200 feet to the house or barn now on said premises without written consent of lessor.

Lessee shall pay for damages caused by lessee's operations to growing crops on said land.

Lessee shall have the right at any time to remove all machinery and fixtures placed on said premises, including the right to draw and remove casing.

If the estate of either party hereto is assigned, and the privilege of assigning in whole or in part is expressly allowed, the covenants hereof shall extend to their heirs, executors, administrators, successors or assigns, but no change in the ownership of the land or assignment of rentals or royalties shall be binding on the lessee until after the lessee has been furnished with a written transfer or assignment or a true copy thereof. In case lessee assigns this lease, in whole or in part, lessee shall be relieved of all obligations with respect to the assigned portion or portions arising subsequent to the date of assignment.

Lessee may at any time execute and deliver to lessor or place of record a release or releases covering any portion or portions of the above described premises and thereby surrender this lease as to such portion or portions and be relieved of all obligations as to the acreage surrendered.

All express or implied covenants of this lease shall be subject to all Federal and State Laws, Executive Orders, Rules or Regulations, and this lease shall not be terminated, in whole or in part, nor lessee held liable in damages, for failure to comply therewith, if compliance is prevented by, or if such failure is the result of, any such Law, Order, Rule or Regulation.

Lessor hereby warrants and agrees to defend the title to the lands herein described, and agrees that the lessee shall have the right at any time to redeem for lessor, by payment any mortgages, taxes or other liens on the above described lands, in the event of default of payment by lessor, and be subrogated to the rights of the holder thereof, and the undersigned lessors, for themselves and their heirs, successors and assigns, hereby surrender and release all right of dower and homestead in the premises described herein, in so far as said right of dower and homestead may in any way affect the purposes for which this lease is made, as recited herein.

Lessee, at its option, is hereby given the right and power to pool or combine the acreage covered by this lease or any portion thereof with other land; lease or leases in the immediate vicinity thereof, when in lessee's judgment it is necessary or advisable to do so in order to properly develop and operate said lease premises so as to promote the conservation of oil, gas or other minerals in and under and that may be produced from said premises, such pooling to be of tracts contiguous to one another and to be into a unit or units not exceeding 80 acres each in the event of an oil well, or into a unit or units not exceeding 640 acres each in the event of a gas well. Lessee shall execute in writing and record in the conveyance records of the county in which the land herein leased is situated an instrument identifying and describing the pooled acreage. The entire acreage so pooled into a tract or unit shall be treated, for all purposes except the payment of royalties on production from the pooled unit, as if it were included in this lease. If production is found on the pooled acreage, it shall be treated as if production is had from this lease, whether the well or wells be located on the premises covered by this lease or not. In lieu of the royalties elsewhere herein specified, lessor shall receive on production from a unit so pooled only such portion of the royalty stipulated herein as the amount of his acreage placed in the unit or his royalty interest therein on an acreage basis bears to the total acreage so pooled in the particular unit involved.

• No seismic operations shall be conducted within 200ft of a water well without Lessor's consent. (S)

*See Addendum attached hereto and made a part hereof:

DLK J.L.K.

IN WITNESS WHEREOF, the undersigned execute this instrument as of the day and year first above written.

Witnesses:
Klein Family Limited Partnership

By: Kendall L. Klein
Kendall L. Klein, Trustee of The Revocable Inter Vivos Trust of Kendall L. Klein, dated July 5, 2012, General Partner of the Klein Family Limited Partnership

By: Dee Lores F. Klein
Kendall L. Klein, Trustee of The Revocable Inter Vivos Trust of DeeLores F. Klein, dated July 5, 2012, General Partner of the Klein Family Limited Partnership

By: Dee Lores F. Klein
DeeLores F. Klein, Trustee of The Revocable Inter Vivos Trust of Kendall L. Klein, dated July 5, 2012, General Partner of the Klein Family Limited Partnership a/k/a DeeLores Klein, Trustee

By: Dee Lores F. Klein
DeeLores F. Klein, Trustee of The Revocable Inter Vivos Trust of DeeLores F. Klein, dated July 5, 2012, General Partner of the Klein Family Limited Partnership a/k/a DeeLores Klein, Trustee

By: Douglas L. Klein
Douglas L. Klein, Trustee of The Revocable Inter Vivos Trust of Douglas L. Klein, dated September 6, 2012, General Partner of the Klein Family Limited Partnership

By: Jan L. Klein
Jan L. Klein, Trustee of The Revocable Inter Vivos Trust of Douglas L. Klein, dated September 6, 2012, General Partner of the Klein Family Limited Partnership

By: Douglas L. Klein
Douglas L. Klein, Trustee of The Revocable Inter Vivos Trust of Jan L. Klein, dated September 6, 2012, General Partner of the Klein Family Limited Partnership

By: Jan L. Klein
Jan L. Klein, Trustee of The Revocable Inter Vivos Trust of Jan L. Klein, dated September 6, 2012, General Partner of the Klein Family Limited Partnership

The Revocable Inter Vivos Trust of Douglas L. Klein, dated September 6, 2012

By: Douglas L. Klein
Douglas L. Klein, Trustee of The Revocable Inter Vivos Trust of Douglas L. Klein, dated September 6, 2012

By: Jan L. Klein
Jan L. Klein, Trustee of The Revocable Inter Vivos Trust of Douglas L. Klein, dated September 6, 2012

The Revocable Inter Vivos Trust of Jan L. Klein, dated September 6, 2012

By: Douglas L. Klein
Douglas L. Klein, Trustee of The Revocable Inter Vivos Trust of Jan L. Klein, dated September 6, 2012

By: Jan L. Klein
Jan L. Klein, Trustee of The Revocable Inter Vivos Trust of Jan L. Klein, dated September 6, 2012


ACKNOWLEDGEMENT FOR INDIVIDUAL (Kans., Okla., and Colo.)

STATE OF KANSAS)
COUNTY OF RAWLINS) ss.

Before me, the undersigned, a Notary Public, within and for said county and state on this 4th day of April, 2019, personally appeared, Kendall L. Klein & DeeLores F. Klein, Trustees of The Revocable Inter Vivos Trust of Kendall L. Klein, dated July 5, 2012, General Partner of the Klein Family Limited Partnership & Kendall L. Klein & DeeLores F. Klein, Trustees of The Revocable Inter Vivos Trust of DeeLores F. Klein, dated July 5, 2012, General Partner of the Klein Family Limited Partnership, to me personally known to be the identical person(s) who executed the within and foregoing instrument and acknowledged to me that he/she/they executed the same as a free and voluntary act and deed for the uses and purpose therein set forth.

IN WITNESS WHEREOF, I have hereunto set my hand and official seal the day and year last above written.

My commission expires 7/9/21

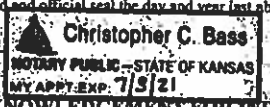

C.C.B.
Christopher C. Bass, Notary Public

ACKNOWLEDGEMENT FOR INDIVIDUAL (Kans., Okla., and Colo.)

STATE OF KANSAS)
COUNTY OF RAWLINS) ss.

Before me, the undersigned, a Notary Public, within and for said county and state on this 4th day of April, 2019, personally appeared, Douglas L. Klein & Jan L. Klein, Trustees of The Revocable Inter Vivos Trust of Douglas L. Klein, dated September 6, 2012, General Partner of the Klein Family Limited Partnership & Douglas L. Klein & Jan L. Klein, Trustees of The Revocable Inter Vivos Trust of Jan L. Klein, dated September 6, 2012, General Partner of the Klein Family Limited Partnership & Douglas L. Klein & Jan L. Klein, Trustees of The Revocable Inter Vivos Trust of Douglas L. Klein, dated September 6, 2012 & Douglas L. Klein & Jan L. Klein, Trustees of The Revocable Inter Vivos Trust of Jan L. Klein, dated September 6, 2012, to me personally known to be the identical person(s) who executed the within and foregoing instrument and acknowledged to me that he/she/they executed the same as a free and voluntary act and deed for the uses and purpose therein set forth.

IN WITNESS WHEREOF, I have hereunto set my hand and official seal the day and year last above written.

My commission expires 7/9/21



C.C.B.
Christopher C. Bass, Notary Public

Exhibits or Recordation Stamp:

No. _____
OIL AND GAS LEASE
FROM _____
TO _____
Date _____ Twp. _____ Rge _____
Section _____
No. of Acres _____ Term _____
County _____
STATE OF _____
County _____
This instrument was filed for record on the _____ day of _____
at _____ o'clock _____ M., and duly recorded
in Book _____ Page _____ of in the
records of this office _____
Register of Deeds
By _____
When recorded, return to _____

Addendum

Attached to Oil and Gas Lease dated the 4th day of April, 2019, by and between, Klein Family Limited Partnership, a Kansas limited partnership AND The Revocable Inter Vivos Trust of Douglas L. Klein, dated September 6, 2012, AND The Revocable Inter Vivos Trust of Jan L. Klein, dated September 6, 2012, hereinafter collectively referred to as Lessors, and Murfin Drilling Company, Inc., as Lessee.

Township 3 South, Range 34 West

Tract 1: Section 7: NW/4, SW/4, W/2SE/4, NE/4NE/4 & S/2NE/4

Tract 2: Section 8: N/2 lying South of the County Road & S/2

Tract 3: Section 17: NW/4, W/2NE/4 & NE/4NE/4

1. When preparing development locations, the topsoil shall be segregated to be replaced on the surface upon completion of drilling activities. Any terraces driven over or altered for drilling or tank locations shall be restored to original height and contour as nearly as is practicable.
2. In the event of drilling operations on said land, Lessee or assigns agree to bury pipe lines below plow depth. Lessee or assigns agree to backfill all slush pits, level the location and restore the surface as nearly as is practicable. Lessee or assigns agrees to pay for all damages of any nature arising from its operations on the above land.
3. It is understood and agreed that upon the termination of production on the Lease, all equipment of Lessee shall be removed within six (6) months and all sites shall be restored to their original condition as nearly as is practicable.
4. Upon the completion of any drilling operations or any seismographic testing the Lessee shall leave no waste material, litter or other debris on said premises and shall restore said premises as nearly as practicable to the condition the premises were in prior to Lessee's operations. Lessee shall not conduct seismic operations from May 1st to November 1st, without Lessor's consent.
5. A sufficient dike shall be placed around tank batteries. Also, tank batteries and pumping equipment units shall be fenced to restrain cattle in pastures or on ground that Lessor grazes cattle. Lessor shall not be held liable for any damage to Lessee's equipment caused by Lessor's livestock. J.L.K. DLK
6. Lessee shall consult with Lessor in regard to the route of ingress and egress on said premises for the purpose of drilling and production.
7. Lessee shall pay to Lessor, a minimum of 1,500.00 per location for damages caused by Lessee's drilling operations.

8. Each of the separately designated tracts to this lease shall be treated for all purposes as a separate and distinct lease. DLK CB J.L.K.

Klein Family Limited Partnership

By: Kendall L. Klein
Kendall L. Klein, Trustee of The Revocable Inter Vivos Trust of Kendall L. Klein, dated July 5, 2012, General Partner of the Klein Family Limited Partnership

By: DeeLore F. Klein
DeeLore F. Klein, Trustee of The Revocable Inter Vivos Trust of Kendall L. Klein, dated July 5, 2012, General Partner of the Klein Family Limited Partnership

By: Kendall F. Klein
Kendall L. Klein, Trustee of The Revocable Inter Vivos Trust of DeeLore F. Klein, dated July 5, 2012, General Partner of the Klein Family Limited Partnership

By: DeeLore F. Klein
DeeLore F. Klein, Trustee of The Revocable Inter Vivos Trust of DeeLore F. Klein, dated July 5, 2012, General Partner of the Klein Family Limited Partnership

By: Douglas L. Klein
Douglas L. Klein, Trustee of The Revocable Inter Vivos Trust of Douglas L. Klein, dated September 6, 2012, General Partner of the Klein Family Limited Partnership

By: Jan L. Klein
Jan L. Klein, Trustee of The Revocable Inter Vivos Trust of Douglas L. Klein, dated September 6, 2012, General Partner of the Klein Family Limited Partnership

By: Douglas L. Klein
Douglas L. Klein, Trustee of The Revocable Inter Vivos Trust of Jan L. Klein, dated September 6, 2012, General Partner of the Klein Family Limited Partnership

By: Jan L. Klein
Jan L. Klein, Trustee of The Revocable Inter Vivos Trust of Jan L. Klein, dated September 6, 2012, General Partner of the Klein Family Limited Partnership

The Revocable Inter Vivos Trust of Douglas L. Klein, dated September 6, 2012

By: Douglas L. Klein
Douglas L. Klein, Trustee of The Revocable Inter Vivos Trust of Douglas L. Klein, dated September 6, 2012

By: Jan L. Klein
Jan L. Klein, Trustee of The Revocable Inter Vivos Trust of Douglas L. Klein, dated September 6, 2012

The Revocable Inter Vivos Trust of Jan L. Klein, dated September 6, 2012

By: Douglas L. Klein
Douglas L. Klein, Trustee of The Revocable Inter Vivos Trust of Jan L. Klein, dated September 6, 2012

By: Jan L. Klein
Jan L. Klein, Trustee of The Revocable Inter Vivos Trust of Jan L. Klein, dated September 6, 2012

#55246 STATE OF KANSAS, RAWLINS COUNTY SS:
This instrument was filed for record this 2nd day of May 2019 at 9:00 AM and recorded in book X-110 of Misc. page 291.

Carolyn Marshall
Carolyn Marshall-Register of Deeds



00-03s-34w-2022
CRD NO.

00-03s-34w
DMT NO.

PRO-STAKE

LLC

Construction Site Staking

P.O. Box 2324 Garden City, Kansas 67846
Office/Fax: (620) 276-6159 – Cell: (620) 272-1499
burt@prostakellc.com

14984A
INVOICE NO.



Murfin Drilling Company, Inc.
OPERATOR

Rawlins County, KS
COUNTY

Klein Unit #1-7
LEASE NAME

2100' FNL - 100' FEL
LOCATION SPOT

2931.2'
GR ELEVATION

39.808131936
NAD 83 LAT

101.167459948
NAD 83 LONG

07 03s 34w
Sec. Twp. Rng.

SCALE: 1" = 1000'
DATE STAKED: March 16th, 2022
MEASURED BY: Pierce R.
DRAWN BY: Pierce R.
AUTHORIZED BY: Sarah K.
DATE REVISED:



LEGEND


- ⊙ irr. well
- ⊕ water hydrant
- ⊙ tank battery
- ⊙ staked loc.
- ⊗ prod. well / aband. well
- house
- building
- G— gas line
- W— water line
- E— transmission powerline
- 3 phase powerline
- single phase powerline
- x—x—x— fence
- ▬▬▬▬ gravel / sand rd.
- ▬▬▬▬ gravel trail / lease rd.
- ▬▬▬▬ dirt rd.
- ▬▬▬▬ dirt trail / lease rd.
- ▬▬▬▬ Hwy / blacktop rd.

DIRECTIONS: From Atwood, KS at the intersection of Hwy. 36 & Hwy. 25 – Now go 4.8 miles SW on on Hwy. 36 – Now go 0.6 miles North on unknown road to Y in road – Now go left at Y and go approx. 2 miles NW then West along unknown road to ingress flagging at gate South into – Now follow final ingress, into staked location

Final ingress must be verified with landowner or operator.

*This drawing does not constitute a monumented survey or a land survey plat.
This drawing is for construction purposes only.*

LANDOWNER/CONTACT: Doug Klein: 785-626-6137

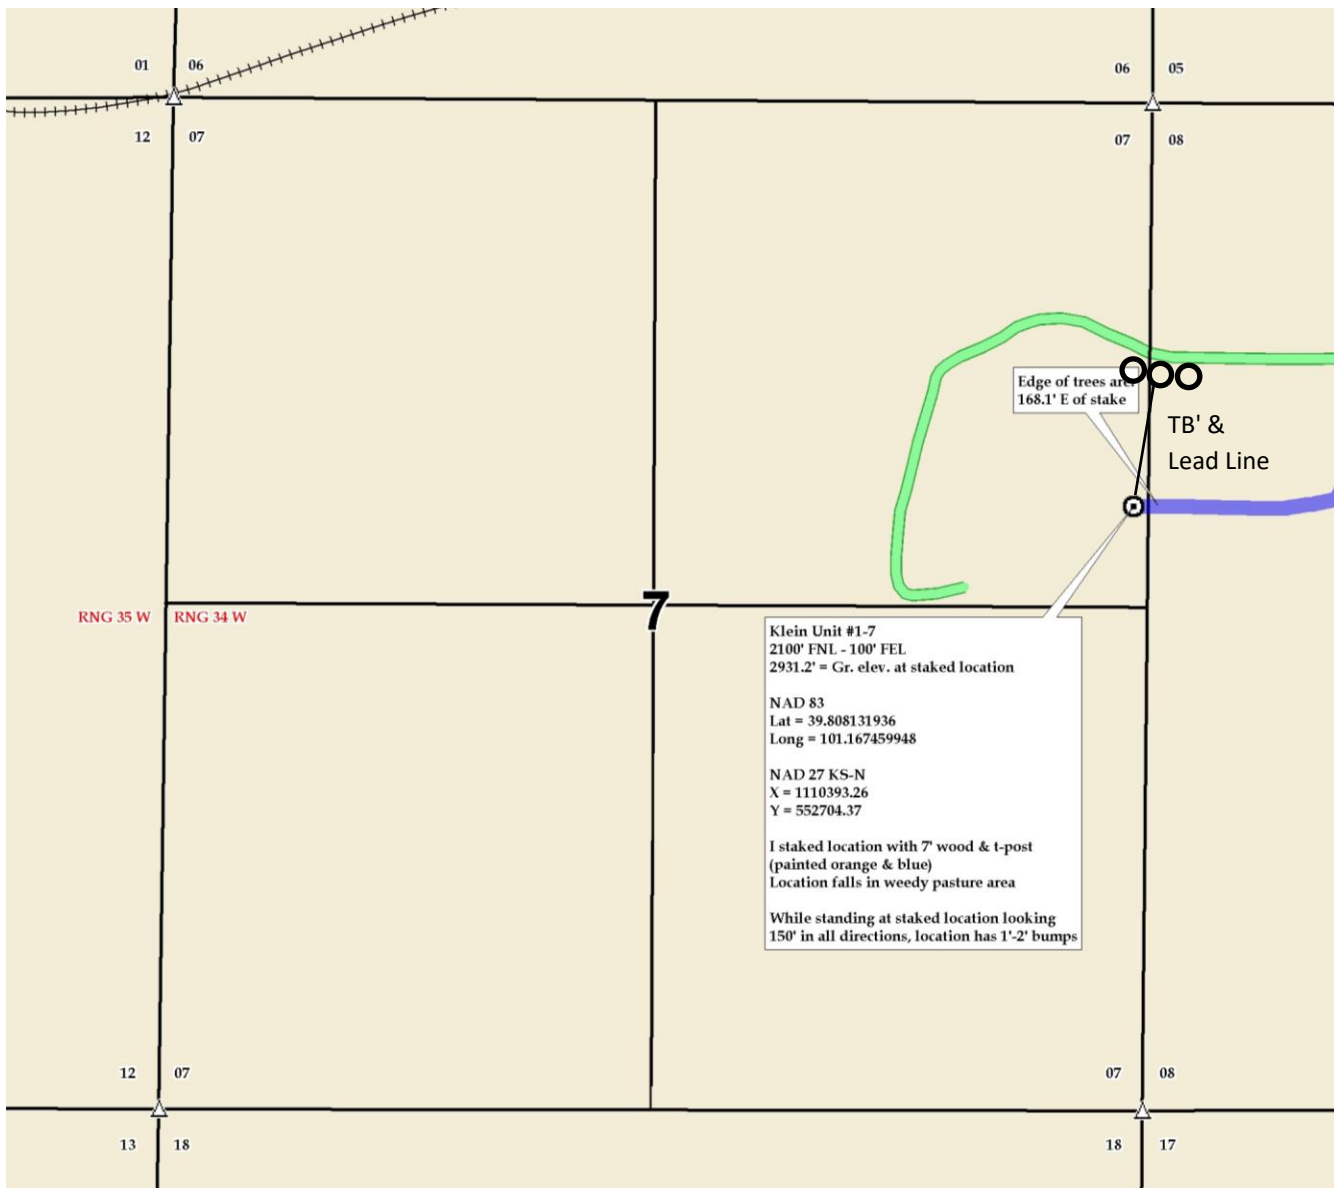



00-03s-34w-2022
CRD NO.

00-03s-34w
DMT NO.

PRO-STAKE

LLC

Construction Site Staking

14984A
INVOICE NO.



Murfin Drilling Company, Inc.
OPERATOR

Rawlins County, KS
COUNTY

Klein Unit #1-7
LEASE NAME

2100' FNL - 100' FEL
LOCATION SPOT

2931.2'
GR ELEVATION

39.808131936
NAD 83 LAT

101.167459948
NAD 83 LONG

07 03s 34w
Sec. Twp. Rng.

SCALE: 1" = 1000'
DATE STAKED: March 16th, 2022
MEASURED BY: Pierce R.
DRAWN BY: Pierce R.
AUTHORIZED BY: Sarah K.
DATE REVISED:

P.O. Box 2324 Garden City, Kansas 67846
Office/Fax: (620) 276-6159 – Cell: (620) 272-1499
burt@prostakellc.com

LEGEND

- ⊙ irr. well
- ⊕ water hydrant
- ⊙ tank battery
- ⊙ staked loc.
- ⊙ prod. well / aband. well
- ⊙ house
- building
- G— gas line
- W— water line
- E— transmission powerline
- 3 phase powerline
- single phase powerline
- x—x— fence
- ▬ gravel / sand rd.
- ▬ gravel trail / lease rd.
- ▬ dirt rd.
- ▬ dirt trail / lease rd.
- ▬ Hwy / blacktop rd.




DIRECTIONS: From Atwood, KS at the intersection of Hwy. 36 & Hwy. 25 – Now go 4.8 miles SW on on Hwy. 36 – Now go 0.6 miles North on unknown road to Y in road – Now go left at Y and go approx. 2 miles NW then West along unknown road to ingress flagging at gate South into – Now follow final ingress, into staked location

Final ingress must be verified with landowner or operator.

*This drawing does not constitute a monumented survey or a land survey plat.
This drawing is for construction purposes only.*

LANDOWNER/CONTACT: Doug Klein: 785-626-6137

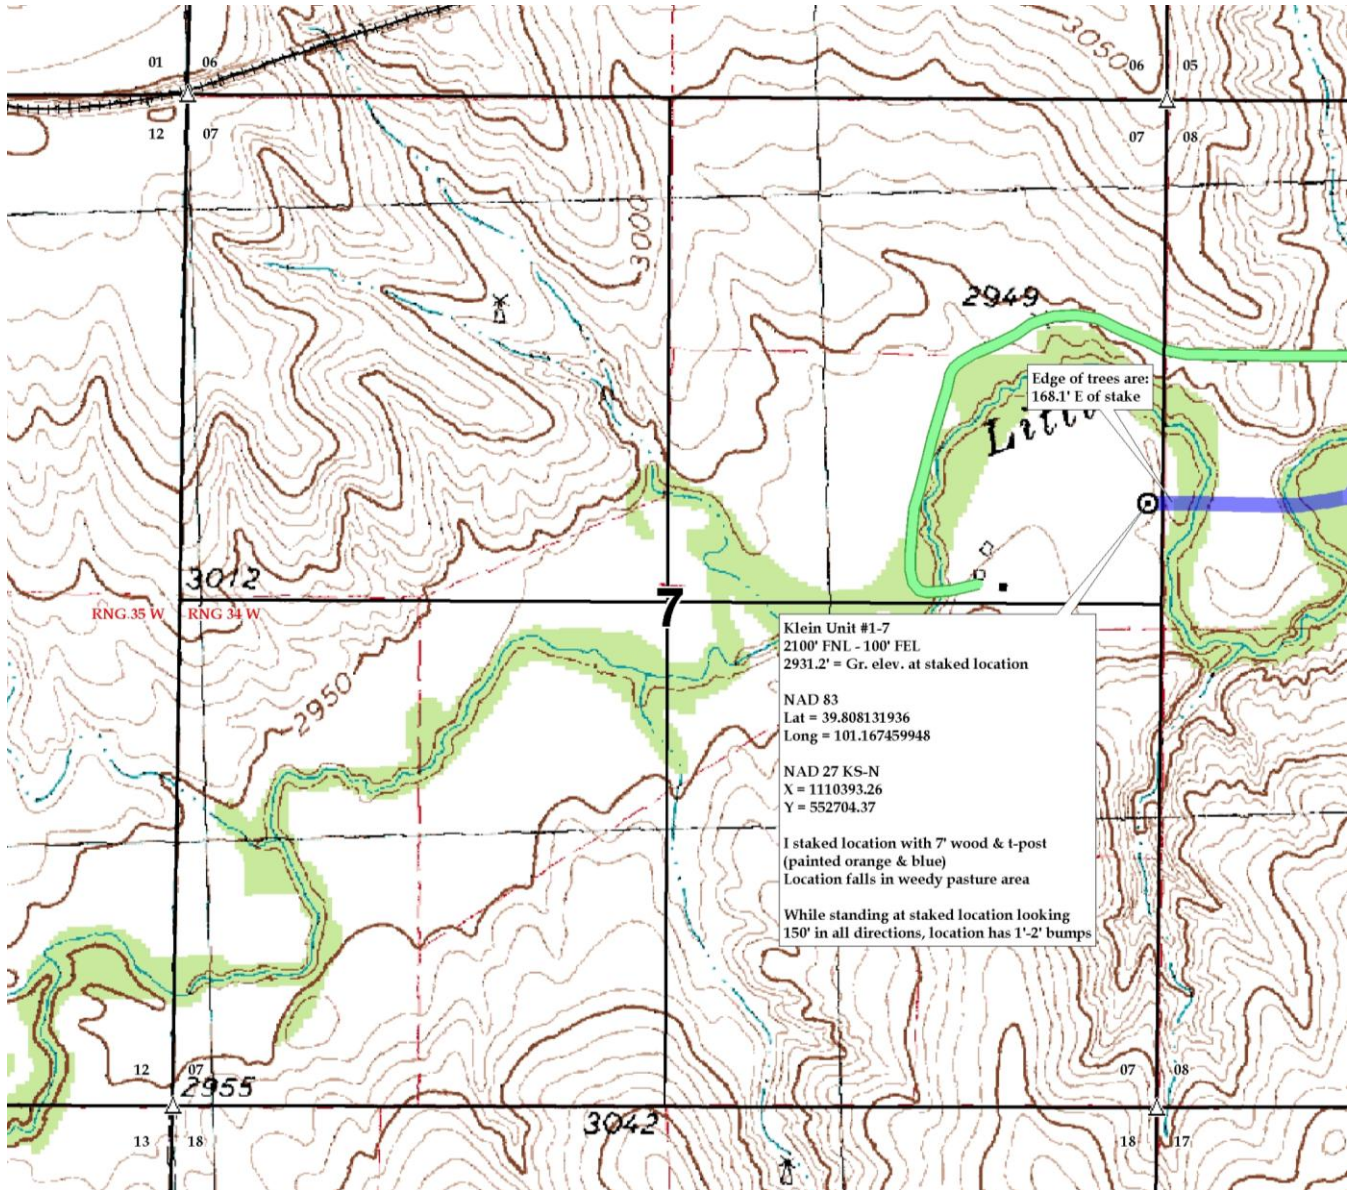

March 24, 2022

Sarah Kerstetter
Murfin Drilling Co., Inc.
250 N WATER STE 300
WICHITA, KS 67202-1216

Re: Drilling Pit Application
Klein Unit 1-7
NE/4 Sec.07-03S-34W
Rawlins County, Kansas

Dear Sarah Kerstetter:

District staff has inspected the location and has determined that an unsealed condition will present a pollution threat to water resources.

District staff has recommended that the working pit be lined. If a plastic liner is to be used it must have a minimum thickness of 10 mil. Integrity of the liner must be maintained at all times.

If production casing is set all completion fluids shall be removed from the working pits daily. NO completion fluids or non-exempt wastes shall be placed in the reserve pit.

The free fluids in the reserve pit should be removed as soon as practical after drilling operations have ceased. The fluids should be taken to an authorized disposal well. Please call the District Office at (785) 261-6250 when the fluids have been removed. Please file form CDP-5 (August 2008), Exploration and Production Waste Transfer, through KOLAR within 30 days of fluid removal.

A copy of this letter should be posted in the doghouse along with the approved Intent to Drill. If you have any questions or concerns please feel free to contact the District Office at (785) 261-6250.