

WATER WELL RECORD (WWC-5)

KOLAR DOC ID _____ WELL ID _____
 Original Record Correction Change in Well Use

LOCATION OF WATER WELL

Latitude		Longitude		Section		Township		Range		E W	Fraction		¼		¼		¼
Datum		Elevation		County													

WATER WELL OWNER

Name	
Business	
Address	
Well location at owner's address	

WELL WATER USE

--

COMPLETION

Depth of completed well: _____ ft.
Depth(s) groundwater encountered: (1) _____ ft.; (2) _____ ft.; (3) _____ ft.; (4) dry well
Static water level in well: _____ ft. measured below land surface on (mm/dd/yy): _____ measured above land surface on (mm/dd/yy): _____
Estimated yield: _____ gpm
Water level was: _____ ft. after _____ hours pumping _____ gpm
Pump installed? Yes No
Water well disinfected? Yes No
Date disinfected (mm/dd/yy): _____
Aquifer, if known:

NEAREST SOURCE OF POTENTIAL CONTAMINATION

Source: _____
Distance from well: _____ Direction from well: _____
Source description: _____
Source: _____
Distance from well: _____ Direction from well: _____
Source description: _____
No potential source of contamination within 100 feet.

CONSTRUCTION

Borehole interval: from _____ to _____ ft.	Borehole diameter: _____ in.
from _____ to _____ ft.	_____ in.
Casing height above land surface: _____ in.	
If casing height is less than 12 in. has a variance been approved?* Yes No	
*variance not required for monitoring or environmental remediation wells	
Casing type: _____	
Blank casing interval: _____ ft. to _____ ft.	
Blank casing diameter: _____ in.	
Casing joints: _____	
Weight: _____ lbs/ft.	
Wall thickness or gauge no.: _____	
Blank casing interval: _____ ft. to _____ ft.	
Blank casing diameter: _____ in.	
Casing joints: _____	
Weight: _____ lbs/ft.	
Wall thickness or gauge no.: _____	
Grout interval: _____ ft. to _____ ft.	
Grout material: _____	
Grout interval: _____ ft. to _____ ft.	
Grout material: _____	
Screen / perforation material: _____	
Screen / perforation openings: _____	
Screen / perforation intervals: From _____ ft. to _____ ft.	
Slot size _____ unit _____	
From _____ ft. to _____ ft.	
Slot size _____ unit _____	
Gravel pack intervals: Gravel pack not used: Gravel size _____ in	
From _____ ft. to _____ ft.	
Gravel pack not used: Gravel size _____ in	
From _____ ft. to _____ ft.	

PERMIT & ID NUMBERS (AS REQUIRED)

DWR Application No.: _____
KDHE / EPA Project Code: _____
Site Name: _____
KDHE UIC Class V Form Completed: Yes No
County Permit: Yes No Permit ID: _____
Lease Name & Well #: _____
of boreholes: _____ # of dewatering wells: _____

LITHOLOGIC LOG

FROM	TO	LITHOLOGY INTERVALS

COMMENTS

--

CONTRACTOR'S OR LANDOWNERS CERTIFICATION

This water well was constructed reconstructed pursuant to the stated water well contractor's license and was completed on _____. I certify that this record is true to the best of my knowledge and belief. This water well record was completed on _____ under the business name of _____, Kansas Water Well Contractor's License No. _____ under the authority of the designated person as defined in K.A.R. 28-30-2(j) and signed and certified by the electronic signature of the designated person at its submittal: _____.

Send one copy to WATER WELL OWNER and retain one for your records. Fee of \$5.00 for each constructed well.

Form	WWC5.2 - Water Well Record
Doc ID	1637405
Well Owner	Raymond Williams
Contractor	Peterson McNett Drilling, Inc.

Grout

From	To	Grout Material
0	5	Other
5	25	Cement
25	35	Bentonite

Stockton Field Office
820 S. Walnut
Stockton, KS 67669-0192



Phone: 785-425-6787
Fax: 785-425-6842
www.agriculture.ks.gov

Mike Beam, Secretary

Laura Kelly, Governor

April 13, 2022

RAYMOND WILLIAMS
raywill@hometelco.net

Re: RV Park

Dear Mr. Williams:

Per your request, this office has reviewed the information provided regarding water use at an RV park located near the Maxwell Game Preserve in McPherson County to determine if the water use is domestic or if it requires a municipal water right.

K.S.A. 82a-701(c) states that "Domestic uses means the use of water by any person or by a family unit or household for household purposes, or for the watering of livestock, poultry, farm and domestic animals used in operating a farm, and for the irrigation of lands not exceeding a total of two acres in area for the growing of gardens, orchards and lawns."

K.A.R. 5-1-1(kk) states that "Household purposes means the use of water by a person for cooking, cleaning, washing, bathing, human consumption, rest room facilities, fire protection, and other uses normally associated with the operation of a household." Further, K.A.R. 5-1-1(kk)(4) states that "household purposes shall also include the use of 1½ acre-feet of water or less per calendar year by an industrial user, restaurant, hotel, motel, church, camp, correctional facility, educational institution, or similar entity for household purposes."

The RV park in question is proposing 31 hook-ups serviced by the well or wells in question. Information provided and verified indicates that a typical RV will use on average 27 gallons per day. If all 31 spots were filled all year, the water use would be 305,505 gallons. This is less than the 488,776 gallons (1½ acre-feet) threshold defined in the referenced statute and regulation. Therefore, this office has made the determination that the well(s) in question does not require a water right at this time. If at any time in the future, additional information is provided indicating water use from the well exceeds the domestic threshold, a water right will be required. This office is available to assist with the application process if needed.


Sincerely,

A handwritten signature in blue ink that reads "Kelly C. Stewart". The signature is written in a cursive style and is positioned above a horizontal line.


Kelly C. Stewart
Water Commissioner

KCS
pc: Travis Hamel, Wilson & Company

PWS Well #1

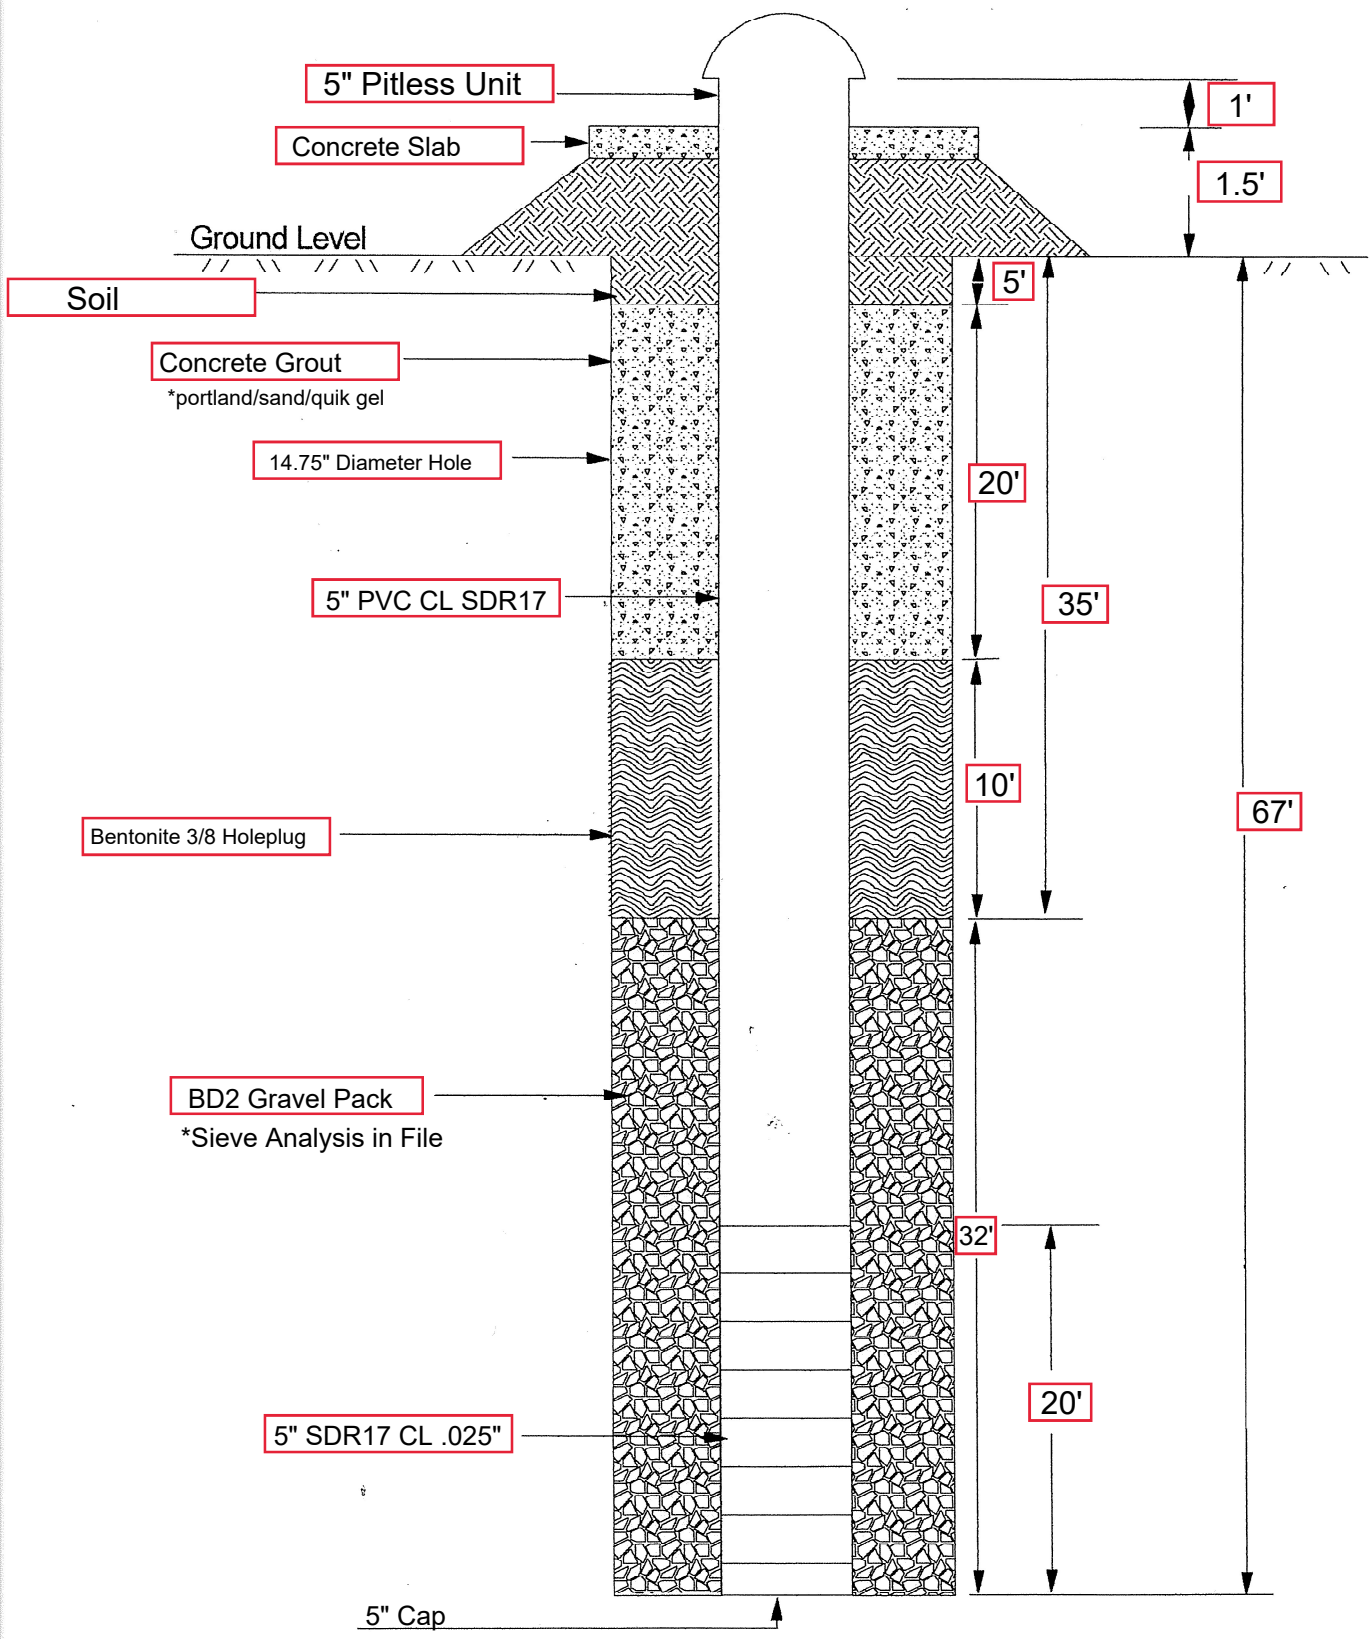


PWS Well #2

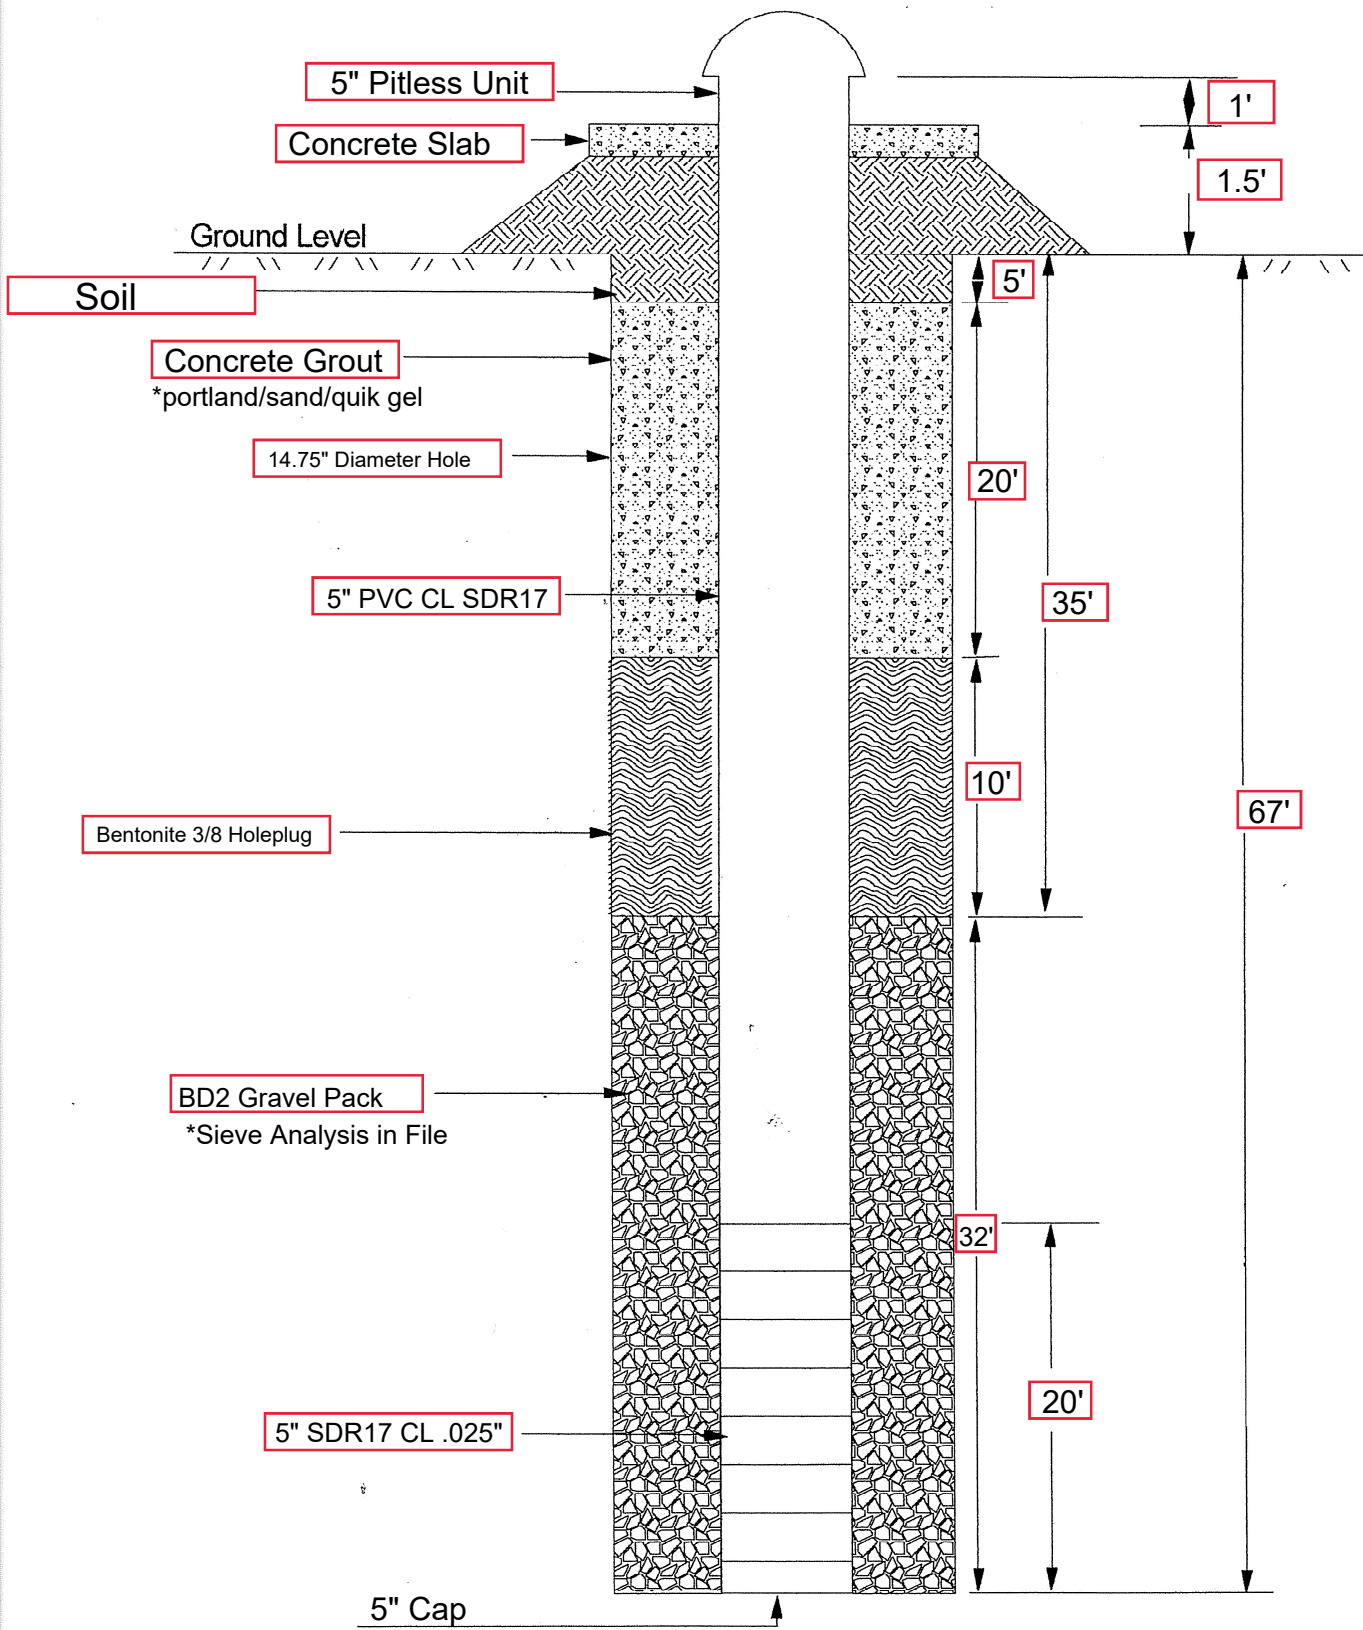

Peterson McNett Drilling, Inc.

Phone: (785) 227-8386

Email: mcnettdrilling@yahoo.com

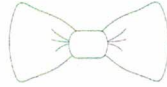

330 HARRISON
P.O. BOX 207
LINDSBORG, KS 67456

WATER WELL DRILLING

IRRIGATION ♦ MONITORING ♦ GEO-THERMAL ♦ PUBLIC WATER ♦ DOMESTIC ♦ STOCK ♦ LAWN

4/11/2022

Spoke with Rylan Becker w/ Rylan Becker Construction, LLC. and he confirmed that dirt/soil was used around the well. He used 2"x8" forms for the concrete and brought in dirt for the 1.5' of slope around the well.

Matt Koehn w/ Galva Plumbing also recalls sandy soil around the Pitless.

Spoke with Raymond and he recalls removing the bentonite thinking that we had forgot it when we left. Raymond confirmed Pitless is 12" above ground.

A handwritten signature in black ink, appearing to read 'Logan McNett', written in a cursive style.

Logan McNett

Peterson McNett Drilling, Inc.