

Form	ACO1 - Well Completion
Operator	Colorado Interstate Gas Co., LLC
Well Name	CPS 2405 2
Doc ID	1663371


Casing

Purpose Of String	Size Hole Drilled	Size Casing Set	Weight	Setting Depth	Type Of Cement	Number of Sacks Used	Type and Percent Additives
Surface	16	10.750	7.5	20	Bentonite	16N/A	



4600 N WESTERN STREET, AMARILLO TEXAS - TEL (806) 383-5047 - FAX (806) 383-1716

Deep Well GroundBed Data:			Date: 08/23/22		
Job Number: KMI21-KS-2022-02			Drilling Contractor: MCLEANS CP INSTALLATION, INC.		
Company Name: KINDER MORGAN			Facility/Line:		
Subject: DEEP WELL			State: KS		
Well Depth: 200'			County: MORTON		
Diameter: 10"			Other-Driller: TR		
Casing: 20' OF 10"			Drilling Method: AIR		
Backfill: LORESCO SC 3; 5500 LBS			Base Useable Water: N/A		
Anode Type: 1 SET OF 13-ANOTECH 2260					
GPS: 37.1917954; -101.8662456			TEST VOLTS:		
Remarks: CPS2405					
Drilling Log			Electrical Log		
			Anode Log		
			BEFORE BACKFILL		
			AFTER BACKFILL		
Depth:	Formation Type:	Material:	Volt	Anode Depth	Anode #
0'	SANDY CLAY	CASING/HOLEPLUG			
5'	SANDY CLAY	CASING/HOLEPLUG			
10'	SANDY CLAY	CASING/HOLEPLUG			
15'	SANDY CLAY	CASING/HOLEPLUG			
20	SANDY CLAY	CASING/HOLEPLUG			
25	SANDY CLAY	HOLEPLUG			
30	SANDY CLAY	HOLEPLUG			
35	SANDY CLAY	HOLEPLUG			
40	SANDY CLAY	HOLEPLUG			
45	SANDY CLAY	HOLEPLUG			
50	CLAY	HOLEPLUG	1.2		
55	CLAY	COKE			
60	CLAY	COKE	1.4		
65	CLAY	COKE			
70	CLAY	COKE	1.4		
75	SANDSTONE	COKE		75	13
80	SANDSTONE	COKE	1.2		
85	SANDSTONE	COKE		85	12
90	SANDSTONE	COKE	1.1		
95	SANDSTONE	COKE		95	11
100	SANDSTONE	COKE	1.0		
105	SANDSTONE	COKE		105	10
110	SANDSTONE	COKE	1.0		
115	SANDSTONE	COKE		115	9
120	SANDY CLAY	COKE	0.8		
125	SANDY CLAY	COKE		125	8
130	SANDY CLAY	COKE	1.2		
135	SANDY CLAY	COKE		135	7
140	SANDY CLAY	COKE	1.2		
145	SANDY CLAY	COKE		145	6
150	SANDY CLAY	COKE	1.0		
155	SANDY CLAY	COKE		155	5
160	SANDY CLAY	COKE	1.2		
165	SANDY CLAY	COKE		165	4
170	SANDY CLAY	COKE	1.4		
175	SANDY CLAY	COKE		175	3
180	SANDY CLAY	COKE	1.2		
185	SANDY CLAY	COKE		185	2
190	SANDY CLAY	COKE	1.2		
195	SANDY CLAY	COKE		195	1
200	SANDY CLAY	COKE	1.0		

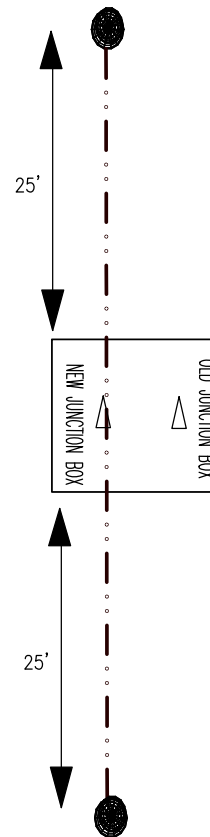

KEY:	
●	CP WELL
△	JUNCTION BOX
⌈ R ⌋	RECTIFIER
⬡	POWER POLE
★	CADWELD
---	FENCE
—	PIPELINE
- . . - . . - . . - . .	POSITIVE CABLE
- . - . - . - . - . - .	NEGATIVE CABLE

DATA BLOCK
ANODES= 2 SETS OF 13-ANOTECH 2260 ANODE WIRE= #8 HALAR BACKFILL= LORESCO SC3; 11000 LBS SPACING= 10' DEPTH= 2- 200' HOLE DIA= 10" HEADER CABLE= #2 HMWPE RECTIFIER= EXISTING JUNCTION BOX= PROVIDED TEST STATION= N/A CASING= 20' OF 10" MISCELLANEOUS= 10X10X3 TEE MISCELLANEOUS= CASING CENTRALIZERS

GPS READINGS
N37.1917954; W101.8662456
GAU BASE OF USABLE WATER
DEPTH - N/A

NOTES:
4600 N WESTERN ST AMARILLO TX 79124
TEL (806)383-5047 FAX (806)383-1716

REPRESENTATIVE: NORMAN ROGERS
SCALE: N/A
REVISION:
BY:
DATE:

LOCATION FOR CATHODIC
WELL NAME: KMI21-
CPS2405
MORTON COUNTY TX
INSTALL DATE: AUGUST 23, 2022
DWG:
HEP052022