KOLAR Document ID: 1668267

Confident	tiality Requeste	d:
Yes	No	

KANSAS CORPORATION COMMISSION OIL & GAS CONSERVATION DIVISION Form ACO-1 January 2018 Form must be Typed Form must be Signed All blanks must be Filled

WELL COMPLETION FORM WELL HISTORY - DESCRIPTION OF WELL & LEASE

OPERATOR: License #	API No.:
Name:	Spot Description:
Address 1:	
Address 2:	Feet from North / South Line of Section
City: State: Zip:+	Feet from East / West Line of Section
Contact Person:	Footages Calculated from Nearest Outside Section Corner:
Phone: ()	
CONTRACTOR: License #	GPS Location: Lat:, Long:
Name:	(e.g. xx.xxxx) (e.gxxx.xxxx)
Wellsite Geologist:	Datum: NAD27 NAD83 WGS84
Purchaser:	County:
Designate Type of Completion:	Lease Name: Well #:
New Well Re-Entry Workover	Field Name:
	Producing Formation:
	Elevation: Ground: Kelly Bushing:
☐ Gas ☐ DH ☐ EOR □ OG □ GSW	Total Vertical Depth: Plug Back Total Depth:
CM (Coal Bed Methane)	Amount of Surface Pipe Set and Cemented at: Feet
Cathodic Other (Core, Expl., etc.):	Multiple Stage Cementing Collar Used? Yes No
If Workover/Re-entry: Old Well Info as follows:	If yes, show depth set: Feet
Operator:	If Alternate II completion, cement circulated from:
Well Name:	feet depth to:w/sx cmt.
Original Comp. Date: Original Total Depth:	
Deepening Re-perf. Conv. to EOR Conv. to SWD	Deilling Fleid Management Disp
Plug Back Liner Conv. to GSW Conv. to Producer	Drilling Fluid Management Plan (Data must be collected from the Reserve Pit)
	Chlorida contenti nom Eluiduclumo, hblo
Commingled Permit #:	Chloride content: ppm Fluid volume: bbls
Dual Completion Permit #:	Dewatering method used:
SWD Permit #:	Location of fluid disposal if hauled offsite:
EOR Permit #:	Operator Name:
GSW Permit #:	Lease Name: License #:
	Quarter Sec TwpS. R East West
Spud Date or Date Reached TD Completion Date or Recompletion Date Recompletion Date Recompletion Date	County: Permit #:
Hoompleter Bate	

AFFIDAVIT

I am the affiant and I hereby certify that all requirements of the statutes, rules and regulations promulgated to regulate the oil and gas industry have been fully complied with and the statements herein are complete and correct to the best of my knowledge.

Submitted Electronically

KCC Office Use ONLY				
Confidentiality Requested				
Date:				
Confidential Release Date:				
Wireline Log Received Drill Stem Tests Received				
Geologist Report / Mud Logs Received				
UIC Distribution				
ALT I II III Approved by: Date:				

KOLAR Document ID: 1668267

Operator Nam	ne:			Lease Name:	Well #:
Sec	Twp	S. R	East West	County:	

Page Two

INSTRUCTIONS: Show important tops of formations penetrated. Detail all cores. Report all final copies of drill stems tests giving interval tested, time tool open and closed, flowing and shut-in pressures, whether shut-in pressure reached static level, hydrostatic pressures, bottom hole temperature, fluid recovery, and flow rates if gas to surface test, along with final chart(s). Attach extra sheet if more space is needed.

Final Radioactivity Log, Final Logs run to obtain Geophysical Data and Final Electric Logs must be emailed to kcc-well-logs@kcc.ks.gov. Digital electronic log files must be submitted in LAS version 2.0 or newer AND an image file (TIFF or PDF).

Drill Stem Tests Taken (Attach Additional Sh	Y	′es 🗌 No			og Formatio	n (Top), Depth a	and Datum	Sample	
Samples Sent to Geolo			⁄es 🗌 No	1	Name	Э		Тор	Datum
Cores Taken Electric Log Run Geologist Report / Mud List All E. Logs Run:		□ Y □ Y	Yes ☐ No Yes ☐ No Yes ☐ No						
		Rep	CASING ort all strings set-c] Ne	w Used rmediate, productio	on. etc.		
Purpose of String	Size Hole Drilled	Siz	ze Casing et (In O.D.)	Weight Lbs. / Ft.		Setting Depth	Type of Cement	# Sacks Used	Type and Percent Additives
[ADDITIONAL	CEMENTING /	SQU	EEZE RECORD			
Purpose:	Depth Top Bottom	Туре	e of Cement	# Sacks Used			Type and	Percent Additives	
Protect Casing Plug Back TD Plug Off Zone									
 Did you perform a hydra Does the volume of the Was the hydraulic fracture 	total base fluid of the	hydraulic fr	acturing treatment		-	☐ Yes ns? ☐ Yes ☐ Yes	No (If No, s	kip questions 2 ar kip question 3) ill out Page Three	
Date of first Production/Inj Injection:	jection or Resumed Pr	oduction/	Producing Meth	iod:		Gas Lift 🗌 O	ther <i>(Explain)</i>		
Estimated Production Per 24 Hours	Oil	Bbls.	Gas Mcf			er Bb	ls.	Gas-Oil Ratio	Gravity
DISPOSITIO	N OF GAS:		Ν	IETHOD OF COM	MPLE	TION:		PRODUCTIC Top	DN INTERVAL: Bottom
Vented Sold (If vented, Subn	Used on Lease		Open Hole Perf.		-	·	nit ACO-4)	юр	Bollom
Shots Per Perforation Perforation Foot Top Bottom			Bridge Plug Type	Bridge Plug Set At		Acid,		ementing Squeezend of Material Used)	
TUBING RECORD:	Size:	Set At:		Packer At:					

Form	ACO1 - Well Completion
Operator	TDR Construction, Inc.
Well Name	MOLDENHAUER 105
Doc ID	1668267

Casing

	Size Hole Drilled	Size Casing Set	Weight	Setting Depth	Type Of Cement		Type and Percent Additives
Surface	9	7	10	24	Portland	3	50/50 POZ
Production	5.625	2.875	8	803	Portland	90	50/50 POZ



CEMENT TREATMENT REPORT

Cust	tomer:	TDR Co	nstructi	on	Well:	Moldenhauer 1	05 Ticket:	EP5985
City,	State:	Louisbu	rg, KS		County:	FR, KS	Date:	9/16/2022
Field	d Rep:	Lance T	own		S-T-R:	32-15-21	Service:	Longstring
Bow	nhole (nformatic	m		Calculated Sit	irry - Lead	Galcu	lated Slurry - Tail
	size:	5 5/8			Blend:	Econobond	Blend:	
Hole C		820			Weight:	13.52 ppg	Weight:	ppg
Casing		2 7/8			Water / Sx:	7,12 gal / sk	Water / Sx:	gal / sk
Casing D		803.20	ft		Yield:	1.56 ft ³ /sk	Yield:	ft ³ /sk
ubing /			in		Annular Bbis / Ft.:	bbs / ft,	Annular Bbis / Ft.:	bbs / ft.
	Depth:		ft		Depth:	ft	Depth:	ft
Tool / Pa		bafi	le		Annular Volume:	0.0 bbls	Annular Volume:	0 bbls
Tool D	Depth:	771.50	ft		Excess:		Excess:	
Displace		4.47	bbls		Total Slurry:	25.01 bbls	Total Slurry:	0.0 bbls
			STAGE	TOTAL	Total Sacks:	90 sks	Total Sacks:	0 sks
TIME	RATE	PSI	BBLs	BBLs	REMARKS			
3:00 PM			-	-	on location, held safety r	neeting		
				-			· · ·	
	4.0				established circulation			
	4.0			-	mixed and pumped 200#	Bentonite Gel followed by 4 bb	ls fresh water	
	4.0			-	mixed and pumped 90 sl	s Econobond cement, cement	to surface	
	4.0			-	flushed pump clean			
	1.0			-	pumped 2 7/8" rubber pl	ug to casing TD with 4.47 bbls i	resh water	
	1.0			-	pressured to 800 PSI, we	II held pressure	·	
				-	released pressure to set	float valve		·····
	4.0			-	washed up equipment			
				-				
4:00 PM	ļ				left location			
				-		******		
				-				
				-				
				•				
				-				
				-				
	L			-				
				-				······
				-				
								
				-				
				-				an a
				-				
				_				terre a construction de la construction de
		CREW			UNIT (ACCOUNT)		SUMMARY	
	nenter:		y Kenned	<u>y</u>	931	Average Rate	Average Pressure	Total Fluid
Pump Op			Beets		238	3.1 bpm	- psi	- bbis
	Bulk:	T	or Glasgov		248	1		

Franklin County, KS Well:Moldenhaur 105 Lease Owner: TDR TDR Construction, Inc. (913) 710-5400

WELL LOG

Thickness of Strata	Formation	Total Depth
0-14	Soil-Clay	14
62	Shale	76
26	Lime	102
7	Shale	109
9	Lime	118
5	Shale	123
19	Lime	142
37	Shale	179
20	Lime	199
81	Shale	280
28	Lime	308
2	Shale	310
10	Lime	320
20	Shale	340
1	Lime	341
21	Shale	362
1	Lime	363
15	Shale	378
10	Lime	388
2	Shale	390
12	Lime	402
9	Shale	411
24	Lime	435
3	Shale	438
4	Lime	442
4	Shale	446
6	Lime	452
4	Shale	456
3	Lime	459
112	Shale	571
13	Sand	584
33	Shale	617
7	Sand	624
6	Shale	630
6	Lime	636
10	Shale	646
6	Lime	652
4	Shale	656
9	Lime	665
12	Shale	677

Franklin County, KS Well:Moldenhaur 105 Lease Owner: TDR

TDR Construction, Inc. Commenced Spudding: (913) 710-5400 09/15/2022

4	Lime	681
8	Shale	689
12	Lime	701
16	Shale	717
8	Lime	725
3	Sandy Shale	728
3	Sand	731
12	Sand	743
4	Sand	747
18	Sandy Shale	765
55	Shale	820-TD
	· · · · ·	
· · · · · · · · · · · · · · · · · · ·		
	· · · · · · · · · · · · · · · · · · ·	
		1
	1	1

Short Cuts

BBLS. (42 gal.) equals D²x.14xh D equals diameter in feet. h equals height in feet.

BARRELS PER DAY Multiply gals. per minute x 34.2

HP equals BPH x PSI x .0004 BPH - barrels per hour PSI - pounds square inch

TO FIGURE PUMP DRIVES

* D - Diameter of Pump Sheave * d - Diameter of Engine Sheave SPM - Strokes per minute RPM - Engine Speed R - Gear Box Ratio *C - Shaft Center Distance

D - RPMxd over SPMxR d - SPMxRxD over RPM SPM - RPMXD over RxD R - RPMXD over SPMxD

BELT LENGTH - 2C + 1.57(D + d) + (D-d)²

* Need these to figure belt length WATTS = AMPS TO FIGURE AMPS: VOLTS 746 WATTS equal 1 HP

Log Book

105 Well No.


Farm_Moldenhauer County) (State) 21 29 15 (Township) (Range) (Section)

:	ForTDR	Construction
		(Well Owner)

Town Oilfield Services, Inc.

1207 N. 1st East Louisburg, KS 66053 913-710-5400

Moldenhauefarm: Franktin county State; Well No. 105 15 Elevation 101Ce Sep 15 2022 Commenced Spuding STR _20 20 Finished Drilling Ward Driller's Name 124an Driller's Name Driller's Name Jand Tool Dresser's Name 2 au Tool Dresser's Name Tool Dresser's Name Contractor's Name TDR Construction 29 15 21 (Section) (Township) (Range) 5 _ft. Distance from _ line, 775 E Distance from _ line. 3 sacks cement 5-518" Bore hole 2-718" Casing. 9 hrs. CASING AND TUBING RECORD

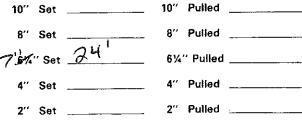

CASING AND TUBING MEASUREMENTS

Feet	In.	Feet	ln.	Feet	In.
715	I B	affle			
807.2	F	loat			
820	T	\mathcal{D}			
			j		
	` .				
					ļ
	1				Ļ
		1			ļ
·					
· · ·					
·		-			
-					<u>.</u>
- <u>-</u> `s					

-1-

Remarks	F	Total * Depth	Formation	Thickness of Strata
······································		14	Soil Clay	0-14
		76	Shale /	62
		102	Lime	26
		109	Shak	7
	· · · · · · · · · · · · · · · · · · ·	118	line	9
		123-	Shak	5
		142-	Line	19
		179	Shale	37
		199 -	Lime	20
		280-	Shale	81
		308 -	Line	28
		310-	Shale	2
·····		320	Cime	10
	••••••••••••••••••••••••••••••••••••••	-340 -	Shale	20
		341-	Lime	1
		362 -	Shale	21
		363-	Line	l
· · · · · · · · · · · · · · · · · · ·	· · · · · · · · · · · · · · · · · · ·	378	Shale	15
		-388 -	Lim	10
	· · · · · · · · · · · · · · · · · · ·	390	Shale	2
	<u> </u>	402-	Lime	12
· · ·		<u> </u>	Shale	9
		475	Line	24
		438	Shak	3.
		442	Lime	L
		446.	Shale (,ne	4
	Hertha	452	-2-	Q

452 im Total Depth Thickness of Formation Strata Remarks 456 Snak 4 Line 459 3 112 971 Shah 584 Sand Slight oder 617 33 Shak 624 Nooil ml 630 **.**.. 636 M Þ • 10 G46 5 heal 652 ine 6 654 U have C Cd-5 100 רר, 12 Shale 381 4 in , ` ,, -99 Z Shal 12 LIM 701 16 Shal 717 775 Line 728 Sandy Shale Ż Sand 731 Broken Some oil show Sand 12 743 Solid, Good oil show Mostly Sand 747 ok Good oil show 63 Sandy Shal 18 765 Shal \$20 55 T.D--4--5-

-4-