

**WATER WELL RECORD (WWC-5)**

KOLAR DOC ID \_\_\_\_\_ WELL ID \_\_\_\_\_  
 Original Record      Correction      Change in Well Use

**LOCATION OF WATER WELL**

Latitude		Longitude		Section		Township		Range		E W	Fraction		¼		¼		¼
Datum		Elevation		County													

**WATER WELL OWNER**

Name	
Business	
Address	
Well location  at owner's address	

**WELL WATER USE**

--

**COMPLETION**

Depth of completed well: _____ ft.
Depth(s) groundwater encountered:
(1) _____ ft.; (2) _____ ft.;
(3) _____ ft.; (4) dry well
Static water level in well: _____ ft.
measured below land surface on (mm/dd/yy): _____
measured above land surface on (mm/dd/yy): _____
Estimated yield: _____ gpm
Water level was: _____ ft. after _____ hours pumping _____ gpm
Pump installed?    Yes    No
Water well disinfected?    Yes    No
Date disinfected (mm/dd/yy): _____
Aquifer, if known:

**NEAREST SOURCE OF POTENTIAL CONTAMINATION**

Source: _____
Distance from well: _____      Direction from well: _____
Source description: _____
Source: _____
Distance from well: _____      Direction from well: _____
Source description: _____
No potential source of contamination within 100 feet.

**CONSTRUCTION**

Borehole interval: from _____ to _____ ft.	Borehole diameter: _____ in.
from _____ to _____ ft.	_____ in.
Casing height above land surface: _____ in.	
If casing height is less than 12 in. has a variance been approved?*    Yes    No	
*variance not required for monitoring or environmental remediation wells	
Casing type: _____	
Blank casing interval: _____ ft. to _____ ft.	
Blank casing diameter: _____ in.	
Casing joints: _____	
Weight: _____ lbs/ft.	
Wall thickness or gauge no.: _____	
Blank casing interval: _____ ft. to _____ ft.	
Blank casing diameter: _____ in.	
Casing joints: _____	
Weight: _____ lbs/ft.	
Wall thickness or gauge no.: _____	
Grout interval: _____ ft. to _____ ft.	
Grout material: _____	
Grout interval: _____ ft. to _____ ft.	
Grout material: _____	
Screen / perforation material: _____	
Screen / perforation openings: _____	
Screen / perforation intervals:	
From _____ ft. to _____ ft.	
Slot size _____ unit _____	
From _____ ft. to _____ ft.	
Slot size _____ unit _____	
Gravel pack intervals:	
Gravel pack not used:    Gravel size _____ in	
From _____ ft. to _____ ft.	
Gravel pack not used:    Gravel size _____ in	
From _____ ft. to _____ ft.	

**PERMIT & ID NUMBERS (AS REQUIRED)**

DWR Application No.: _____
KDHE / EPA Project Code: _____
Site Name: _____
KDHE UIC Class V Form Completed:    Yes    No
County Permit:    Yes    No    Permit ID: _____
Lease Name & Well #: _____
# of boreholes: _____    # of dewatering wells: _____

**LITHOLOGIC LOG**

FROM	TO	LITHOLOGY INTERVALS


**COMMENTS**

--

**CONTRACTOR'S OR LANDOWNERS CERTIFICATION**

This water well was    constructed    reconstructed    pursuant to the stated water well contractor's license and was completed on _____. I certify that this record is true to the best of my knowledge and belief. This water well record was completed on _____ under the business name of _____, Kansas Water Well Contractor's License No. _____ under the authority of the designated person as defined in K.A.R. 28-30-2(j) and signed and certified by the electronic signature of the designated person at its submittal: _____.
---

Send one copy to WATER WELL OWNER and retain one for your records. Fee of \$5.00 for each constructed well.

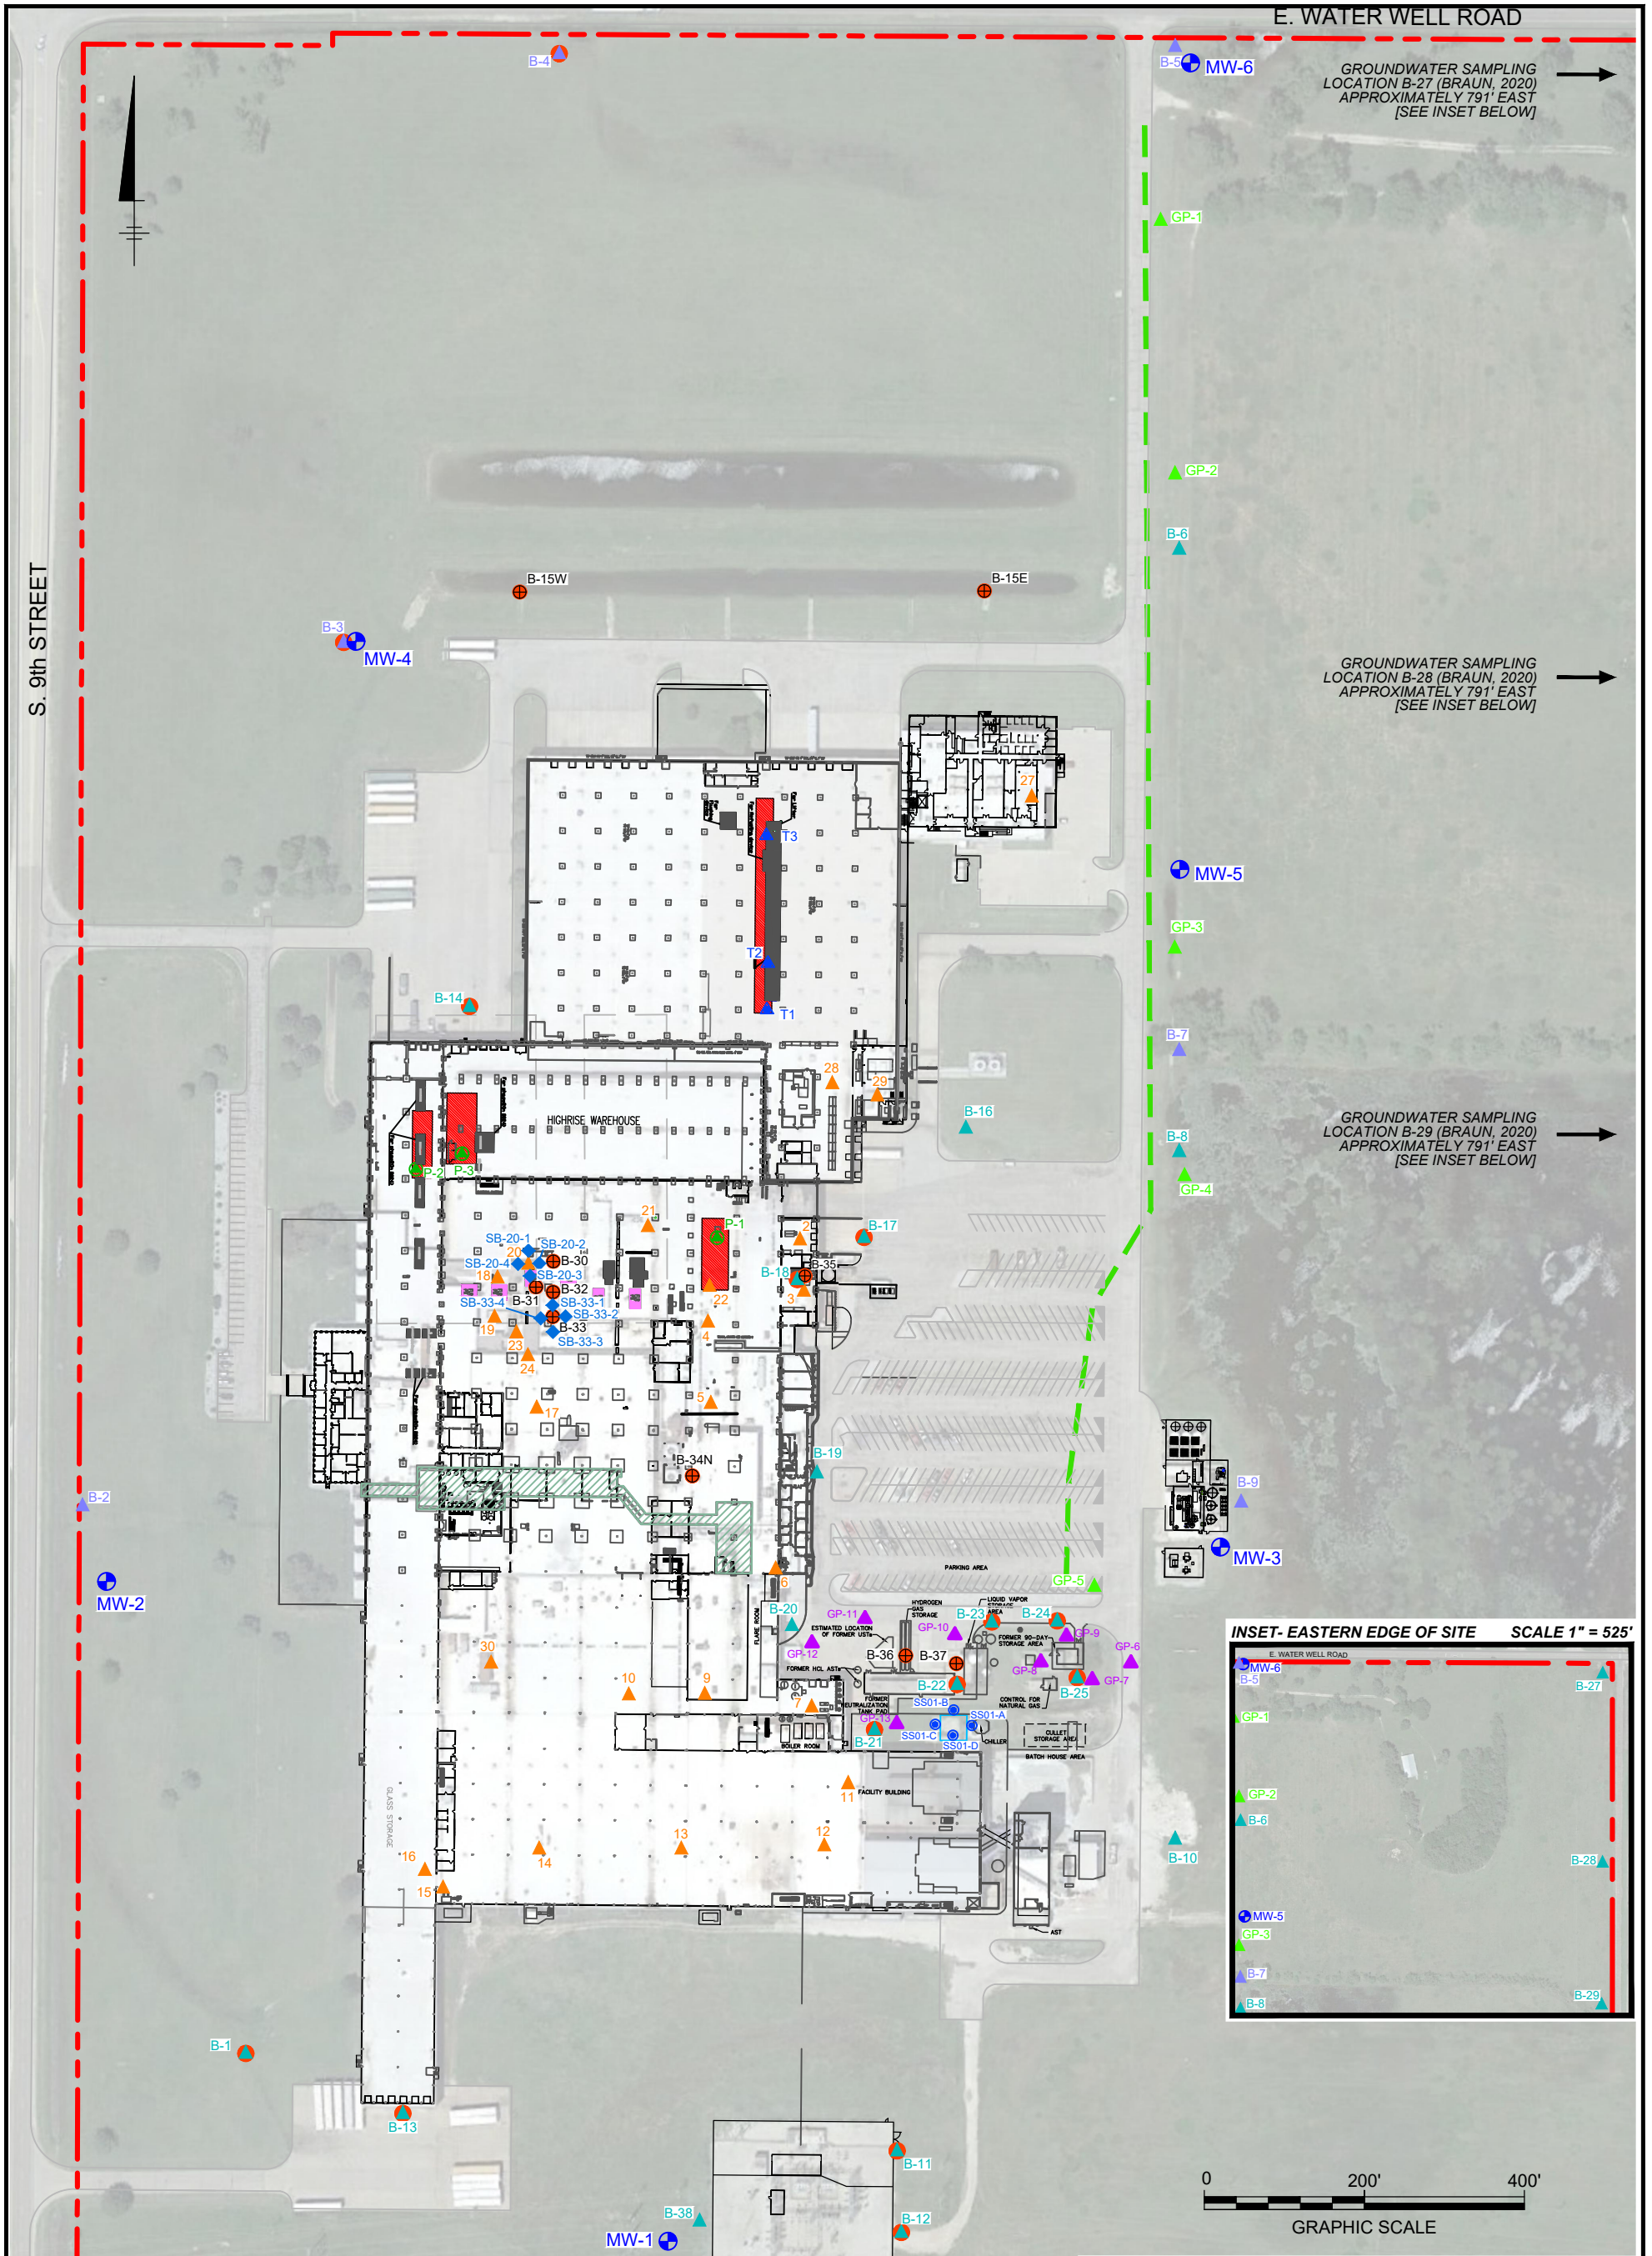

E. WATER WELL ROAD


S. 9th STREET

GROUNDWATER SAMPLING LOCATION B-27 (BRAUN, 2020) APPROXIMATELY 791' EAST [SEE INSET BELOW]

GROUNDWATER SAMPLING LOCATION B-28 (BRAUN, 2020) APPROXIMATELY 791' EAST [SEE INSET BELOW]

GROUNDWATER SAMPLING LOCATION B-29 (BRAUN, 2020) APPROXIMATELY 791' EAST [SEE INSET BELOW]

INSET - EASTERN EDGE OF SITE SCALE 1" = 525'

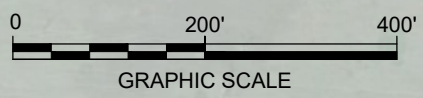

**LEGEND:**

- |                                 |  |   |
|---------------------------------|--|---|
| PROPERTY BOUNDARY               | <b>ARCADIS 2020 - SUB SLAB SOIL SAMPLING</b>             | <b>BRAUN 2020 - SUPPLEMENTAL PHASE II SAMPLING</b>  |
| APPROXIMATE SEWER MAIN LOCATION | 28 SOIL BORING LOCATION (ARCADIS, 2021)                  | B-30 SOIL SAMPLING LOCATION (BRAUN, 2020)           |
| BASEMENT                        | T1 TRENCH BORING LOCATION (ARCADIS, 2021)                | B-8 GROUNDWATER SAMPLING LOCATION (BRAUN, 2020)     |
| TRENCH LOCATIONS                | P-3 PIT SAMPLING LOCATION (ARCADIS, 2021)                | <b>ARCADIS 2012 PHASE II SAMPLING</b>               |
| PIT LOCATIONS                   | <b>BRAUN 2020 - PHASE II SAMPLING</b>                    | GP-4 SUBSURFACE SOIL SAMPLE, SEWER (ARCADIS, 2012)  |
| MW-1 MONITORING WELL LOCATIONS  | B-8 GROUNDWATER SAMPLING LOCATION (BRAUN, 2020)          | SS01-D SURFACE SOIL SAMPLE LOCATION (ARCADIS, 2012) |
| SB-33-1 PROPOSED SOIL BORING    | B-1 SOIL AND GROUNDWATER SAMPLING LOCATION (BRAUN, 2020) | GP-13 SOIL SAMPLE LOCATION (ARCADIS, 2012)          |
|                                 | B-9 PIEZOMETER SAMPLING LOCATION (BRAUN, 2020)           |   |

SIGNIFY NORTH AMERICA  
 3861 S 9TH ST, SALINA, KS

**SAMPLE LOCATIONS**

