

Sec. _____ Twp. _____ S. R. _____ ☐ East ☐ West County: _____

Final Radioactivity Log, Final Logs run to obtain Geophysical Data and Final Electric Logs must be emailed to kcc-well-logs@kcc.ks.gov. Digital electronic log files must be submitted in LAS version 2.0 or newer AND an image file (TIFF or PDF).

Drill Stem Tests Taken <i>(Attach Additional Sheets)</i>	☐ Yes	☐ No	☐ Log	Formation (Top), Depth and Datum	☐ Sample
Samples Sent to Geological Survey	☐ Yes	☐ No	Name	Top	Datum
Cores Taken	☐ Yes	☐ No			
Electric Log Run	☐ Yes	☐ No			
Geologist Report / Mud Logs	☐ Yes	☐ No			
List All E. Logs Run:					

CASING RECORD ☐ New ☐ Used Report all strings set-conductor, surface, intermediate, production, etc.							
Purpose of String	Size Hole Drilled	Size Casing Set (In O.D.)	Weight Lbs. / Ft.	Setting Depth	Type of Cement	# Sacks Used	Type and Percent Additives

ADDITIONAL CEMENTING / SQUEEZE RECORD				
Purpose:	Depth Top Bottom	Type of Cement	# Sacks Used	Type and Percent Additives
☐ Perforate				
☐ Protect Casing				
☐ Plug Back TD				
☐ Plug Off Zone				

1. Did you perform a hydraulic fracturing treatment on this well? ☐ Yes ☐ No (If No, skip questions 2 and 3)
2. Does the volume of the total base fluid of the hydraulic fracturing treatment exceed 350,000 gallons? ☐ Yes ☐ No (If No, skip question 3)
3. Was the hydraulic fracturing treatment information submitted to the chemical disclosure registry? ☐ Yes ☐ No (If No, fill out Page Three of the ACO-1)

Date of first Production/Injection or Resumed Production/Injection:		Producing Method: ☐ Flowing ☐ Pumping ☐ Gas Lift ☐ Other (Explain) _____			
Estimated Production Per 24 Hours	Oil Bbls.	Gas Mcf	Water	Bbls.	Gas-Oil Ratio Gravity

DISPOSITION OF GAS: ☐ Vented ☐ Sold ☐ Used on Lease <i>(If vented, Submit ACO-18.)</i>	METHOD OF COMPLETION: ☐ Open Hole ☐ Perf. ☐ Dually Comp. ☐ Commingled <i>(Submit ACO-5)</i> <i>(Submit ACO-4)</i>	PRODUCTION INTERVAL:	
		Top	Bottom



Shots Per Foot	Perforation Top	Perforation Bottom	Bridge Plug Type	Bridge Plug Set At	Acid, Fracture, Shot, Cementing Squeeze Record (Amount and Kind of Material Used)

TUBING RECORD:	Size:	Set At:	Packer At:	
----------------	-------	---------	------------	--



Form	ACO1 - Well Completion
Operator	Owens Oil Company, LLC
Well Name	BILL FREEMAN 12
Doc ID	1673593

Casing

Purpose Of String	Size Hole Drilled	Size Casing Set	Weight	Setting Depth	Type Of Cement	Number of Sacks Used	Type and Percent Additives
Surface	11	7	20	41	Portland	14	na
Production	5.875	2.875	6.5	1030	Econobond	125	na

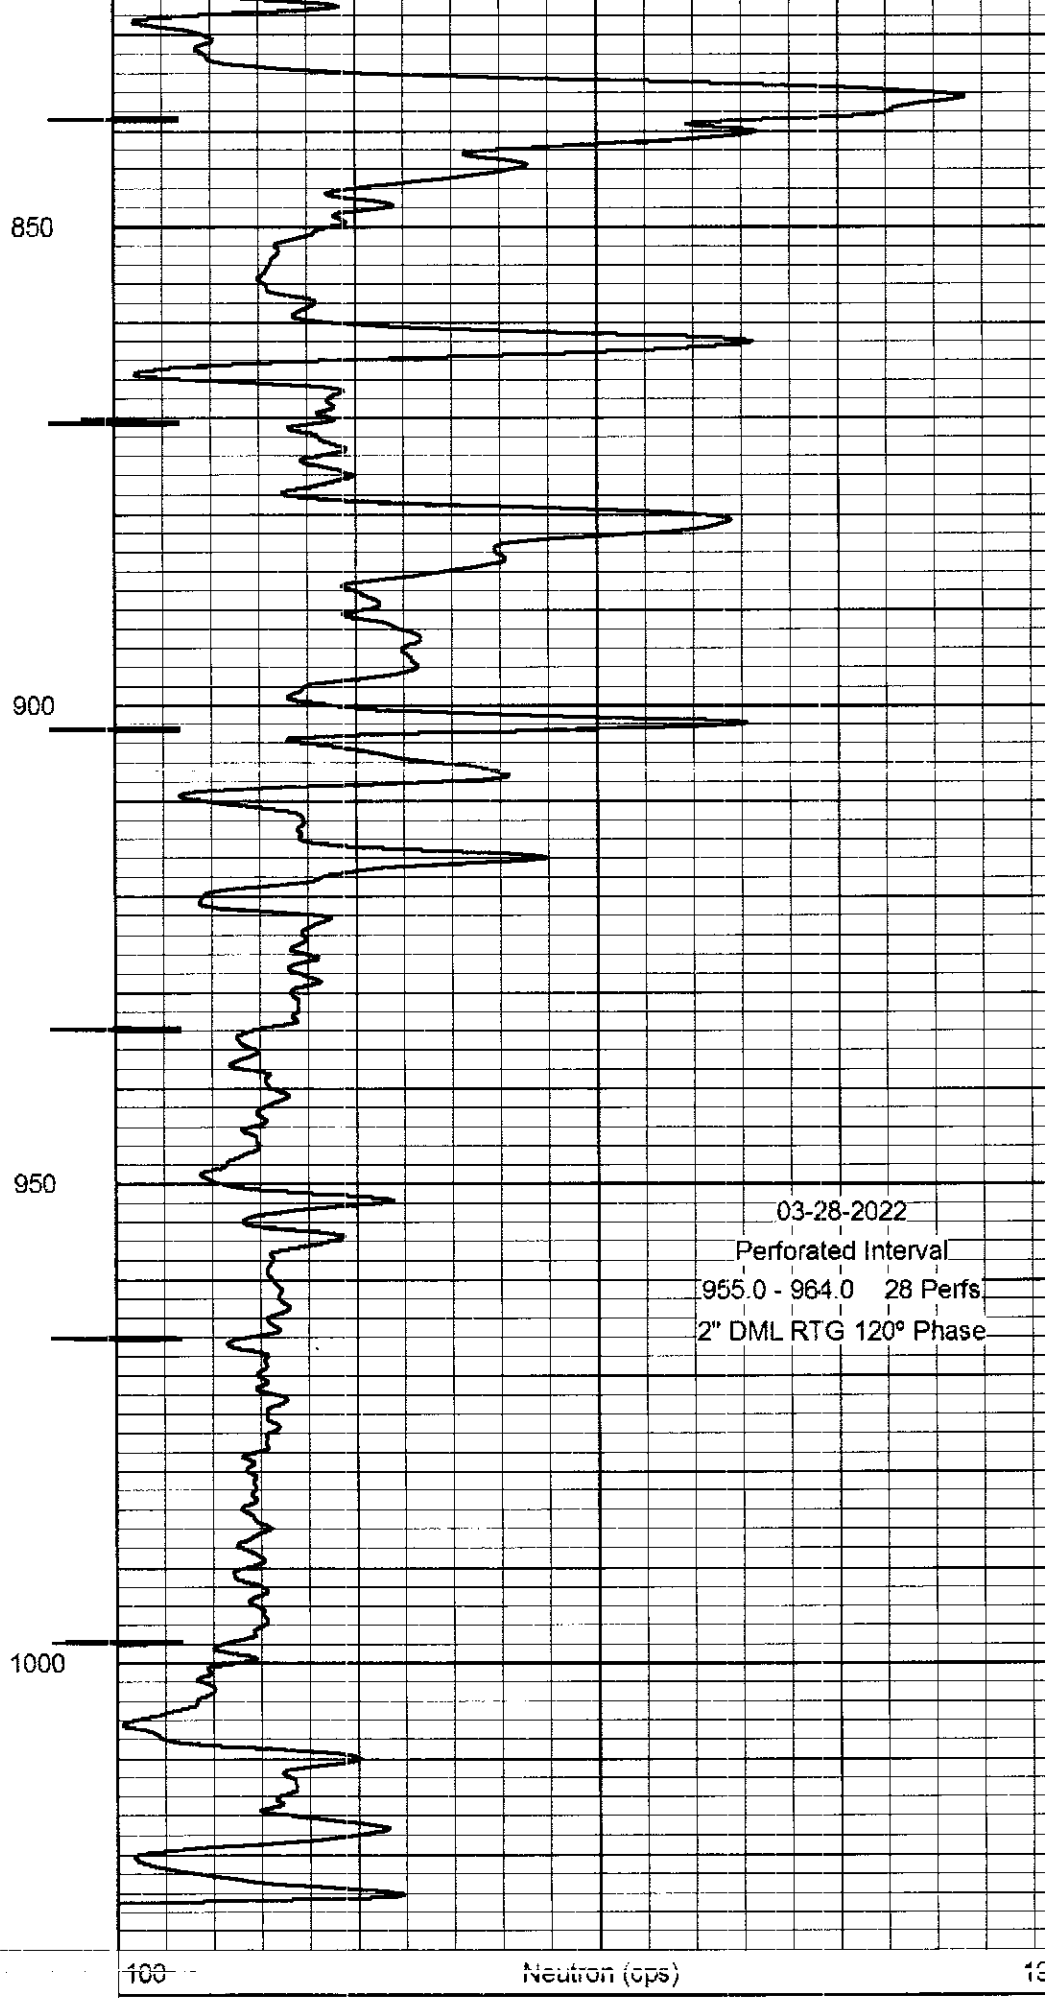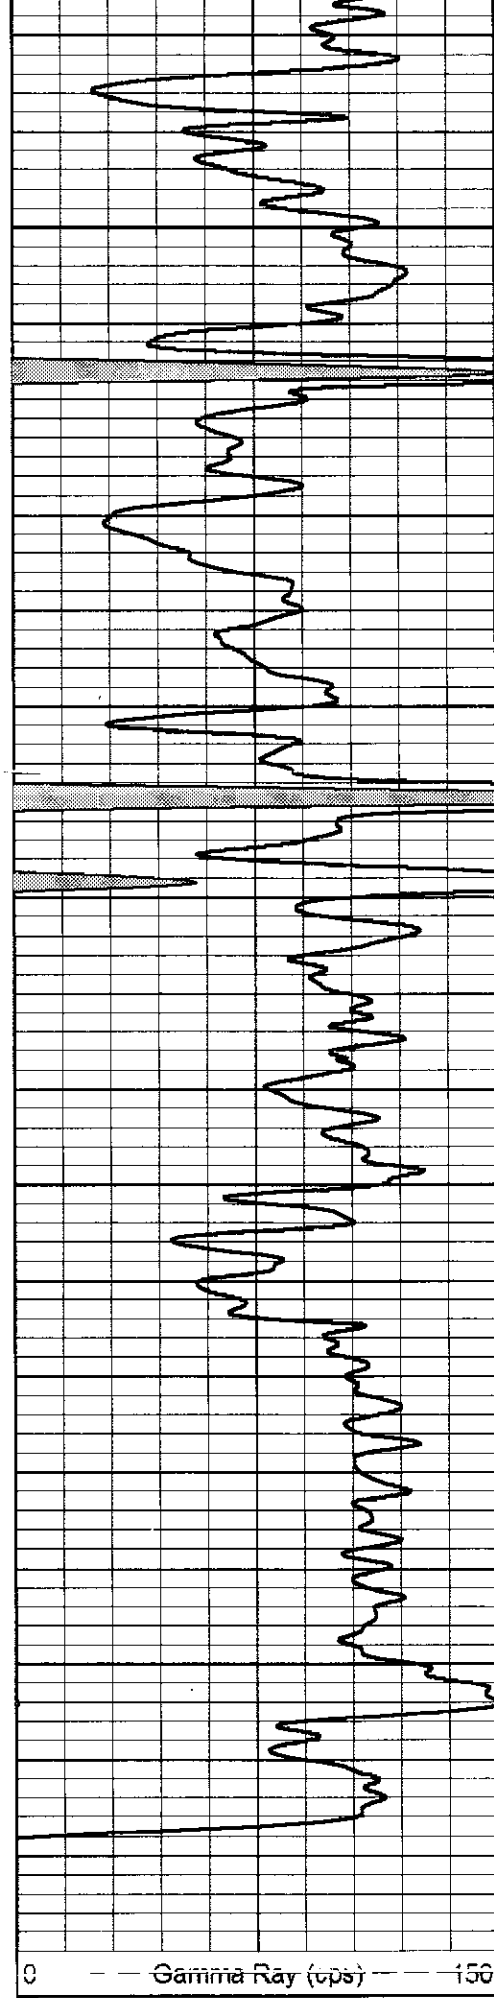

03-28-2022
Perforated Interval
955.0 - 964.0 28 Perfs
2" DML RTG 120° Phase

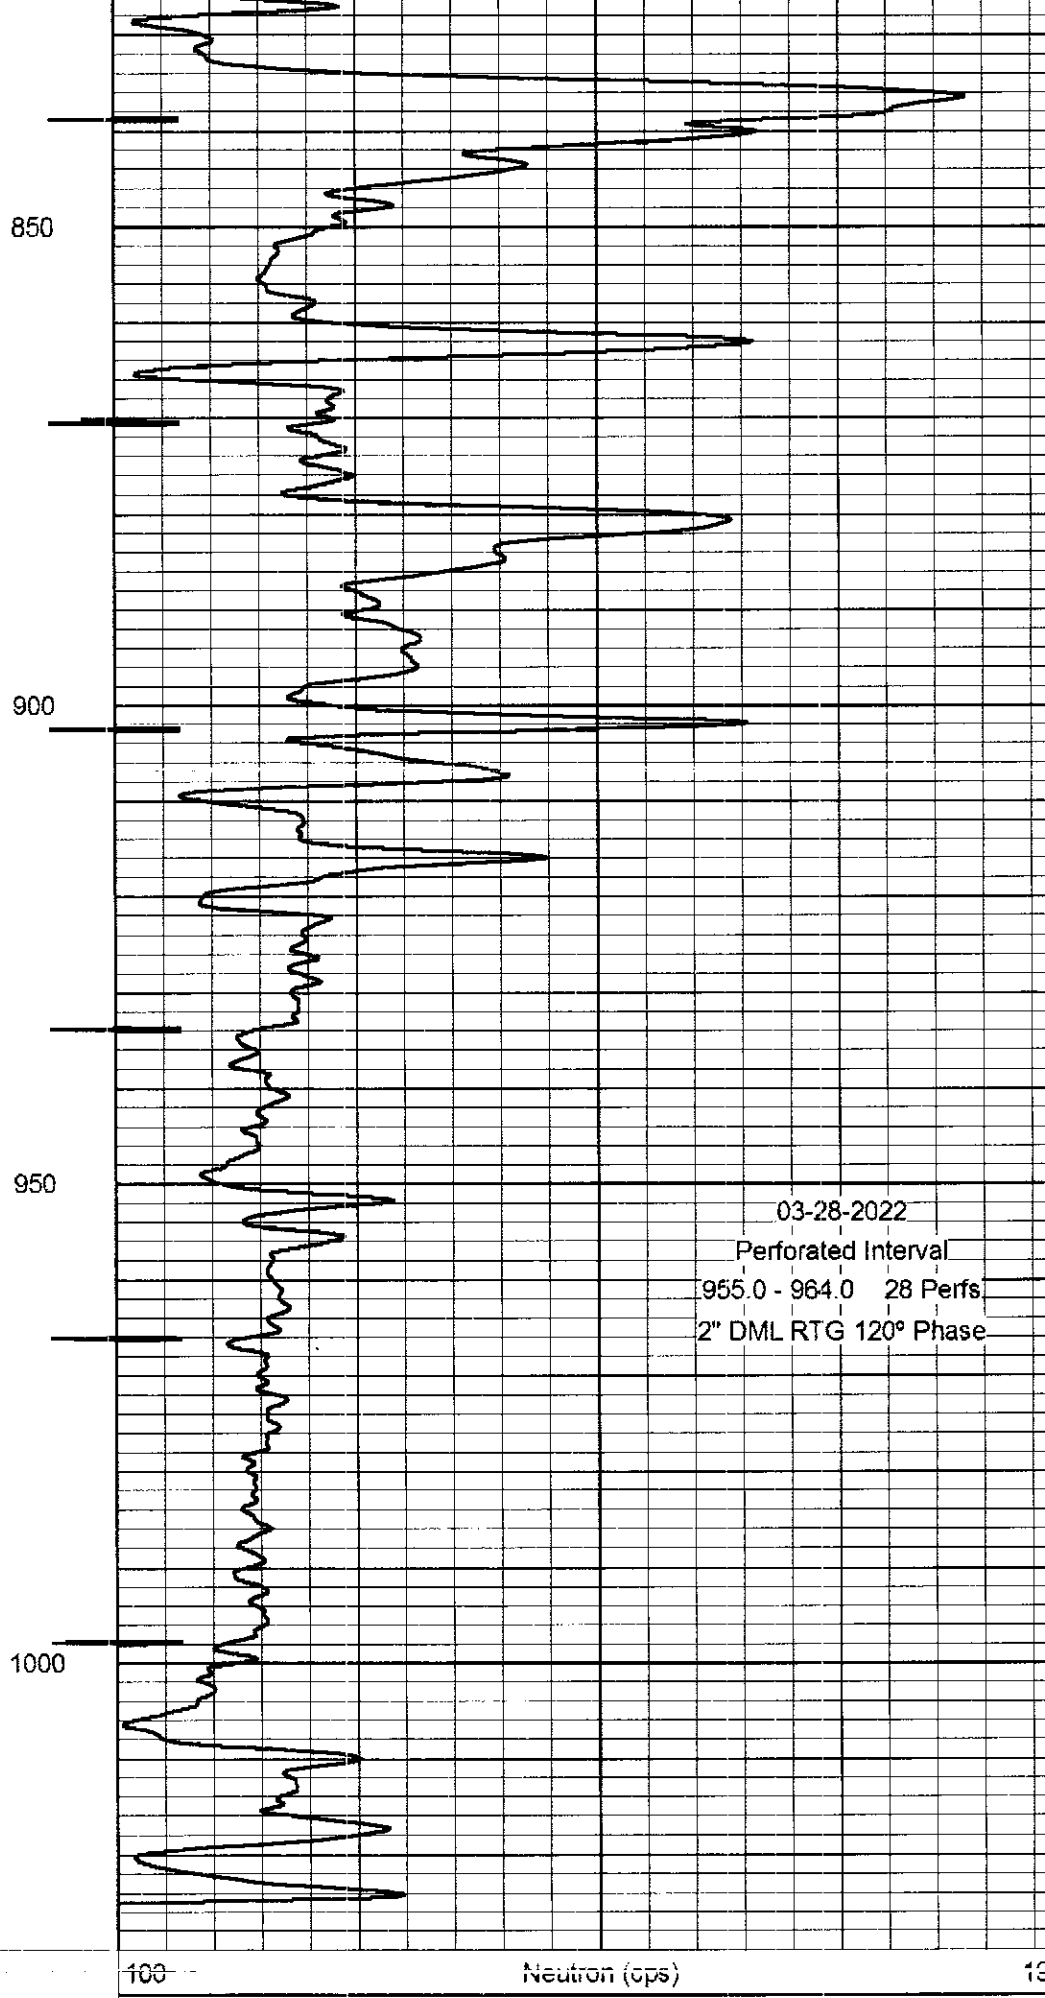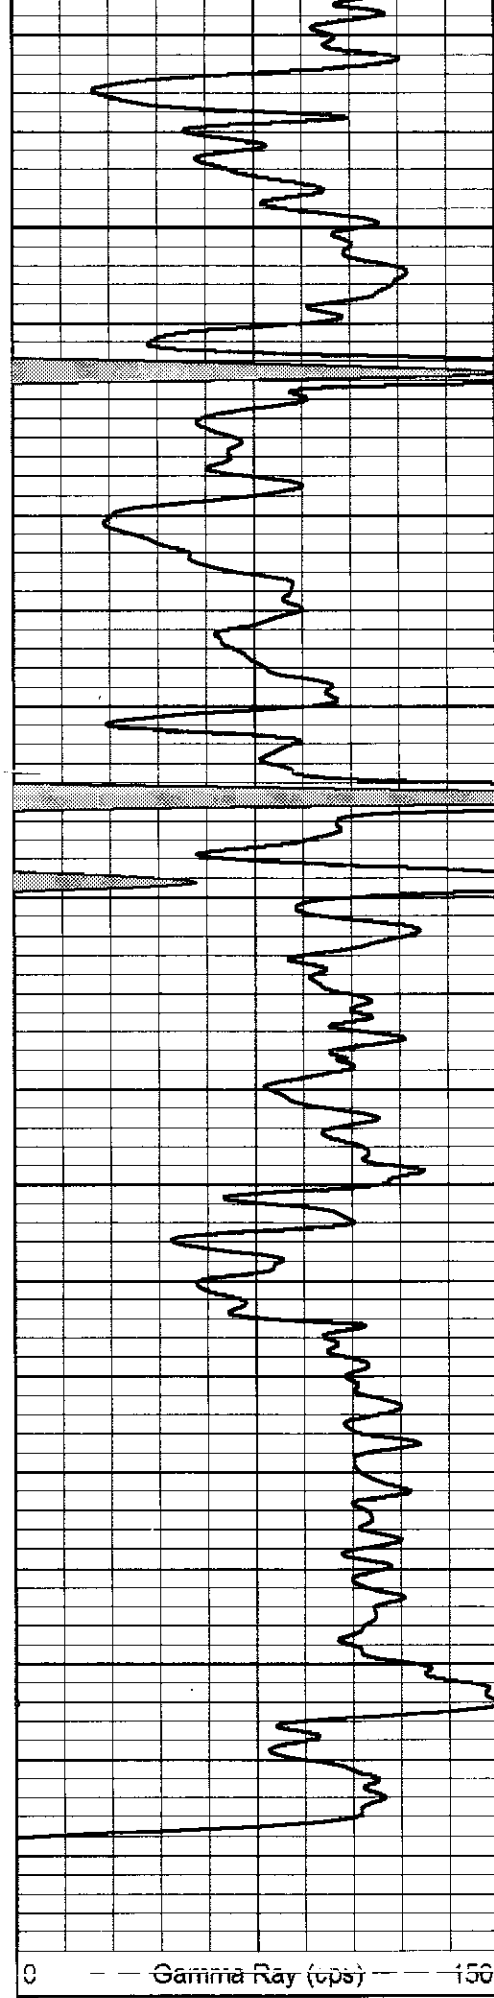

03-28-2022
Perforated Interval
955.0 - 964.0 28 Perfs
2" DML RTG 120° Phase