

**WATER WELL RECORD (WWC-5)**

KOLAR DOC ID \_\_\_\_\_ WELL ID \_\_\_\_\_

**LOCATION OF WATER WELL**

Latitude		Longitude		Section		Township		Range		E W	Fraction	¼	¼	¼
Datum		Elevation		County										

**WATER WELL OWNER**

Name	
Business	
Address	
Well location at owner's address	

**WELL WATER USE**

--

**WELL INFORMATION**

Depth of well: _____ ft.
Dry well
Static water level in well: _____ ft. measured below land surface on (mm/dd/yy): _____
measured above land surface on (mm/dd/yy): _____

**PERMIT & ID NUMBERS (AS REQUIRED)**

DWR Application No.: _____
KDHE / EPA Project Code: _____
Site Name: _____
KDHE UIC Class V Form Completed: Yes No
County Permit: Yes No Permit ID: _____
Lease Name & Well #: _____
# of boreholes: _____ # of dewatering wells: _____

**CASING**

Type of blank casing used: _____
Casing type details: _____
Blank casing diameter: _____ inches
Was casing removed? Yes No
Top of casing is currently _____ feet _____ ground
Reason required if top of casing is now less than 5 feet below ground surface for a hand dug well or less than 3 feet below ground surface for all other types of wells.

**GROUT & PLUGGING MATERIALS**

Grout or Plugging interval (ft.)		Material	Description
From	To		

**COMMENTS**

--


**CONTRACTOR'S OR LANDOWNERS CERTIFICATION**

<p>This water well was plugged pursuant to the stated water well contractor's license and was completed on _____. I certify that this record is true to the best of my knowledge and belief. This water well record was completed on _____ under the business name of _____, Kansas Water Well Contractor's License No. _____ under the authority of the designated person as defined in K.A.R. 28-30-2(j) and signed and certified by the electronic signature of the designated person at its submittal _____.</p>
--

Send one copy to WATER WELL OWNER and retain one for your records.



CITY:\DEN-TECH\DIV\GROUP\ENV\GIS\DB:KKELLEY LD: PIC: PM: TM:  
 PROJECT: PATH: Z:\GIS\Projects\ENV\Union\_Pacific\Former\_FuelingFac\MDX2019\Fig2\_Former\_Site\_Features\_and Mon\_Well\_Network.mxd

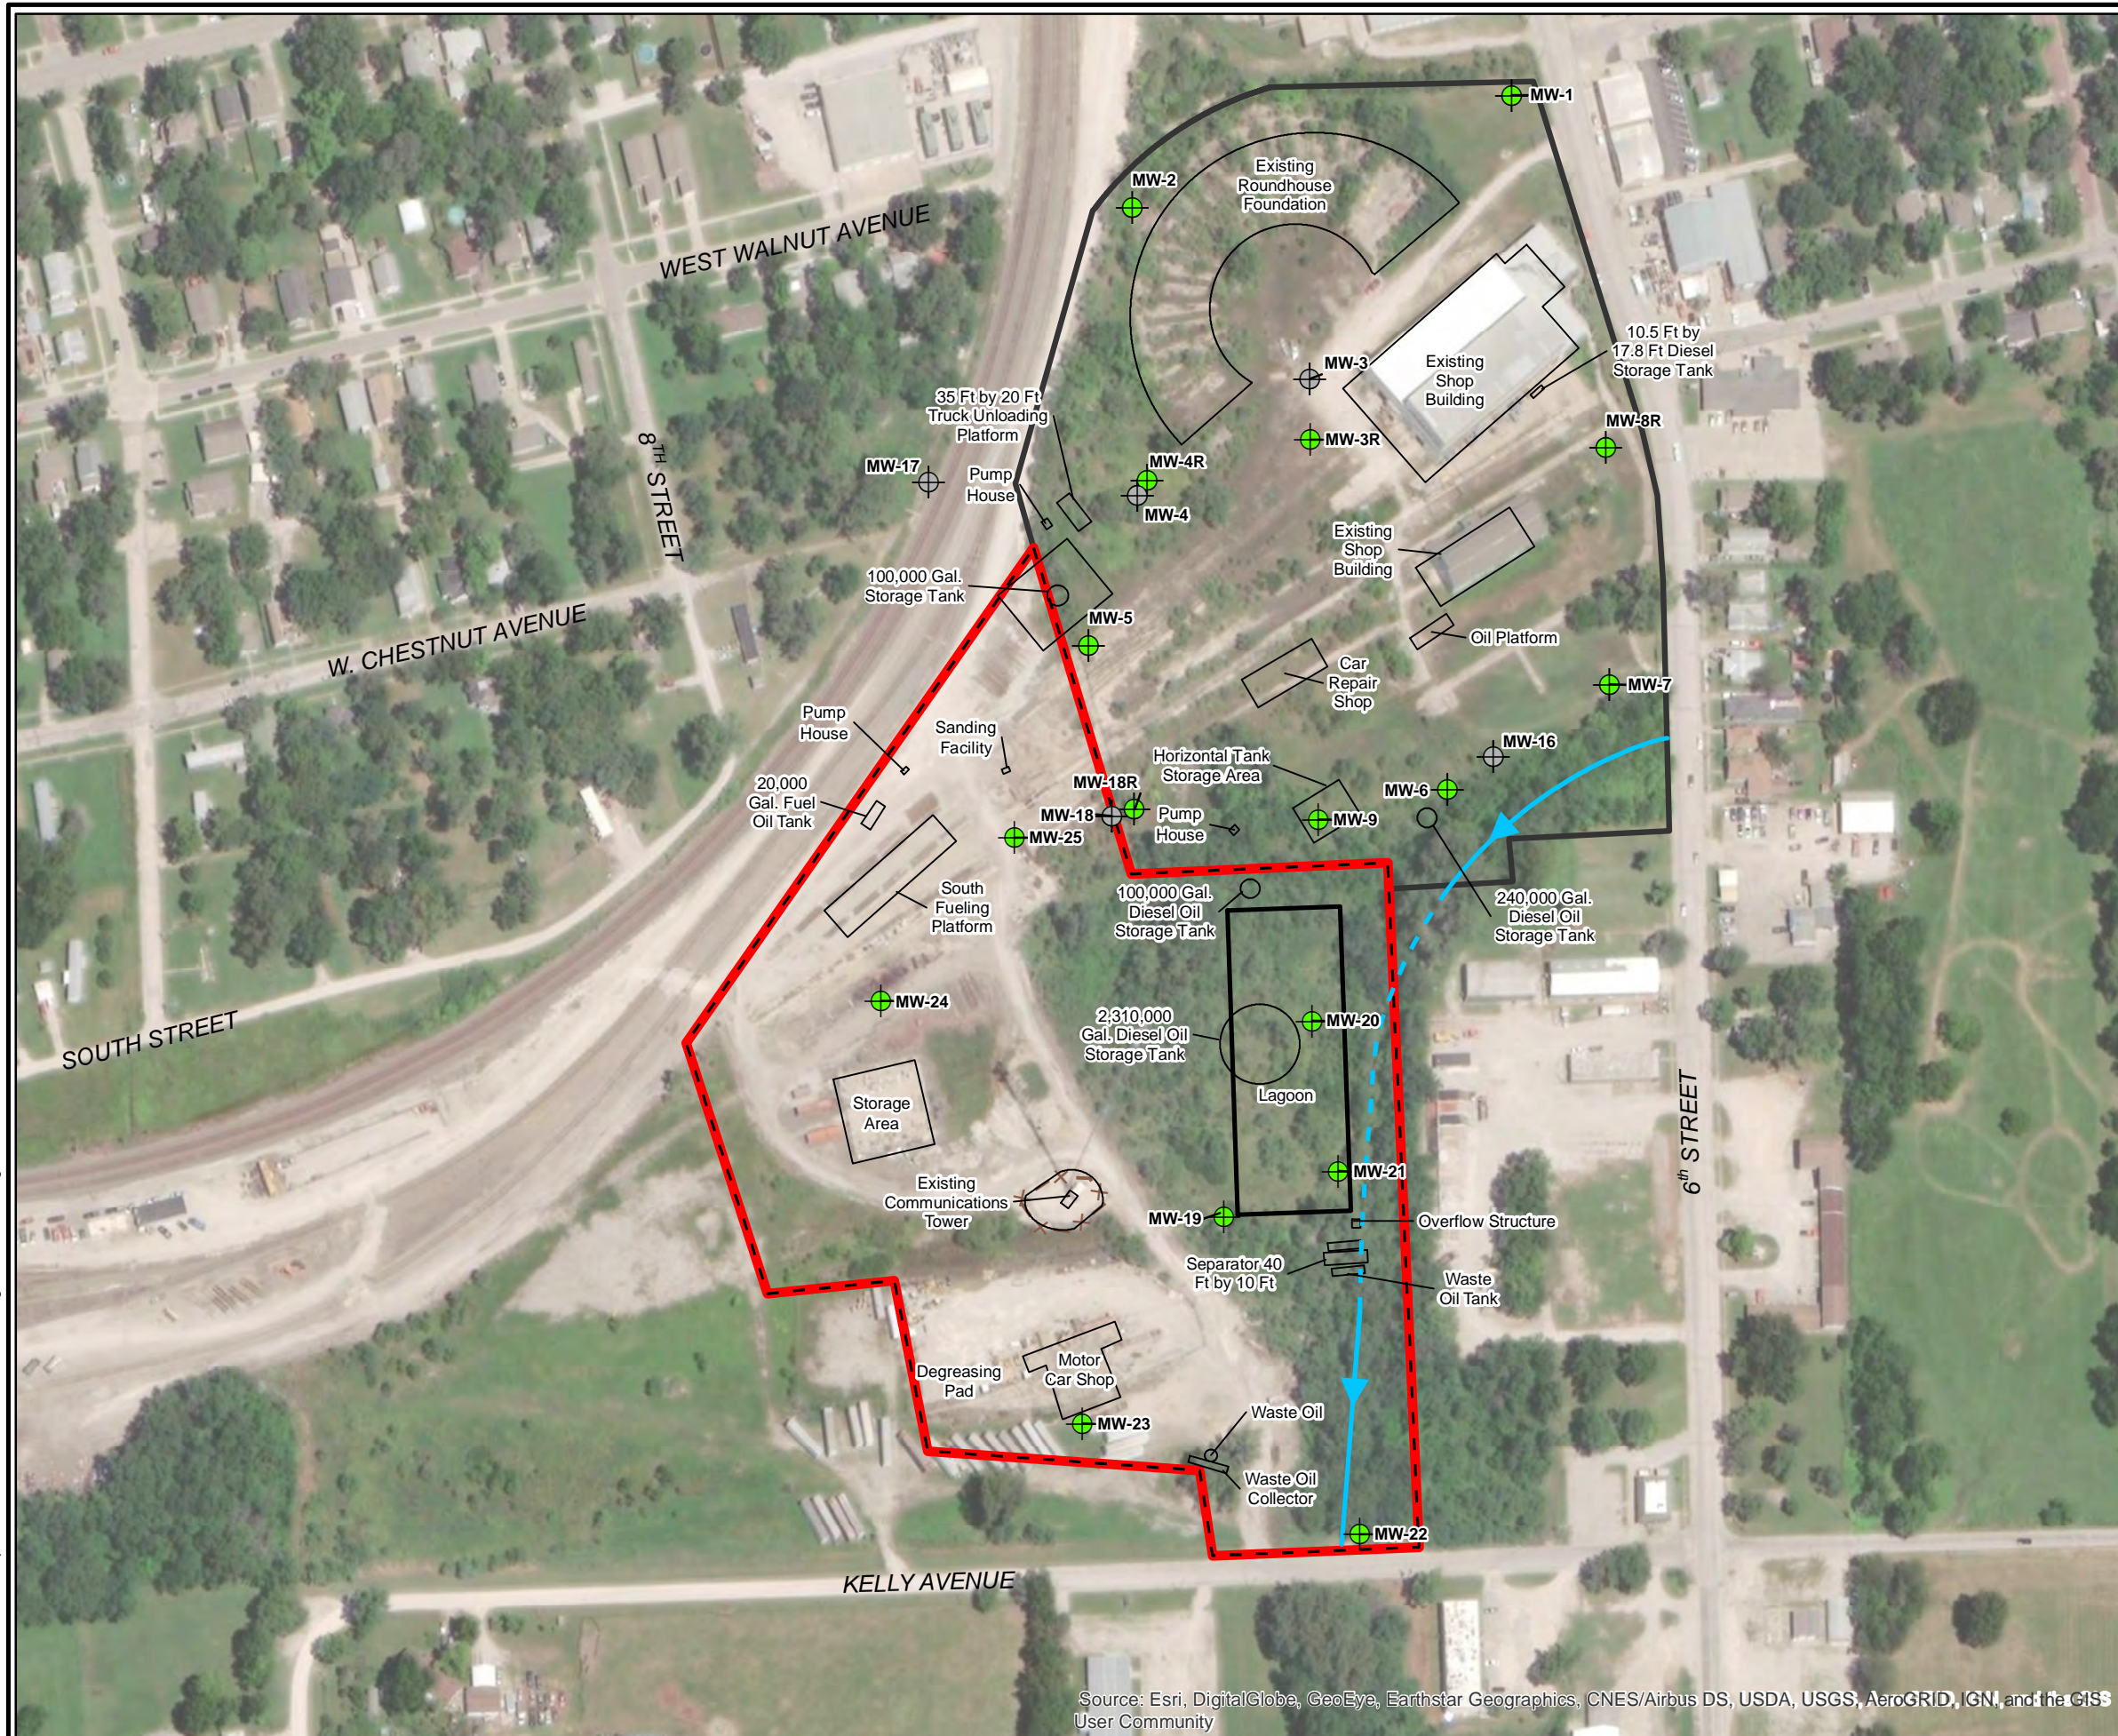

**LEGEND:**

- MONITORING WELL
- ABANDONED MONITORING WELL
- DRAINAGE DITCH
- DRAINAGE DITCH FLOW DIRECTION
- INTERMITTENT SECTION OF DRAINAGE DITCH
- FENCE
- SITE FEATURES
- FORMER FUELING FACILITY AND SHOP VOLUNTARY CLEANUP PROGRAM BOUNDARY
- FORMER MP YARD VOLUNTARY CLEANUP PROGRAM BOUNDARY



SCALE IN FEET



FORMER MP YARD/FUELING FACILITY AND SHOP  
 OSAWATOMIE, KANSAS

**MONITORING WELL LOCATIONS**

Source: Esri, DigitalGlobe, GeoEye, Earthstar Geographics, CNES/Airbus DS, USDA, USGS, AeroGRID, IGN, and the GIS User Community