

WATER WELL RECORD (WWC-5)

KOLAR DOC ID _____ WELL ID _____
 Original Record Correction Change in Well Use

LOCATION OF WATER WELL

Latitude		Longitude		Section		Township		Range		E W	Fraction	¼	¼	¼
Datum		Elevation		County										

WATER WELL OWNER

Name	
Business	
Address	
Well location	
at owner's address	

WELL WATER USE

--

COMPLETION

Depth of completed well: _____ ft.
Depth(s) groundwater encountered:
(1) _____ ft.; (2) _____ ft.;
(3) _____ ft.; (4) dry well
Static water level in well: _____ ft.
measured below land surface
on (mm/dd/yy): _____
measured above land surface
on (mm/dd/yy): _____
Estimated yield: _____ gpm
Water level was: _____ ft. after _____ hours
pumping _____ gpm
Pump installed? Yes No
Water well disinfected? Yes No
Date disinfected (mm/dd/yy): _____
Aquifer, if known:

NEAREST SOURCE OF POTENTIAL CONTAMINATION

Source: _____
Distance from well: _____ Direction from well: _____
Source description: _____
Source: _____
Distance from well: _____ Direction from well: _____
Source description: _____
No potential source of contamination within 100 feet.

CONSTRUCTION

Borehole interval:	Borehole diameter:
from _____ to _____ ft.	_____ in.
from _____ to _____ ft.	_____ in.
Casing height above land surface: _____ in.	
If casing height is less than 12 in. has a variance been approved?* Yes No	
*variance not required for monitoring or environmental remediation wells	
Casing type: _____	
Blank casing interval: _____ ft. to _____ ft.	
Blank casing diameter: _____ in.	
Casing joints: _____	
Weight: _____ lbs/ft.	
Wall thickness or gauge no.: _____	
Blank casing interval: _____ ft. to _____ ft.	
Blank casing diameter: _____ in.	
Casing joints: _____	
Weight: _____ lbs/ft.	
Wall thickness or gauge no.: _____	
Grout interval: _____ ft. to _____ ft.	
Grout material: _____	
Grout interval: _____ ft. to _____ ft.	
Grout material: _____	
Screen / perforation material: _____	
Screen / perforation openings: _____	
Screen / perforation intervals:	
From _____ ft. to _____ ft.	
Slot size _____ unit _____	
From _____ ft. to _____ ft.	
Slot size _____ unit _____	
Gravel pack intervals:	
Gravel pack not used: Gravel size _____ in	
From _____ ft. to _____ ft.	
Gravel pack not used: Gravel size _____ in	
From _____ ft. to _____ ft.	

PERMIT & ID NUMBERS (AS REQUIRED)

DWR Application No.: _____
KDHE / EPA Project Code: _____
Site Name: _____
KDHE UIC Class V Form Completed: Yes No
County Permit: Yes No Permit ID: _____
Lease Name & Well #: _____
of boreholes: _____ # of dewatering wells: _____

LITHOLOGIC LOG

FROM	TO	LITHOLOGY INTERVALS

COMMENTS

--

CONTRACTOR'S OR LANDOWNERS CERTIFICATION

This water well was constructed reconstructed pursuant to the stated water well contractor's license and was completed on _____. I certify that this record is true to the best of my knowledge and belief. This water well record was completed on _____ under the business name of _____, Kansas Water Well Contractor's License No. _____ under the authority of the designated person as defined in K.A.R. 28-30-2(j) and signed and certified by the electronic signature of the designated person at its submittal: _____.

Send one copy to WATER WELL OWNER and retain one for your records. Fee of \$5.00 for each constructed well.

Form	WWC5.2 - Water Well Record
Doc ID	1677823
Well Owner	KDHE - BER
Contractor	GSI Engineering, LLC

Lithology

From	To	Lithology Intervals
0	.25	other, concrete
.25	7.5	clay-lean, slightly moist, low plasticity, medium softness, brown, no odor, no particulate
7.5	12.5	clay-lean, medium grained sand bits, light brown, slightly moist, low plasticity, medium stiffness, no odor, no particulate
12.5	17.5	clay, medium, sandy, slightly moist, low plasticity, soft, brown, no odor, no particulate, 12-13% chert
17.5	22.5	sand, coarse, slightly moist, no plasticity, loose, brown to lite brown, no odor, no particulate
22.5	25	sand, coarse, silt, slightly moist, no plasticity, loose, brown, no particulate, no odor
25	35	clay-lean, slightly moist, low plasticity, medium stiffness, lite brown, no odor, no particulate, darker brown with particulate at 30'
35	40	clay-lean, slightly moist, low plasticity, medium stiff to soft, brown, no odor, no particulate, 50% sand at 40'
40	47.5	sand, fine, brown, slightly moist, no plasticity, dense, has some odor, bits of gypsum

Form	WWC5.2 - Water Well Record
Doc ID	1677823
Well Owner	KDHE - BER
Contractor	GSI Engineering, LLC

Lithology

From	To	Lithology Intervals
47.5	52.5	clay-lean, slightly moist, low plasticity, medium stiff to soft, brown, has odor, some particulate, 15 % medium sand
52.5	60	sand, fine to medium, slightly moist, no plasticity, loose, brown, some odor, no particulate, water, medium to coarse with pebbles (5-10%) at 55'
60	65	sand, medium to coarse, has some odor, black to brown, some sheen




Legend

- = Property Line
- = Monitoring Well
- = Abandoned Monitoring Well
- = UST Basin
- = Proposed Monitoring Well



FIGURE: 1.0	FIGURE NAME: Site Base Map
DATE: 09/08/2022	PROJECT NUMBER: 2174136
DRAWN BY: PM	PROJECT MANAGER: R Edwards

Convenience Plus #8
 122 S. Central, Coldwater, Kansas
 KDHE #: U1-017-00255

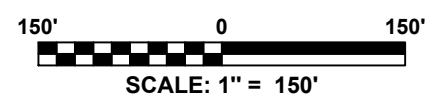

Sampled: 04/11/2022
 ND = Not Detect
 NS = Not Sampled
 Units = ug/L
 ALL LOCATIONS AND BOUNDARIES ARE APPROXIMATE