

**Notice:** Fill out COMPLETELY and return to Conservation Division at the address below within 60 days from plugging date.

KANSAS CORPORATION COMMISSION  
OIL & GAS CONSERVATION DIVISION

**WELL PLUGGING RECORD**

K.A.R. 82-3-117

Form CP-4

March 2009

**Type or Print on this Form**  
**Form must be Signed**  
**All blanks must be Filled**

OPERATOR: License #: \_\_\_\_\_  
 Name: \_\_\_\_\_  
 Address 1: \_\_\_\_\_  
 Address 2: \_\_\_\_\_  
 City: \_\_\_\_\_ State: \_\_\_\_\_ Zip: \_\_\_\_\_ + \_\_\_\_\_  
 Contact Person: \_\_\_\_\_  
 Phone: ( \_\_\_\_\_ ) \_\_\_\_\_  
 Type of Well: (Check one)  Oil Well  Gas Well  OG  D&A  Cathodic  
 Water Supply Well  Other: \_\_\_\_\_  SWD Permit #: \_\_\_\_\_  
 ENHR Permit #: \_\_\_\_\_  Gas Storage Permit #: \_\_\_\_\_  
 Is ACO-1 filed?  Yes  No If not, is well log attached?  Yes  No  
 Producing Formation(s): List All (If needed attach another sheet)  
 \_\_\_\_\_ Depth to Top: \_\_\_\_\_ Bottom: \_\_\_\_\_ T.D. \_\_\_\_\_  
 \_\_\_\_\_ Depth to Top: \_\_\_\_\_ Bottom: \_\_\_\_\_ T.D. \_\_\_\_\_  
 \_\_\_\_\_ Depth to Top: \_\_\_\_\_ Bottom: \_\_\_\_\_ T.D. \_\_\_\_\_

API No. 15 - \_\_\_\_\_  
 Spot Description: \_\_\_\_\_  
 \_\_\_\_\_ - \_\_\_\_\_ - \_\_\_\_\_ - \_\_\_\_\_ Sec. \_\_\_\_\_ Twp. \_\_\_\_\_ S. R. \_\_\_\_\_  East  West  
 \_\_\_\_\_ Feet from  North /  South Line of Section  
 \_\_\_\_\_ Feet from  East /  West Line of Section  
 Footages Calculated from Nearest Outside Section Corner:  
 NE  NW  SE  SW  
 County: \_\_\_\_\_  
 Lease Name: \_\_\_\_\_ Well #: \_\_\_\_\_  
 Date Well Completed: \_\_\_\_\_  
 The plugging proposal was approved on: \_\_\_\_\_ (Date)  
 by: \_\_\_\_\_ (KCC District Agent's Name)  
 Plugging Commenced: \_\_\_\_\_  
 Plugging Completed: \_\_\_\_\_

Show depth and thickness of all water, oil and gas formations.


Oil, Gas or Water Records		Casing Record (Surface, Conductor & Production)			
Formation	Content	Casing	Size	Setting Depth	Pulled Out

Describe in detail the manner in which the well is plugged, indicating where the mud fluid was placed and the method or methods used in introducing it into the hole. If cement or other plugs were used, state the character of same depth placed from (bottom), to (top) for each plug set.

Plugging Contractor License #: \_\_\_\_\_ Name: \_\_\_\_\_  
 Address 1: \_\_\_\_\_ Address 2: \_\_\_\_\_  
 City: \_\_\_\_\_ State: \_\_\_\_\_ Zip: \_\_\_\_\_ + \_\_\_\_\_  
 Phone: ( \_\_\_\_\_ ) \_\_\_\_\_  
 Name of Party Responsible for Plugging Fees: \_\_\_\_\_  
 State of \_\_\_\_\_ County, \_\_\_\_\_, ss.  
 \_\_\_\_\_  Employee of Operator or  Operator on above-described well,  
 (Print Name)

being first duly sworn on oath, says: That I have knowledge of the facts statements, and matters herein contained, and the log of the above-described well is as filed, and the same are true and correct, so help me God.

**Submitted Electronically**

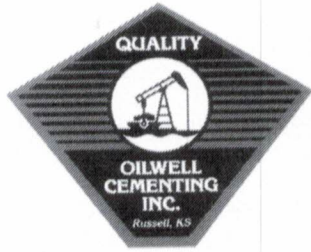

**QUALITY OILWELL CEMENTING, INC.**  
 PO Box 32 - 740 West Wichita Ave, Russell KS 67665  
 Phone:785-324-1041 fax:785-483-1087  
 Email: cementing@ruraltel.net

**Date:** 4/28/2023  
**Invoice #** 3531  
**P.O.#:**  
**Due Date:** 5/28/2023  
**Division:** Russell

# Invoice

**Contact:**  
 Mai Oil Operations  
**Address/Job Location:**

8411 Preston Rd. Ste 800  
 Dallas TX 75225-5520

**Reference:**  
 RICHARDS 6-1

**Description of Work:**  
 PLUG JOB

Services / Items Included:	Quantity	Price	Taxable	Item	Quantity	Price	Taxable
Labor		\$ 869.52	Yes				
Common-Class A	183	\$ 3,673.96	Yes				
POZ Mix-Standard	122	\$ 832.29	Yes				
Premium Gel (Bentonite)	16	\$ 452.20	Yes				
Cottonseed Hulls	10	\$ 328.43	Yes				
Bulk Truck Matl-Material Service Charge	325	\$ 316.74	Yes				
Pump Truck Mileage-Job to Nearest Camp	33	\$ 144.72	Yes				
Bulk Truck Mileage-Job to Nearest Bulk Plant	33	\$ 112.56	Yes				

**Invoice Terms:**

Net 30

	<i>SubTotal:</i>	\$ 6,730.42
	<i>Discount Available ONLY if Invoice is Paid &amp; Received within listed terms of invoice:</i>	\$ (168.26)
<hr/>		
	SubTotal for Taxable Items:	\$ 6,562.16
	SubTotal for Non-Taxable Items:	\$ -
<hr/>		
	Total:	\$ 6,562.16
	Tax:	\$ 459.35
<hr/>		
	<b>Amount Due:</b>	<b>\$ 7,021.51</b>

7.00% Ellis County Sales Tax

**Thank You For Your Business!**

**Applied Payments:**  
**Balance Due: \$ 7,021.51**

Past Due Invoices are subject to a service charge (annual rate of 24%)  
 This does not include any applicable taxes unless it is listed.  
 ©2008-2013 Straker Investments, LLC. All rights reserved.

# QUALITY OILWELL CEMENTING, INC.

Federal Tax I.D.# 20-2886107

No. **3531**

Phone 785-483-1071

Home Office P.O. Box 32 Russell, KS 67665

Cell 785-324-1041

Date	4-28-23	Sec.	Twp.	Range	County	State	On Location	Finish
					Ellis	Ks		
Location					Ellis Autocoline 2015 IN 1SE			

Lease	Richards	Well No.	6-1	Owner	To Quality Oilwell Cementing, Inc.
Contractor	Rocket	You are hereby requested to rent cementing equipment and furnish cementer and helper to assist owner or contractor to do work as listed.			
Type Job	PTA	Charge To	MAT OIL		
Hole Size		T.D.			
Csg.	5 1/2	Depth			
Tbg. Size	2 3/8	Depth			
Tool		Depth	The above was done to satisfaction and supervision of owner agent or contractor.		
Cement Left in Csg.		Shoe Joint	Cement Amount Ordered 3253 6440-4		
Meas Line		Displace	500# Gel 500# Hulls		

**EQUIPMENT**

Pumptrk	17	No.	Cementor	Bill	Common	183
			Helper		Poz. Mix	122
Bulktrk		No.	Driver	JORDAN	Gel.	16
			Driver		Calcium	
Bulktrk	Ros 17	No.	Driver	ROSS	Hulls	500# (10)
			Driver		Salt	

**JOB SERVICES & REMARKS**


Remarks:	
Rat Hole	Flowseal
Mouse Hole	Kol-Seal
Centralizers	Mud CLR 48
Baskets	CFL-117 or CD110 CAF 38
D/V or Port Collar	Sand
3050 - 500# Gel 7 Sry cement 300 Hulls	Handling 325
2050 - 150# 200# Hull	Mileage
1050 - 6 Sry Circ Cent	

**FLOAT EQUIPMENT**

	Guide Shoe
	Centralizer
	Baskets
	AFU Inserts
	Float Shoe
	Latch Down

Top off 150#  
Back side 0 300#  
  
Used  
500# Gel  
500# Hulls  
305# cement

Pumptrk Charge	plug	Tax
Mileage	33	Discount
Total Charge		

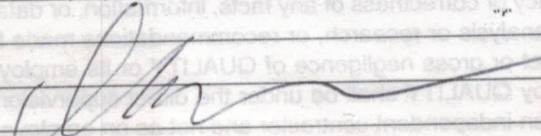X Signature 

Thanks