KOLAR Document ID: 1727431

WATER WELL RECORD (WWC-5)

KOLAR DOC ID

Source: _ Distance

from well:

Source description: Source:

F

Correction

Original Record

WELL ID_____ Change in Well Use

LOCATION OF WATER WELL

Latitude	Longitude	Section	Township	Range	E W	Fraction	1⁄4	1⁄4	1⁄4
Datum	Elevation	County							

WATER WELL OWNER

Name	
Business	
Address	
Well location	
at owner's address	
CONCERNICE	

CONSTRUCTION

Borehole interval:	Borehole diameter:
fromtoft.	in.
fromtoft.	in.
Casing height above land su	
If casing height is less th has a variance been app	roved?* Yes No
*variance not required for or environmental reme	
Casing type:	
Blank casing interval:	ft. toft.
Blank casing diameter:	in.
Casing joints:	
Weight:lbs	s/ft.
Wall thickness or gauge	no.:
Blank casing interval:	ft. toft.
Blank casing diameter:	
Casing joints:	
Weight:lbs	s/ft.
Wall thickness or gauge	
Grout interval: ft. to	oft.
Grout material:	
Grout interval: ft. to	oft.
Grout material:	
Screen / perforation material	:
Screen / perforation opening	gs:
Screen / perforation intervals	S:
Fromft. to	_ft.
Slot size unit	
Fromft. to	_ft.
Slot size unit	
Gravel pack intervals:	
Gravel pack not used:	Gravel size in
From ft. to	
Gravel pack not used:	
From ft. to	

	County								
WELL WATER USE									
сом	PLETION								
Dep	th of comp	leted w	ell:		ft				
-	-		encountere						
(1)_	ft.;								
(3) _	ft.;	(4)	dry well						
Stati	c water leve	el in we	ell:	_ft.					
	neasured bo n (mm/dd/		nd surface						
	neasured al on (mm/dd		nd surface						
Estir	nated yield	:	gpm						
Wate	er level was	:	ft. after		hours				
			pumping		gpm				
Pum	p installed	? Ye	es No						

Yes No

Distance from well:	Direction from well:
Source description:	
No potential source within 100 feet.	e of contamination
PERMIT & ID NUMBER	S (AS REQUIRED)
DWR Application No.: KDHE / EPA Project C	 Code:
Site Name:	
KDHE UIC Class V Fo	orm Completed: Yes No
County Permit: Yes	No Permit ID:
Lease Name & Well #:	
# of boreholes:	# of dewatering wells:

NEAREST SOURCE OF POTENTIAL CONTAMINATION

Direction

from well:

Aquifer, if known:

Water well disinfected?

Date disinfected (mm/dd/yy):

ALS

COMMENTS

CONTRACTOR'S OR LANDOWNERS CERTIFICATION


This water well was constructed	reconstructed	pursuant to the stated water well
contractor's license and was complete	ed on	I certify that this record is true to
the best of my knowledge and belief.	This water well rec	ord was completed on
under the business name of		,
Kansas Water Well Contractor's Licer	nse No	_ under the authority of the designated
person as defined in K.A.R. 28-30-2(j) and signed and c	ertified by the electronic signature of the
designated person at its submittal:		·
Send one copy to WATER WELL OWNER a	and retain one for you	r records. Fee of \$5.00 for each constructed well.
KANSAS DEPAR	TMENT OF HEALTH	AND ENVIRONMENT


Bureau of Water, Geology Section, 1000 SW Jackson St., Suite 420, Topeka KS 66612-1367 (785) 296-3565 | K.S.A. 82a-1212 | v2022c


									T			
HTRW DRILLI	NG LO	G 📑	STRICT						HOL			
HTDRD GED LOGIC				DRILL SUBCONTRACTOR SHEET SHEETS								
WATE PHASE I PFAS RA				4.LOCATION								
5. NAME OF DRILLER T. NASTA				6. MANUF ACTURER'S DESIGNATION OF DRILL DT LS2-50								
7. SIZES AND TYPES OF DRILLING AND SAMPLING EQUIPMENT				8. HOLE LOCATION 9. SURFACE ELEVATION								
12. OVERBURDEN THICKNESS 35.0			15, DEPTH GROUNDWATER ENCOUNTERED ATD									
13.DEPTH DRILLED INTO ROCK	.0		16.DEPTH TO WATER AND ELAPSED TIME AFTER DRILLING COMPLETED									
14.TOTAL DEPTH OF HOLE	5.0		17.OTHER	WATER	R LEVEL MEA	SUREMENT	S (SPECI	FY)				
18.GEOTECHNICAL SAMPLES	DISTURBED			ED	19. TOTAL	NUMBER O	F CORE B	OXES				
20.SAMPLES FOR CHEMICAL ANALYSIS	VOC	МЕ	ETALS	OTHER	(SPECIFY)	OTHER (SPEC(FY)	OTHER (SPECIFY	21. TOL AL RECOV		
22.DISPOSITION OF HOLE	BACKFILLED	MONITO	RING WELL	OTHER	(SPECIFY)	23.516	HURE OF	INSPECTO	R			
LOCATION SKETCH/COMMENTS			~				SC	ALE				
PROJECT				<u>.</u>	10 <u>10</u>	<u>1 - i -</u>	HOLE	NO.		- <u></u> î-		

ENG FORM 5056-R. AUG 94

J

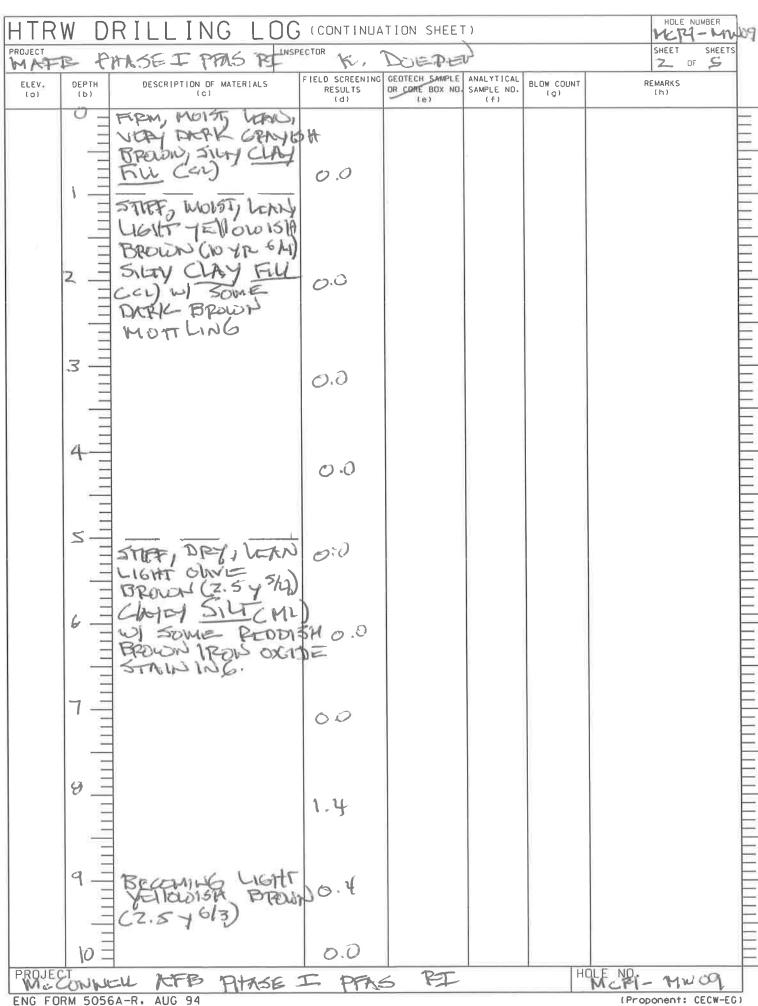

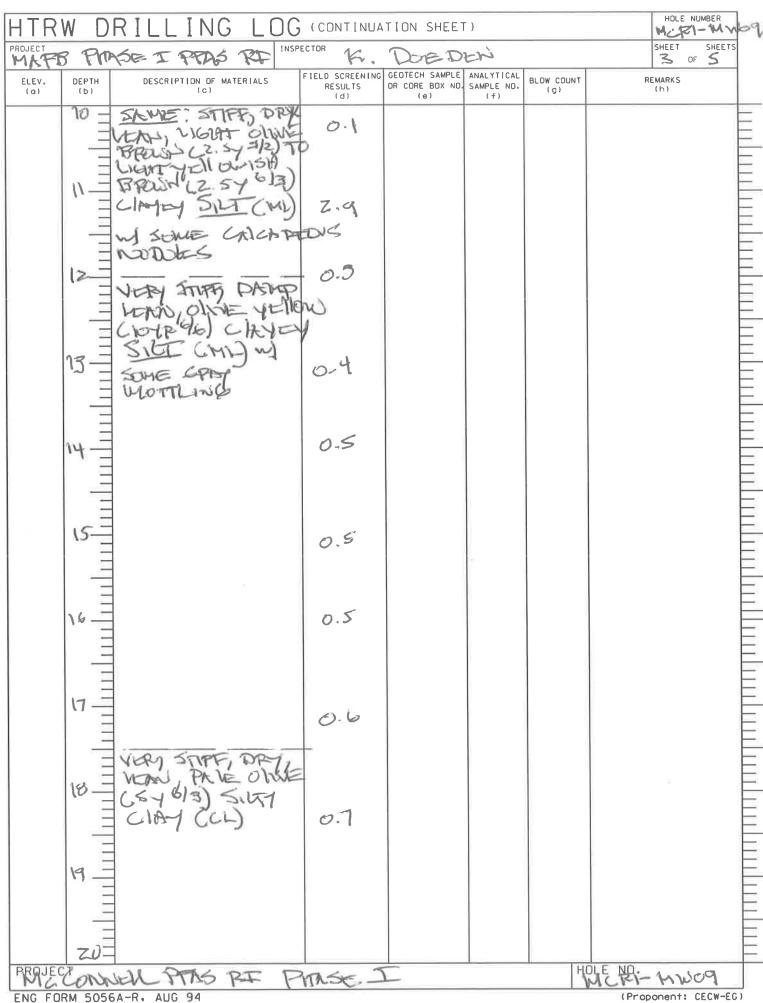

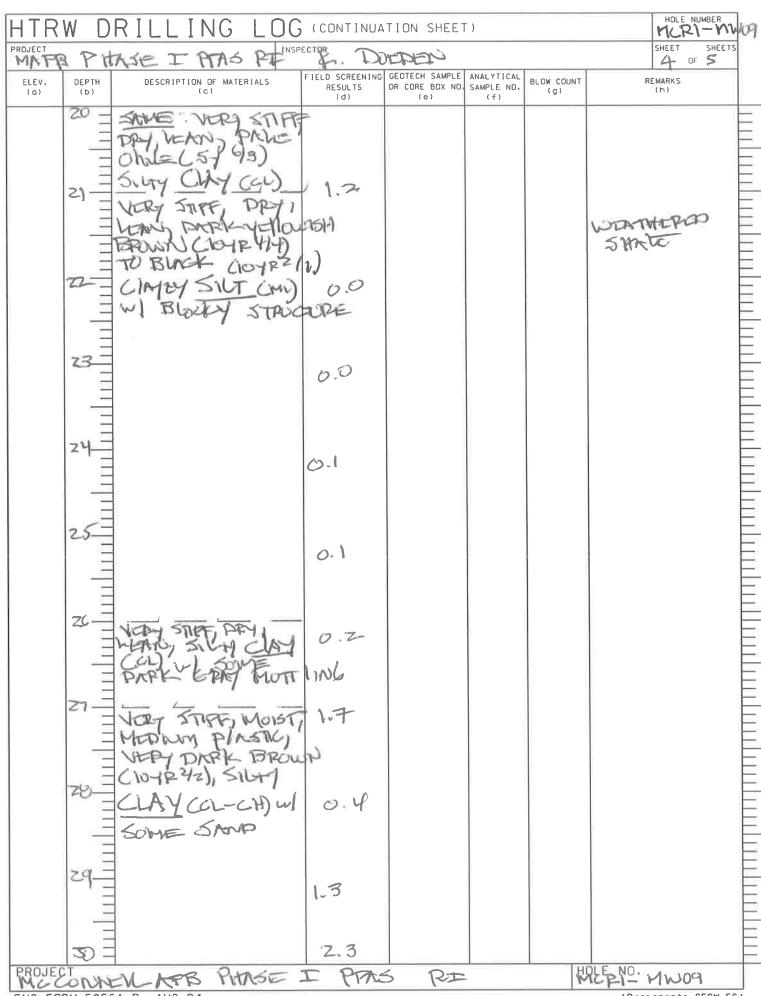

ENG FORM 5056A-R. AUG 94

(Proponent: CECW-EG)

