


Form	ACO1 - Well Completion
Operator	Magellan Pipeline Company LP
Well Name	CIN MP 8 1
Doc ID	1743327

Casing

Purpose Of String	Size Hole Drilled	Size Casing Set	Weight	Setting Depth	Type Of Cement	Number of Sacks Used	Type and Percent Additives
Surface	16	10	11.09	20	Bentonite	16	0

Magellan Pipelines

CIN MP 8

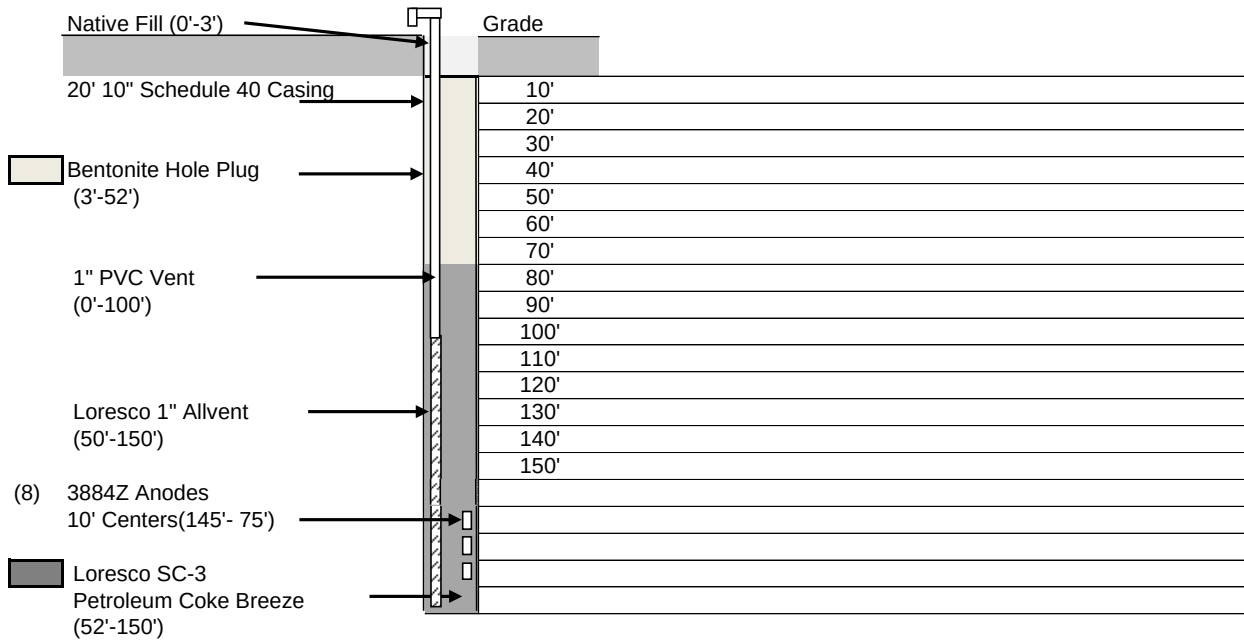

CATHODIC PROTECTION HOLE COMPLETION DIAGRAM & DRILL LOG

Installed by:

Strike




Installed for: Magellan Pipeline Company LP

Date: 10/31/2023

Location: CIN MP 8 Borehole #1

GPS: 37.138437 -95.69488

Technician: Jay Muse

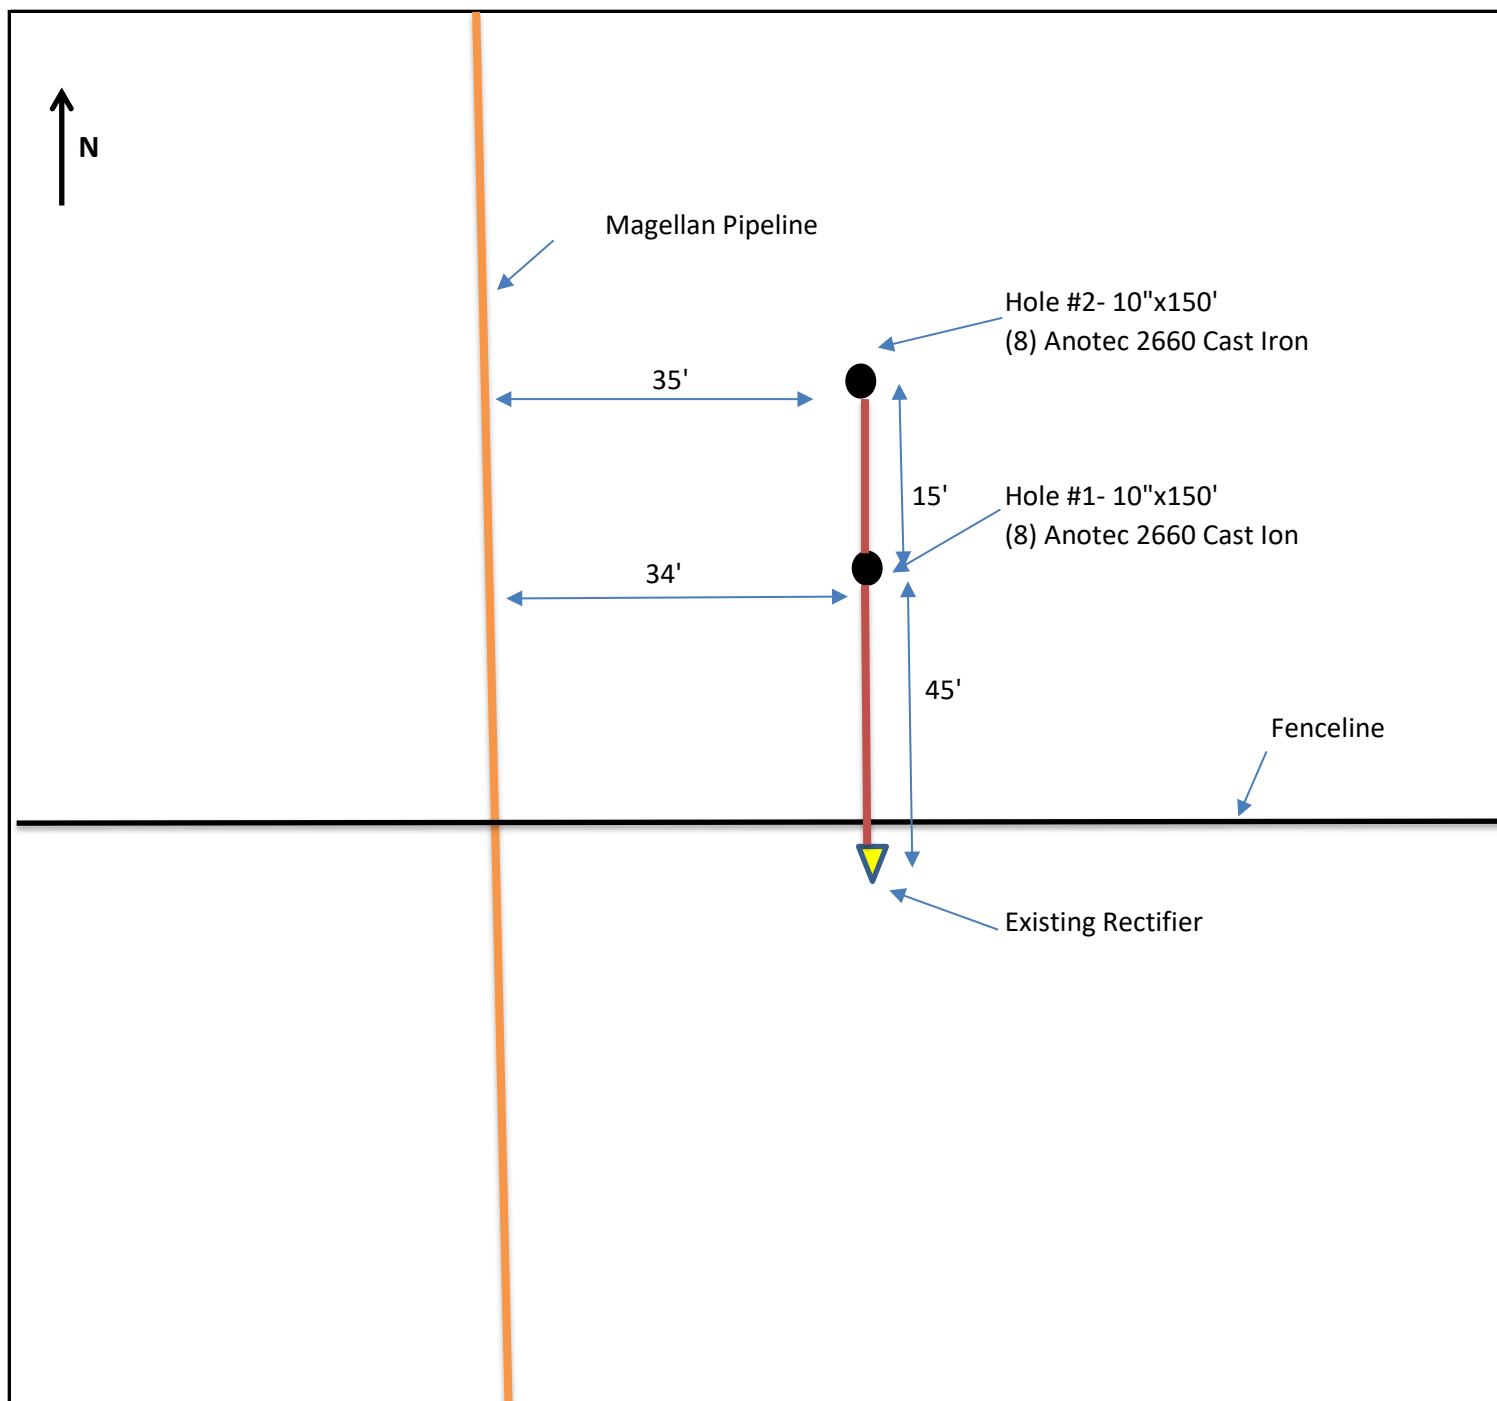

Hole Dia.:	10	Total Depth:	150'
No. Anodes:	8	Anode Size and Type:	2660

	CATHODIC PROTECTION INSTALLATION	
	CIN MP 8 Montgomery County Kansas	Installed For: <i>Magellan Midstream Partners</i>
		System: <i>CIN</i>
		Location: <i>CIN MP 8</i>
		GPS Location: <i>37.138437 --95.694886</i>
	Drawn By: <i>Dru Robertson</i>	
	Install Date: <i>10/31/2023</i>	

