

WATER WELL RECORD (WWC-5)

KOLAR DOC ID _____ WELL ID _____
 Original Record Correction Change in Well Use

LOCATION OF WATER WELL

Latitude		Longitude		Section		Township		Range		E W	Fraction	¼	¼	¼
Datum		Elevation		County										

WATER WELL OWNER

Name	
Business	
Address	
Well location at owner's address	

WELL WATER USE

--

COMPLETION

Depth of completed well: _____ ft.
Depth(s) groundwater encountered: (1) _____ ft.; (2) _____ ft.; (3) _____ ft.; (4) dry well
Static water level in well: _____ ft. measured below land surface on (mm/dd/yy): _____ measured above land surface on (mm/dd/yy): _____
Estimated yield: _____ gpm
Water level was: _____ ft. after _____ hours pumping _____ gpm
Pump installed? Yes No
Water well disinfected? Yes No
Date disinfected (mm/dd/yy): _____
Aquifer, if known:

NEAREST SOURCE OF POTENTIAL CONTAMINATION

Source: _____
Distance from well: _____ Direction from well: _____
Source description: _____
Source: _____
Distance from well: _____ Direction from well: _____
Source description: _____
No potential source of contamination within 100 feet.

CONSTRUCTION

Borehole interval: from _____ to _____ ft.	Borehole diameter: _____ in.
from _____ to _____ ft.	_____ in.
Casing height above land surface: _____ in.	
If casing height is less than 12 in. has a variance been approved?* Yes No	
*variance not required for monitoring or environmental remediation wells	
Casing type: _____	
Blank casing interval: _____ ft. to _____ ft.	
Blank casing diameter: _____ in.	
Casing joints: _____	
Weight: _____ lbs/ft.	
Wall thickness or gauge no.: _____	
Blank casing interval: _____ ft. to _____ ft.	
Blank casing diameter: _____ in.	
Casing joints: _____	
Weight: _____ lbs/ft.	
Wall thickness or gauge no.: _____	
Grout interval: _____ ft. to _____ ft.	
Grout material: _____	
Grout interval: _____ ft. to _____ ft.	
Grout material: _____	
Screen / perforation material: _____	
Screen / perforation openings: _____	
Screen / perforation intervals: From _____ ft. to _____ ft.	
Slot size _____ unit _____	
From _____ ft. to _____ ft.	
Slot size _____ unit _____	
Gravel pack intervals: Gravel pack not used: Gravel size _____ in	
From _____ ft. to _____ ft.	
Gravel pack not used: Gravel size _____ in	
From _____ ft. to _____ ft.	

PERMIT & ID NUMBERS (AS REQUIRED)

DWR Application No.: _____
KDHE / EPA Project Code: _____
Site Name: _____
KDHE UIC Class V Form Completed: Yes No
County Permit: Yes No Permit ID: _____
Lease Name & Well #: _____
of boreholes: _____ # of dewatering wells: _____

LITHOLOGIC LOG

FROM	TO	LITHOLOGY INTERVALS

COMMENTS

--

CONTRACTOR'S OR LANDOWNERS CERTIFICATION

This water well was constructed reconstructed pursuant to the stated water well contractor's license and was completed on _____. I certify that this record is true to the best of my knowledge and belief. This water well record was completed on _____ under the business name of _____, Kansas Water Well Contractor's License No. _____ under the authority of the designated person as defined in K.A.R. 28-30-2(j) and signed and certified by the electronic signature of the designated person at its submittal: _____.

Send one copy to WATER WELL OWNER and retain one for your records. Fee of \$5.00 for each constructed well.

Form	WWC5.2 - Water Well Record
Doc ID	1761824
Well Owner	Kaw Valley Drainage Dist.
Contractor	Griffin Dewatering, LLC

Lithology

From	To	Lithology Intervals
0	26	fill (man-made material),very fine,clayey,very light,brownish,brown,dry,soft,not cemented
26	27	sand,medium,light,brownish,brown,dry,loose,not cemented
27	30	sand,fine,clayey,light,brownish,brown,dry,loose,not cemented
30	36	sand,fine to medium,clayey,light,brownish,brown,dry,soft,not cemented
36	38	sand,fine to coarse,clayey,light,brownish,brown,dry,loose,not cemented
38	42	gravel,coarse,dark,brownish,brown,dry,loose,not cemented
42	43	sand & gravel,fine to coarse,dark,brownish,brown,saturated,loose,not cemented
43	47	sand,coarse,dark,brownish,brown,saturated,firm,not cemented
47	52	sand & gravel,fine to medium,clayey,dark,brownish,brown,saturated,firm,not cemented
52	58	sand & gravel,fine to coarse,light,brownish,brown,saturated,hard,not cemented

Form	WWC5.2 - Water Well Record
Doc ID	1761824
Well Owner	Kaw Valley Drainage Dist.
Contractor	Griffin Dewatering, LLC

Lithology

From	To	Lithology Intervals
58	66	sand,coarse,dark,brownish,brown,saturated,loose,not cemented
66	71	sand & gravel,medium to coarse,light,brownish,brown,saturated,dense,not cemented
71	73.5	gravel,fine to coarse,dark,brownish,brown,saturated,dense,not cemented

Kansas R

Well W-3

Turner Diagonal Fwy

Turner Bridge

Well W-2

T11S R24E


Well W-1

HDHE Monitoring Well

641'-4 3/4"

1,078'-4 3/4"



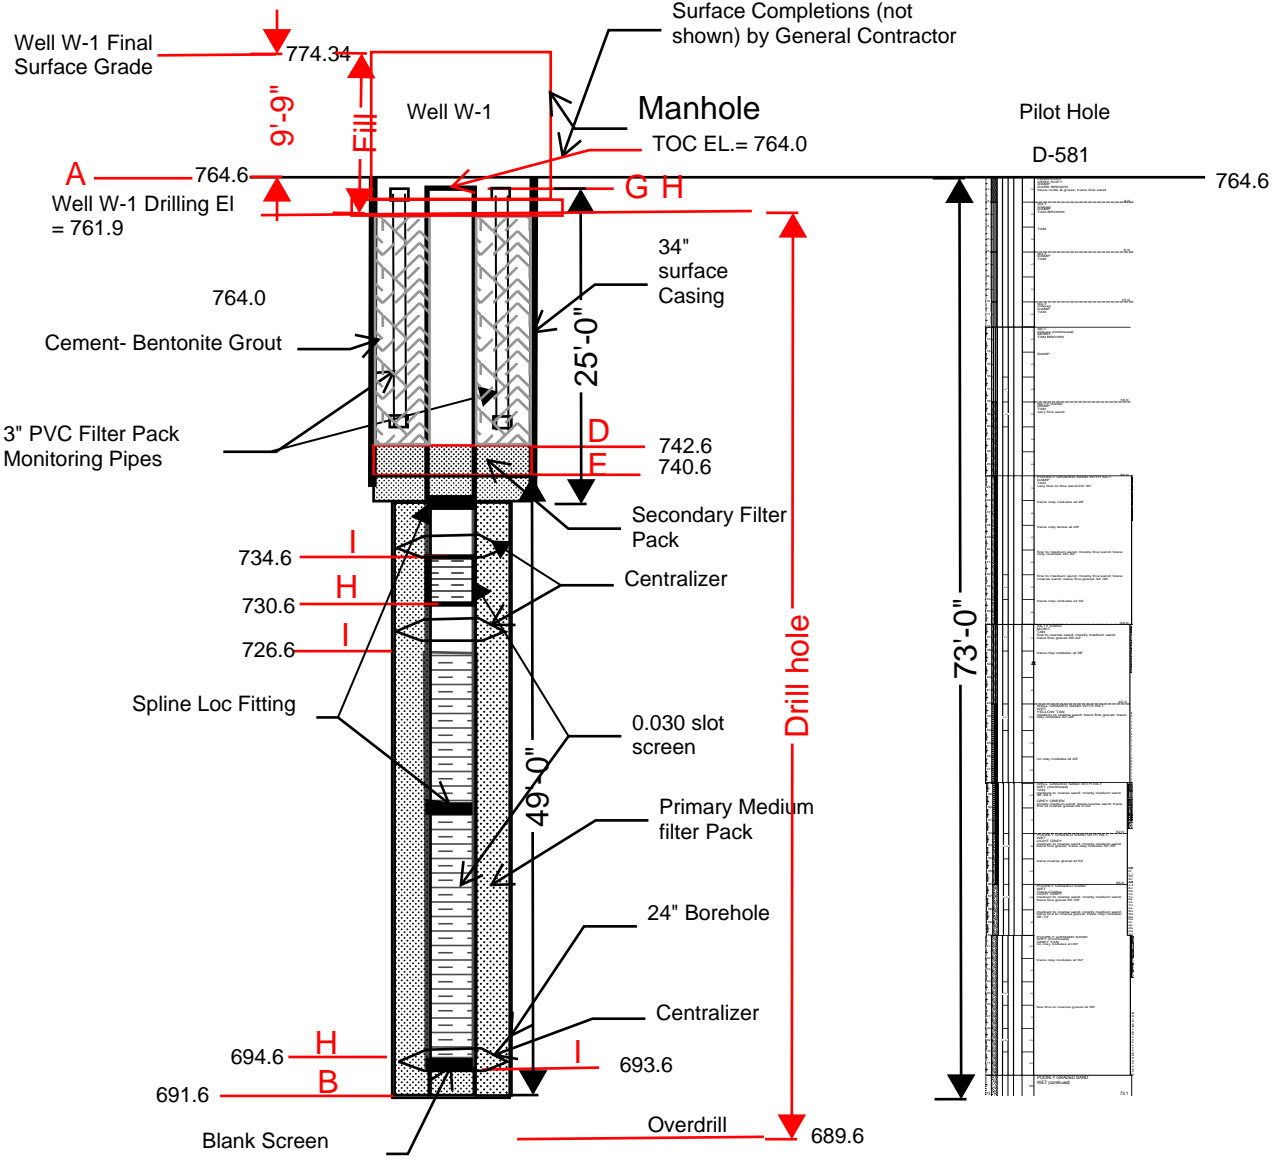

- NOTES:
1. ALL PIPE IS 12" - 304 STAINLESS STEEL
 2. CASING IS SCH. 40
 3. SCREEN SLOT IS AS SHOWN
 4. DRAWING IS N.T.S.

COUPLINGS WILL BE SPLINE LOC
ALL CONNECTIONS WELDED AT
FACTORY

<h2 style="margin: 0;">KC Relief Wells</h2> <h3 style="margin: 0;">ARG Unit</h3> <p style="margin: 0;">W-1</p>	
Drawn By: SAS	Date: 12/16/2022
Figure 1 Rev.1	

785

780

775

770

765

760

755

750

W-1
TOP ELEV = 774.34

(NE) FLOW = 763.60

EXISTING GRADE

1' 9 3/4"

Drilling EL. = 761.9

TOC EL = 764.0 at W-1

Bottom of MH Slab =
EL 762.18 at W-1

000

020

040

060

0

A1

PROFILE

HORIZONTAL SCALE: 1" = 20'